

COPYRIGHT © W.K. DICKSON & CO., INC., ALL RIGHTS RESERVED. REPRODUCTION OR USE OF THE CONTENTS OF THIS DRAWING WITHOUT THE EXPRESS WRITTEN PERMISSION OF W.K. DICKSON & CO., INC. IS PROHIBITED. ONLY COPIES FROM THE ORIGINAL OF THIS DOCUMENT, MARKED WITH AN ORIGINAL SIGNATURE AND SEAL, SHALL BE CONSIDED TO BE VALID WILL COPIES.

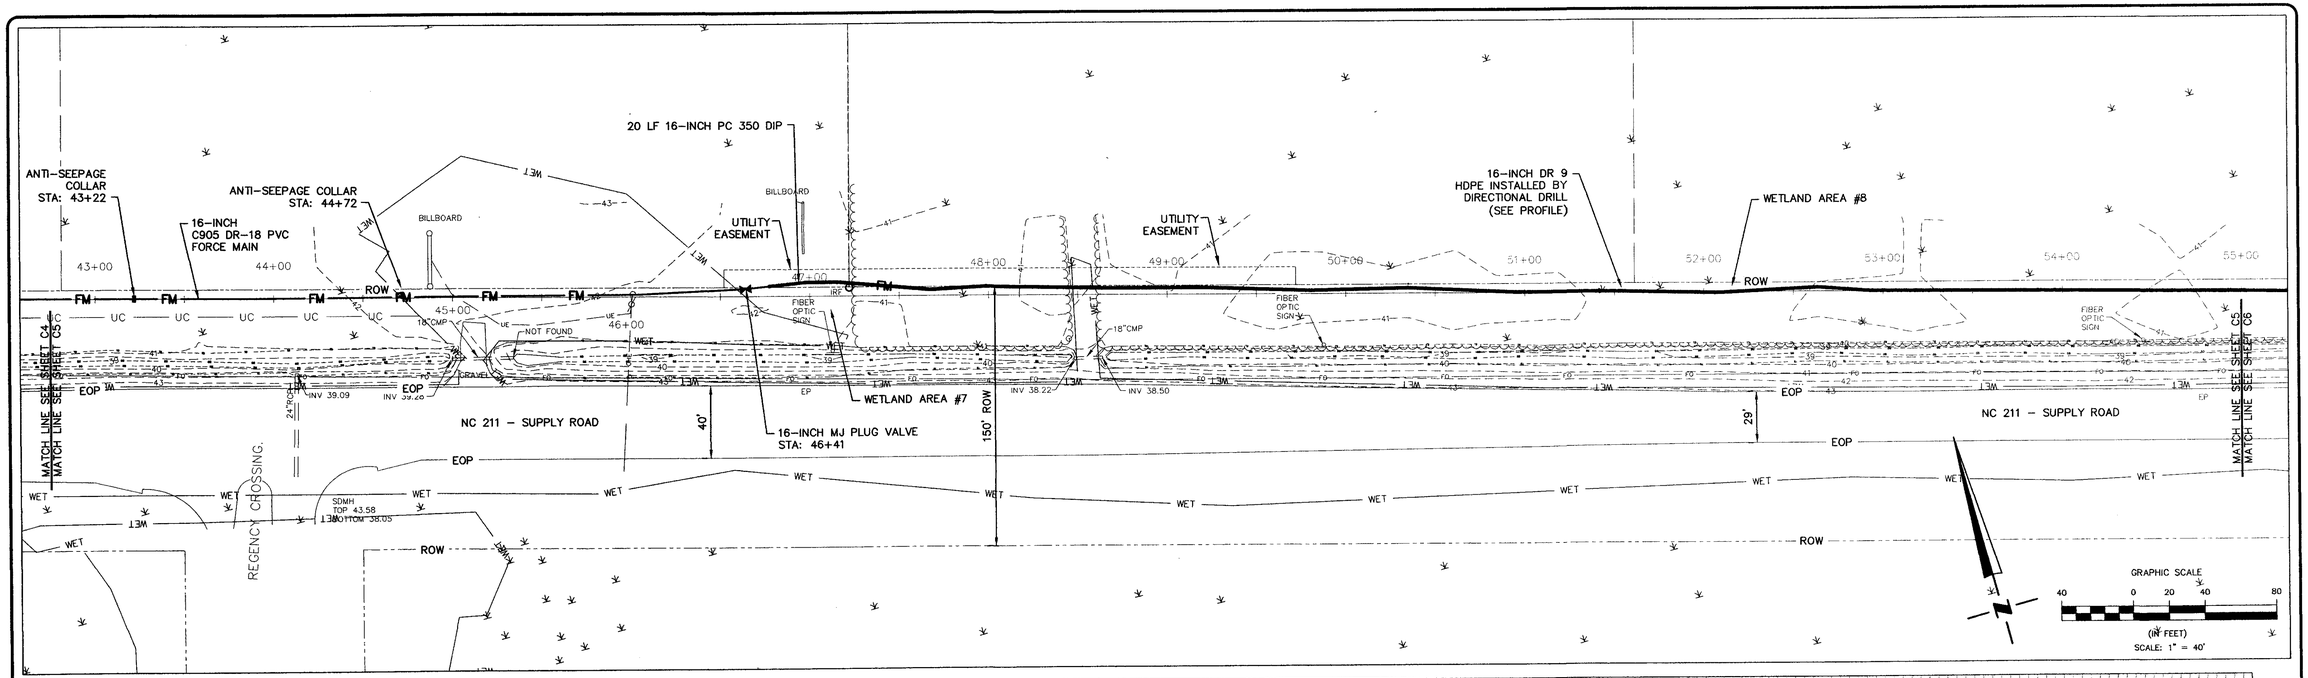

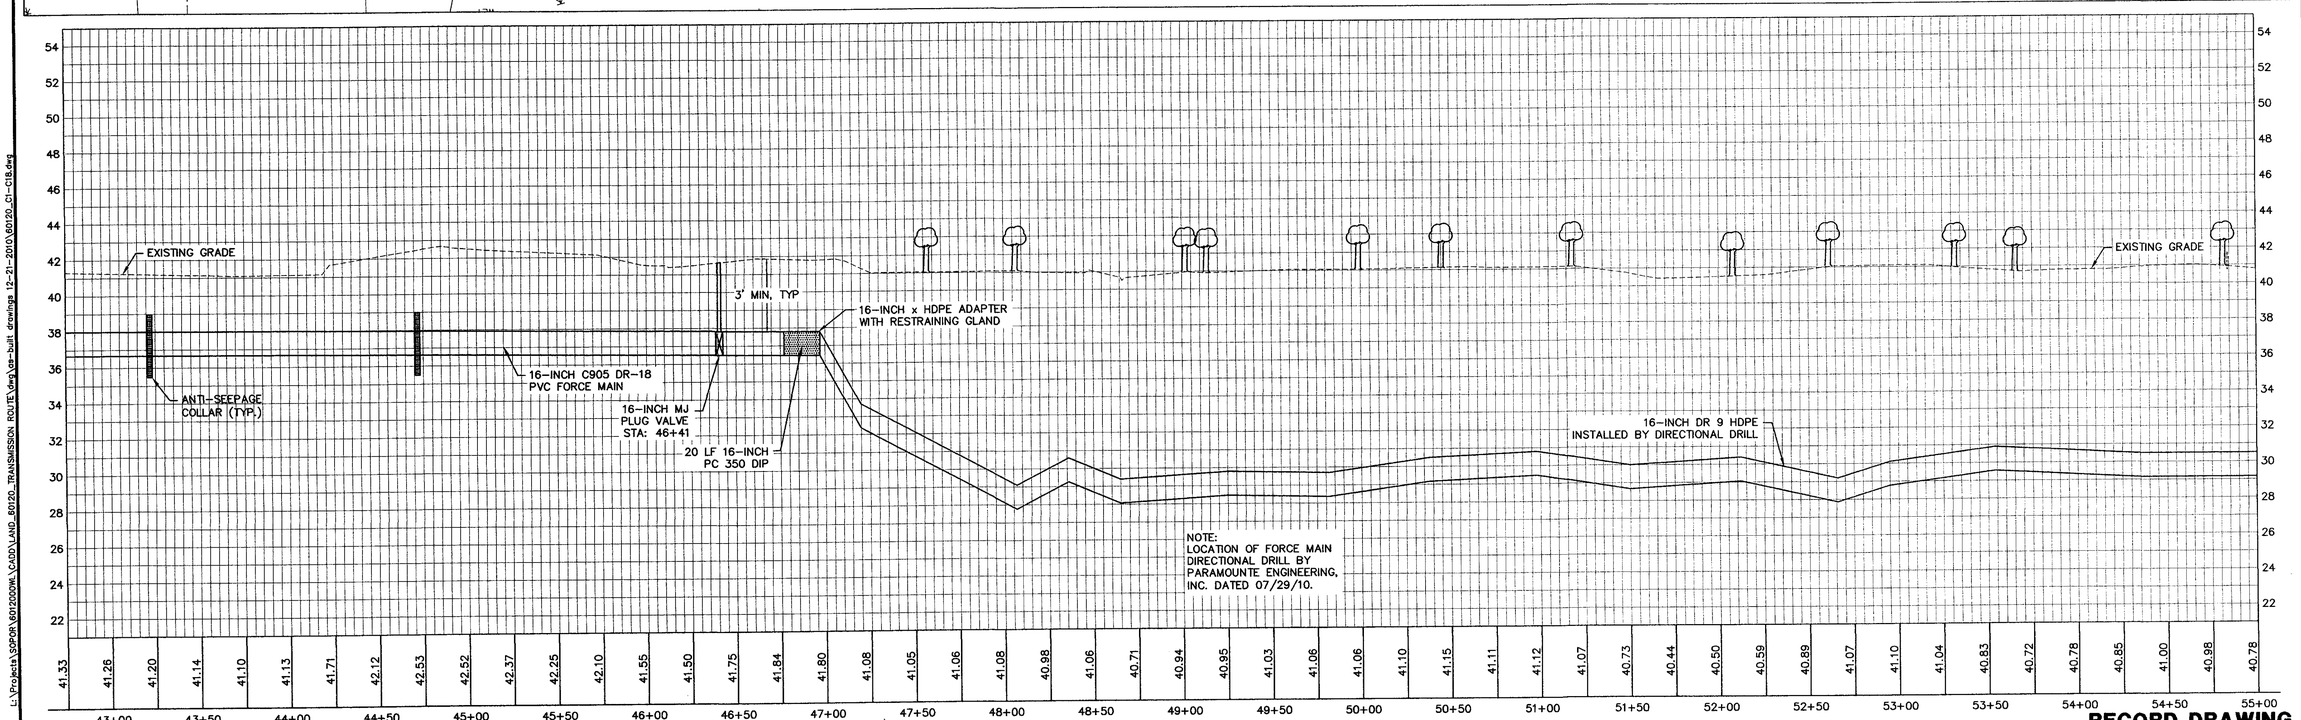

L:\Projects\SOPOR\60120000W\CADD\LAND_60120_TRANSMISSION ROUTE\dwg\as-built drawings 12-21-2010\60120_C1-C16.dwg

REV. NO.	DESCRIPTION	DATE
	REVISIONS	

PROJECT MANAGER: TCH	DRAWING SCALE: 1" = 40'
DRAWN BY: VAR	PROJECT DATE: FEB. 2007
APPROVED BY: TCH	PROJECT NUMBER: 60120.00.WL
FILE NAME:	PLOT DATE: 1/20/2011

WK DICKSON
community infrastructure consultants
909 MARKET STREET
WILMINGTON, NC 28401
(910) 762-4200
Office Locations: North Carolina, South Carolina, Georgia
NC LICENSE NO. F-0374

RELEASED FOR	DATE
APPROVALS	
BIDDING	
CONSTRUCTION	
RECORD DWG.	

NORTH CAROLINA PROFESSIONAL SEAL 024984 ENGINEER T. CARTER HUBBARD

CITY OF SOUTHPORT
TRANSMISSION FACILITIES

HWY 211 FORCE MAIN
STA: 42+75 TO STA: 55+00

C5