COPYRIGHT © W.K. DICKSON & CO., INC., ALL RIGHTS RESERVED. REPRODUCTION OR USE OF THE CONTENTS OF THIS DOCUMENT IN ANY FORM WITHOUT THE EXPRESS WRITTEN CONSENT OF W.K. DICKSON & CO., INC. IS PROHIBITED. ONLY COPIES FROM THE ORIGINAL OF THIS DOCUMENT, MARKED WITH AN ORIGINAL SIGNATURE AND SEAL, SHALL BE CONSIDERED TO BE VALID, TRUE COPIES.

ANTI-SEEPAGE COLLAR STA: 67+59

ANTI-SEEPAGE COLLAR STA: 69+09

ANTI-SEEPAGE COLLAR STA: 70+59

ANTI-SEEPAGE COLLAR STA: 72+09

ANTI-SEEPAGE COLLAR STA: 73+59

ANTI-SEEPAGE COLLAR STA: 78+46

SOIL BORING B-3

67+00 68+00 69+00 70+00 71+00 72+00 72+50 73+00 74+00 75+00 76+00 77+00 78+00 79+

ROW

FM

UC

WET

EOP

EP

MATCH LINE SEE SHEET C6

MATCH LINE SEE SHEET C7

NC 211 – SUPPLY ROAD

150' R.O.W

±28'

N.C. HWY. 211 – SOUTHPORT-SUPPLY ROAD

150' R/W

FIBER OPTIC U/G SIGN

BILLBOARD

INV 36.16

INV 36.18

24" CMP

DITCH

SIGN

R/W

WOODS

TREE

GRAVES

FOUNTAIN

CAPE FEAR MEMORIAL PARK CEMETERY

42" RCP

INV= 31.98


INV= 37.59

GRAPHIC SCALE

40 0 20 40 80

(IN FEET)

SCALE: 1" = 40'

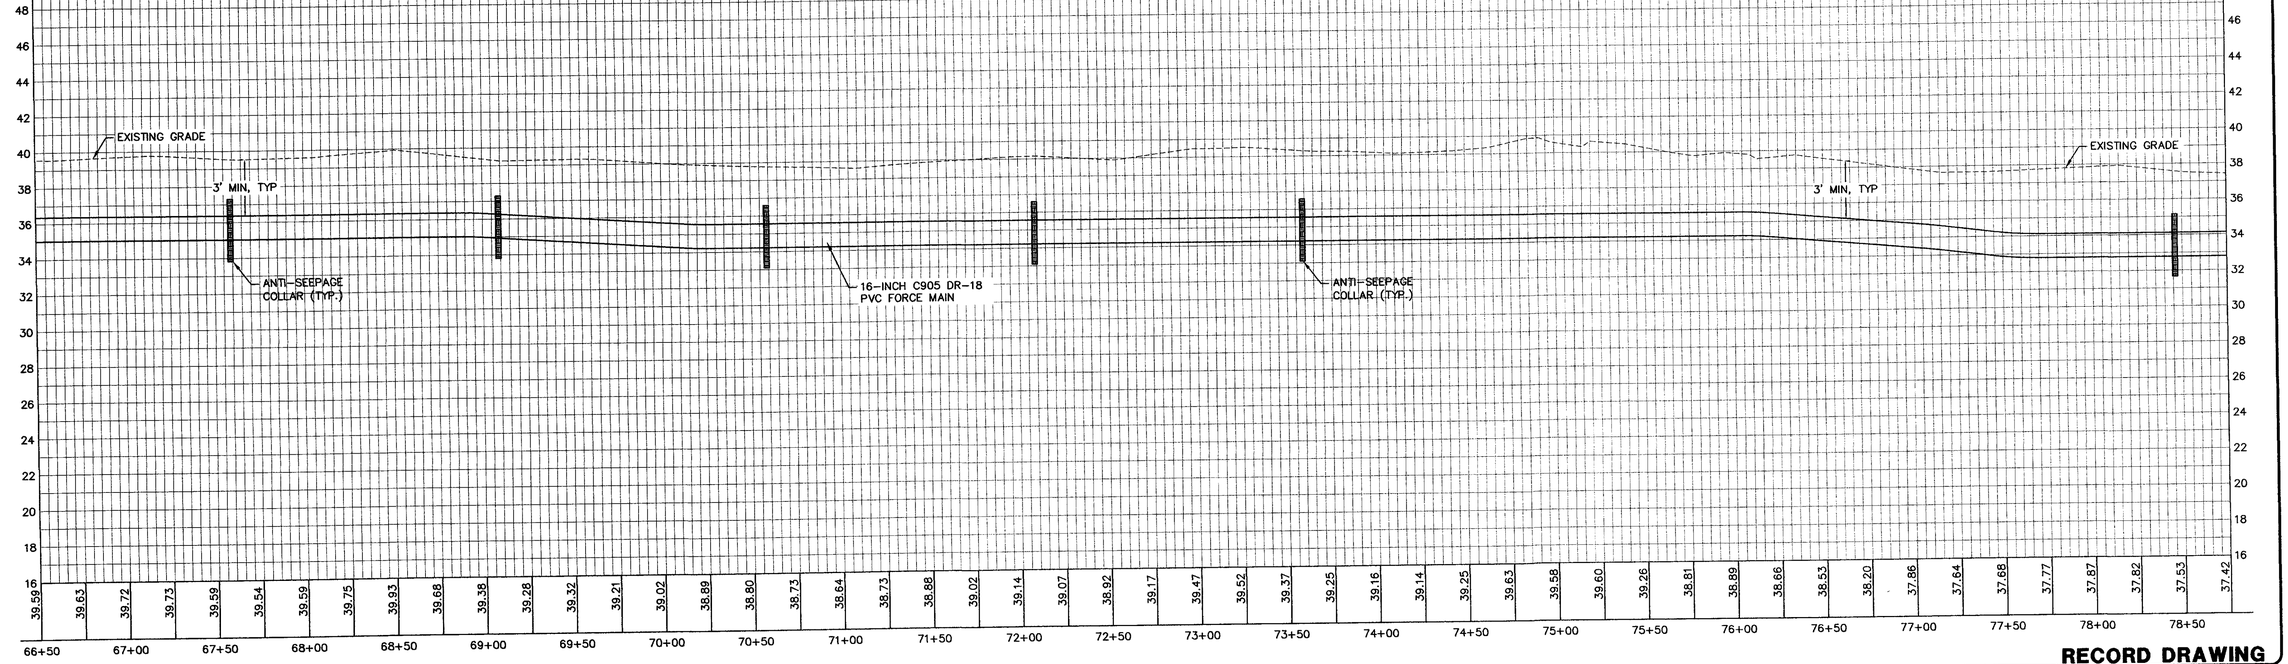

RECORD DRAWING

L:\Projects\SOPOR\60120OWL\CADD\LAND_60120_TRANSMISSION ROUTE\dwg\as-built drawings 12-21-2010\60120_C1-C18.dwg

REV. NO.	DESCRIPTION	DATE
	REVISIONS	

PROJECT MANAGER	TCH
DRAWN BY	VAR
APPROVED BY	TCH
FILE NAME	
DRAWING SCALE	1" = 40'
PROJECT DATE	FEB. 2007
PROJECT NUMBER	60120.00.WL
PLOT DATE	1/20/2011

W K DICKSON
community infrastructure consultants
909 MARKET STREET
WILMINGTON, NC 28401
(910) 762-4200
Office Locations: North Carolina
South Carolina
Georgia
NC LICENSE NO. F-0374

RELEASED FOR	DATE
APPROVALS	
BIDDING	
CONSTRUCTION	
RECORD DWG.	

NORTH CAROLINA PROFESSIONAL SEAL 024984 ENGINEER T. CARTER HUBBARD

CITY OF SOUTHPORT
TRANSMISSION FACILITIES

HWY 211 FORCE MAIN
STA: 66+50 TO STA: 78+75

C7