
COPYRIGHT © W.K. DICKSON & CO., INC. ALL RIGHTS RESERVED. REPRODUCTION OR USE OF THE CONTENTS OF THIS DOCUMENT, IN WHOLE OR IN PART, OTHER THAN AS DIRECTLY RELATED TO THIS PROJECT, WITHOUT WRITTEN CONSENT OF W.K. DICKSON & CO., INC. IS PROHIBITED. ANY REPRODUCTIONS OF THIS DOCUMENT, IF MARKED WITH AN ORIGINAL SEAL, SHALL HAVE BEEN CONSENTED TO BE VALID, TRUE COPIES.

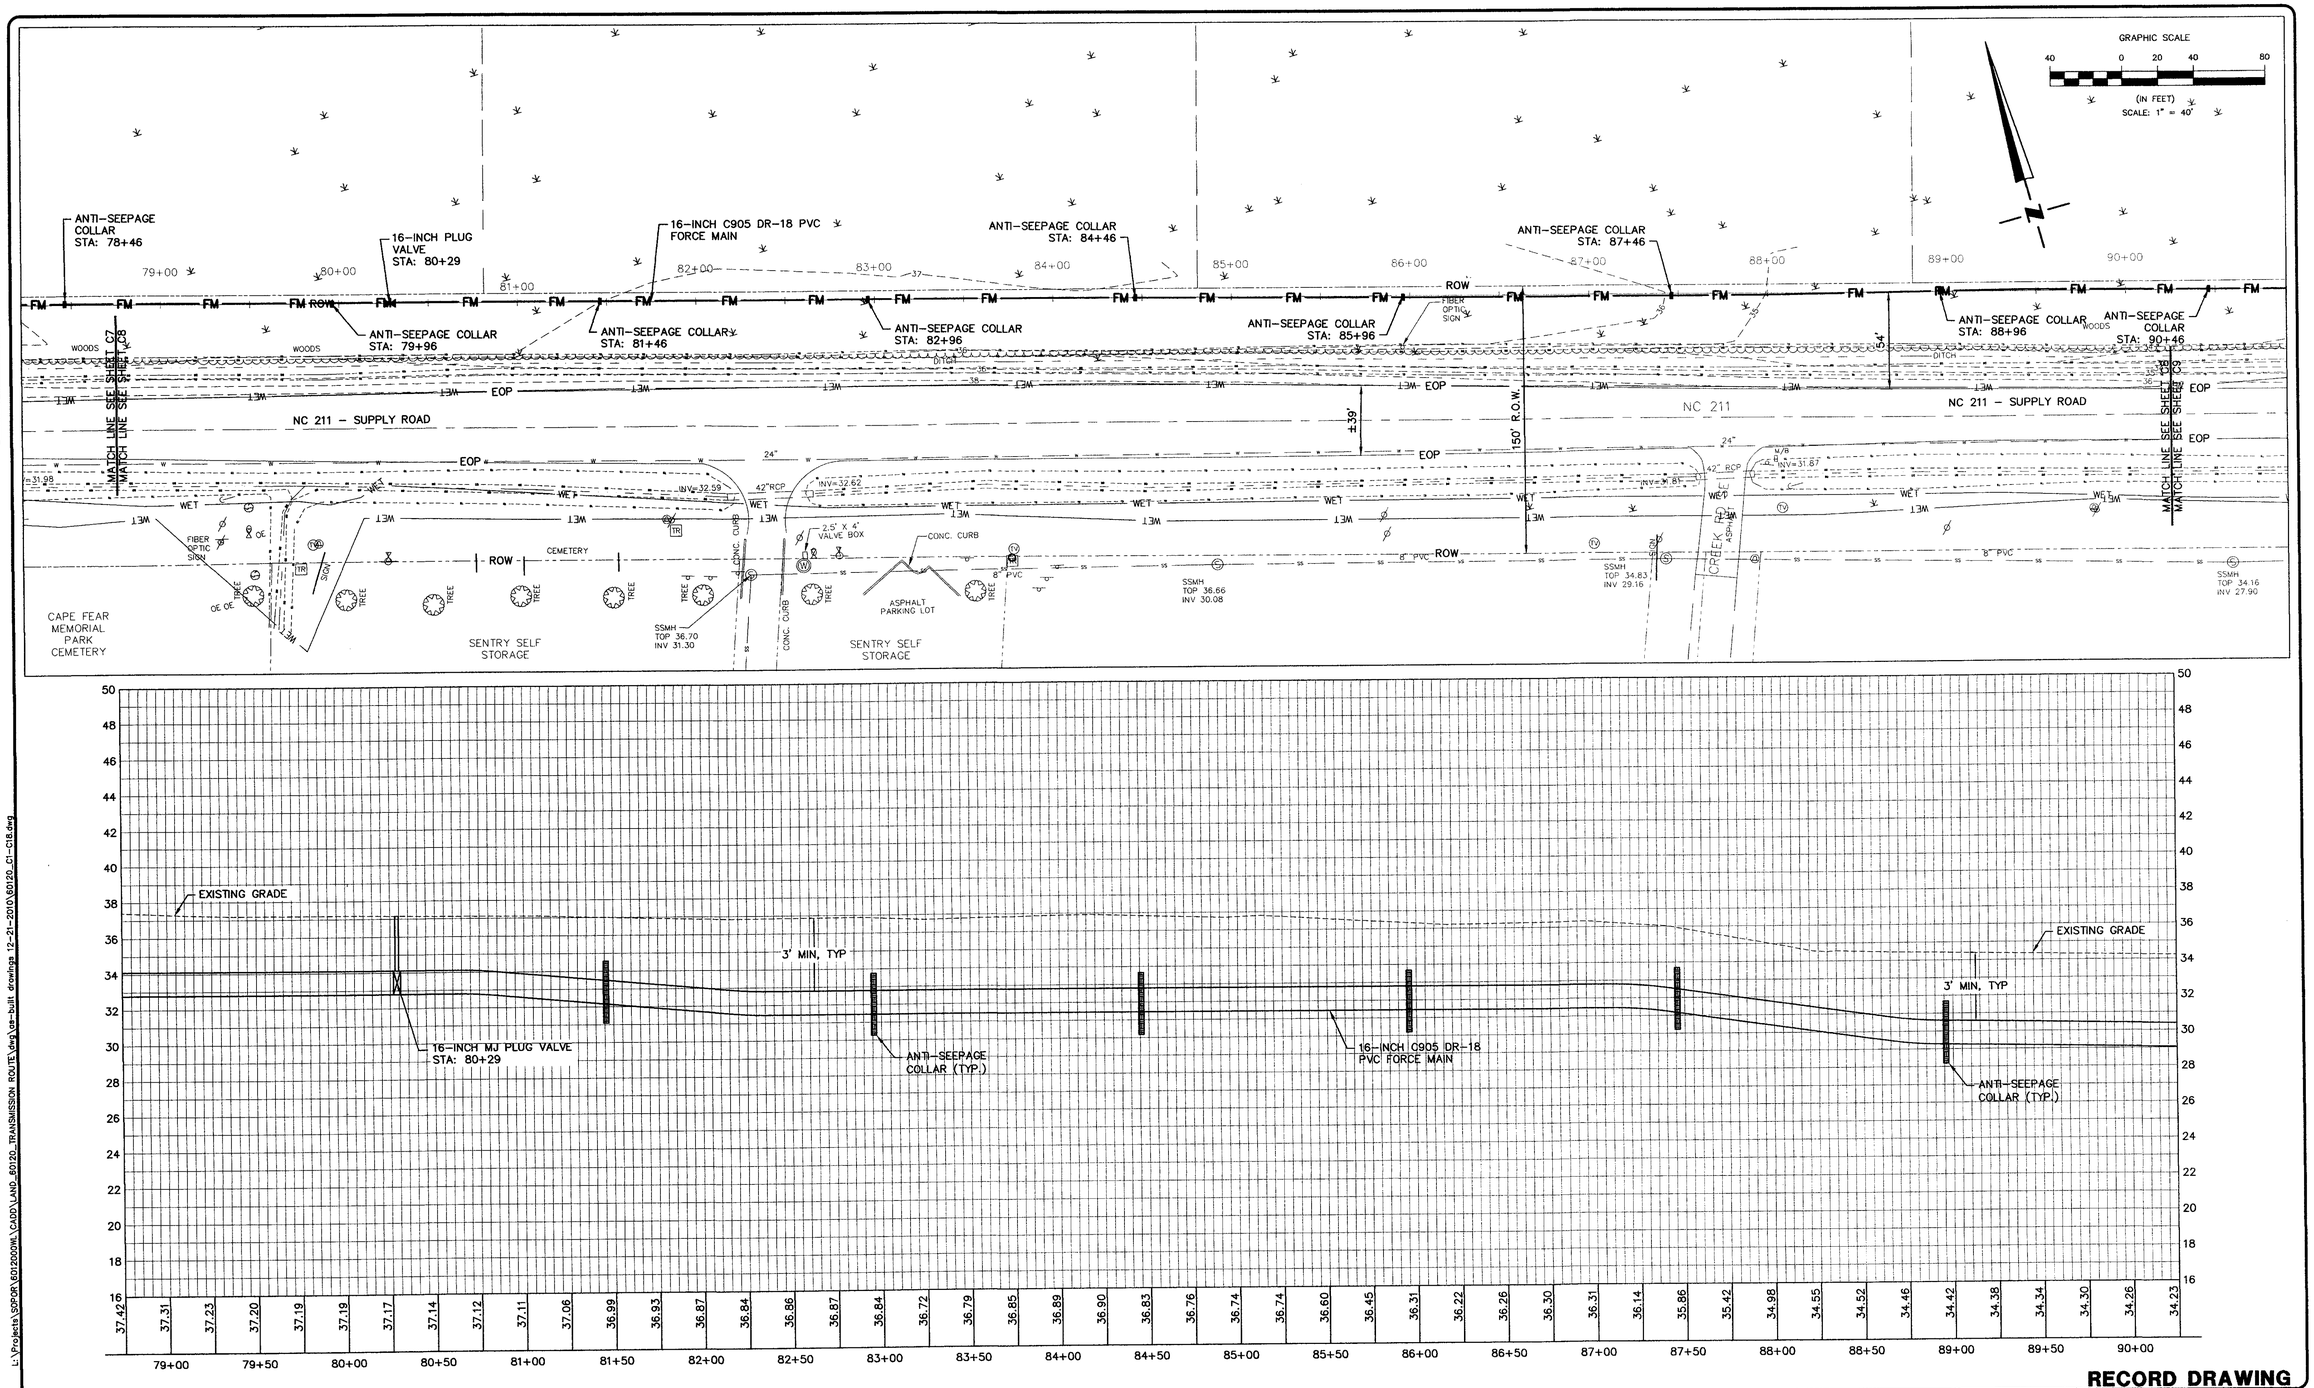

RECORD DRAWING

L:\Projects\SPGR\601200DWL\CADD\LAND_60120_TRANSMISSION ROUTE\dwg\as-built drawings 12-21-2010\60120_C1-C18.dwg

REV. NO.	DESCRIPTION	DATE
	REVISIONS	

PROJECT MANAGER	TCH
DRAWN BY	VAR
APPROVED BY	TCH
FILE NAME	
DRAWING SCALE	1" = 40'
PROJECT DATE	FEB. 2007
PROJECT NUMBER	60120.00.WL
PLOT DATE	1/20/2011

WK DICKSON
community infrastructure consultants
909 MARKET STREET
WILMINGTON, NC 28401
(910) 762-4200
Office Locations: North Carolina
South Carolina
Georgia
NC LICENSE NO. F-0374

RELEASED FOR	DATE
APPROVALS	
BIDDING	
CONSTRUCTION	
RECORD DWG.	

NORTH CAROLINA PROFESSIONAL SEAL 024984 ENGINEER T. CARTER HUBBARD
1-25-2011

CITY OF SOUTHPORT
TRANSMISSION FACILITIES

HWY 211 FORCE MAIN
STA: 78+75 TO STA: 90+25

C8