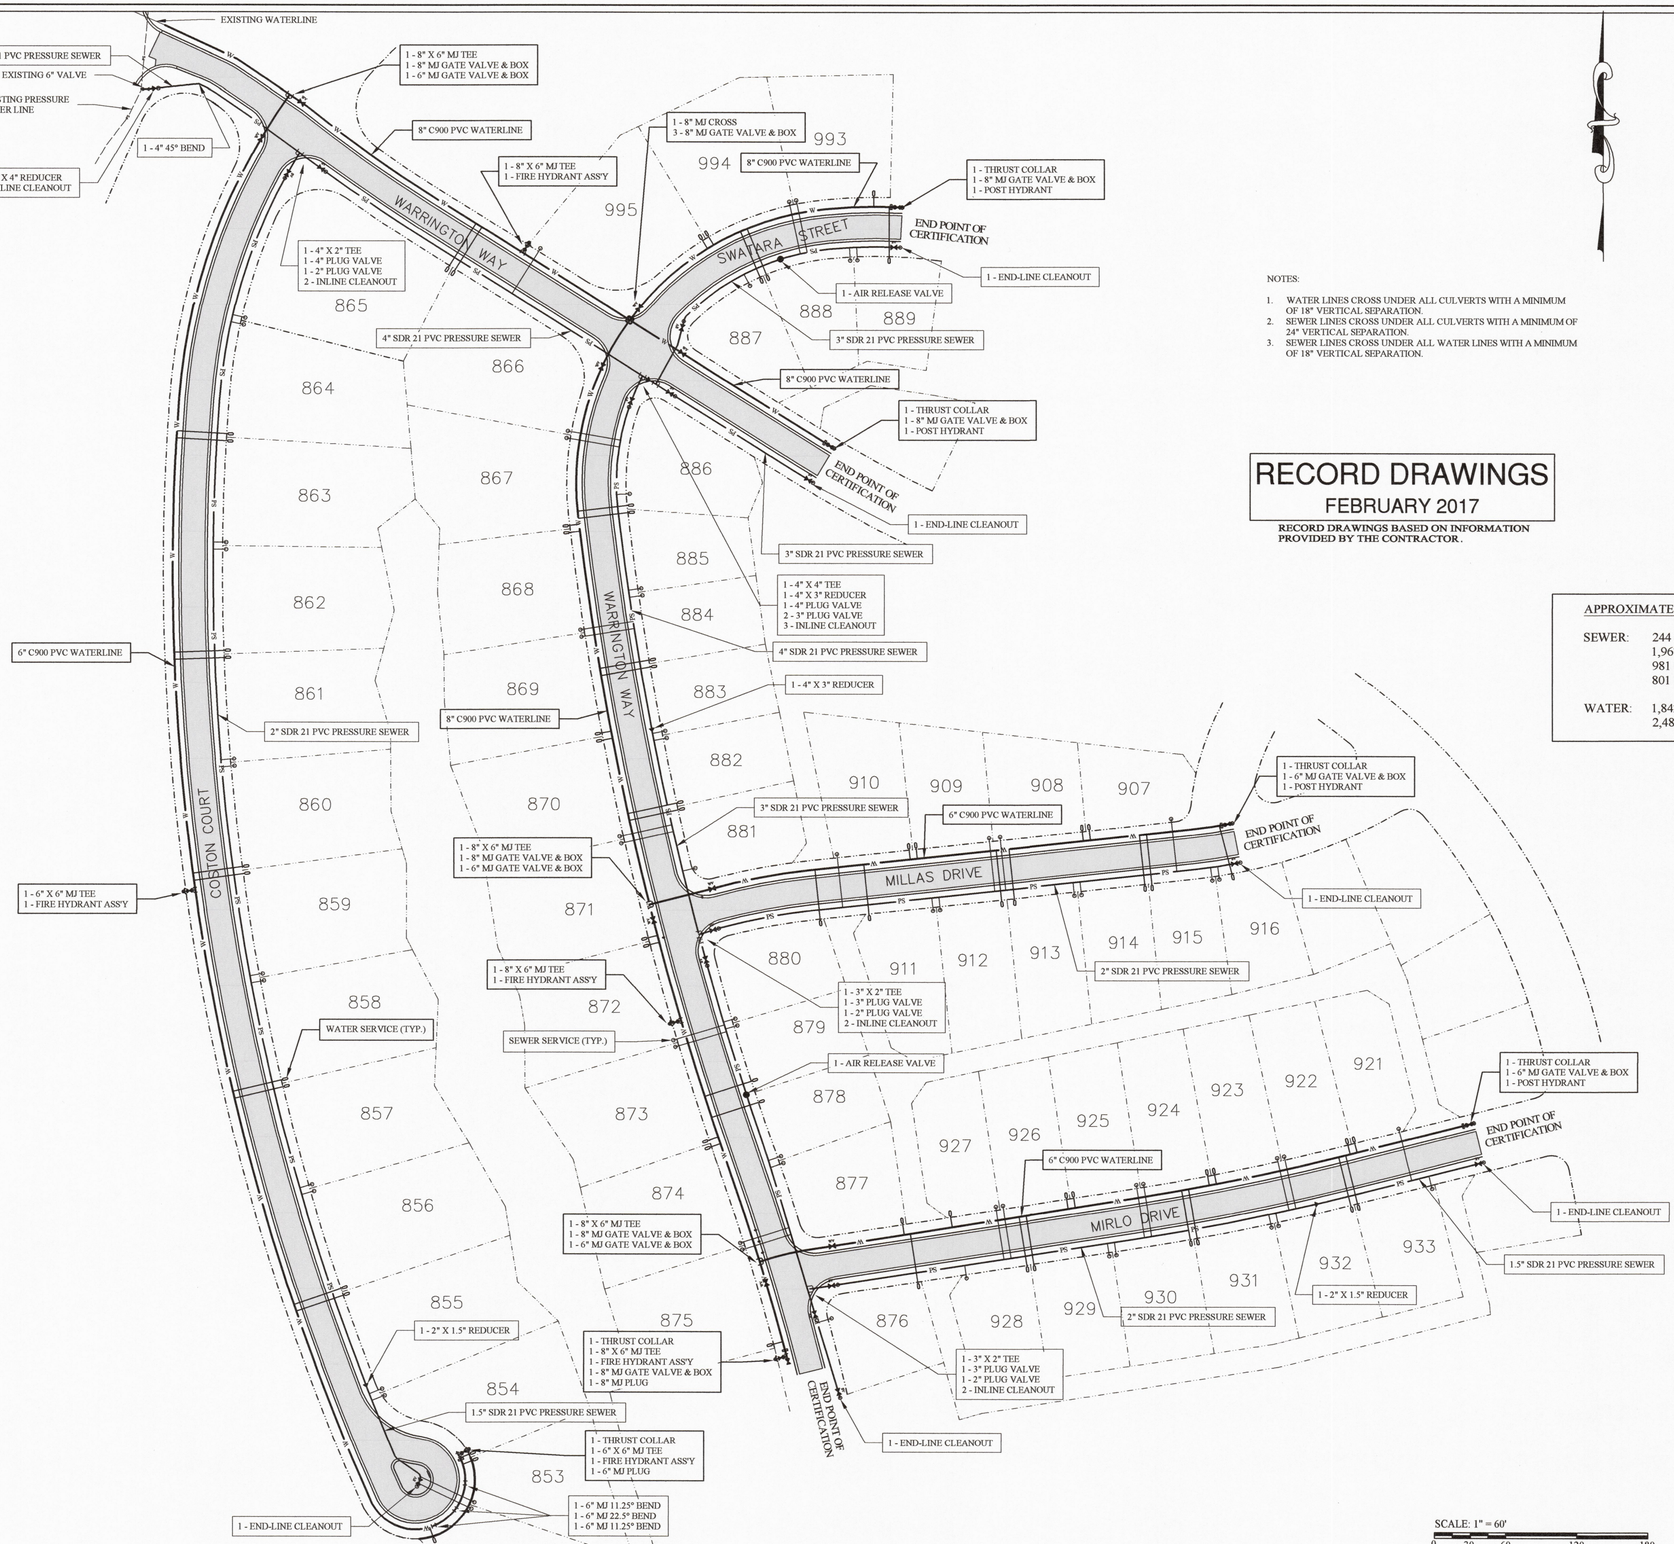


NOTES:

1. WATER LINES CROSS UNDER ALL CULVERTS WITH A MINIMUM OF 18" VERTICAL SEPARATION.
2. SEWER LINES CROSS UNDER ALL CULVERTS WITH A MINIMUM OF 24" VERTICAL SEPARATION.
3. SEWER LINES CROSS UNDER ALL WATER LINES WITH A MINIMUM OF 18" VERTICAL SEPARATION.

RECORD DRAWINGS
FEBRUARY 2017

RECORD DRAWINGS BASED ON INFORMATION PROVIDED BY THE CONTRACTOR.

APPROXIMATE INSTALLED PIPE QUANTITIES

SEWER:	244 LF - 1.5"
	1,967 LF - 2"
	981 LF - 3"
	801 LF - 4"
WATER:	1,842 LF - 8"
	2,484 LF - 6"

Revisions

East Coast Engineering & Surveying, P.C.
ENGINEERS • PLANNERS • SURVEYORS
4918 Main Street
Post Office Box 2469
Shallotte, North Carolina 28459
Phone: 910.754.8029
Fax: 910.754.8049
Firm License Number C-3014

WATER AND SEWER RECORD DRAWINGS
SEAWATCH, PHASE 7A
Lots 852-889, 907-916, 921-933 & 993-995
BRUNSWICK COUNTY, NORTH CAROLINA

Date: 02-21-2017
Scale: 1" = 60'
Drawn By: MGB
Checked By: REL/ACL

NORTH CAROLINA PROFESSIONAL SEAL 012564 ENGINEER ROBERT E. TUCKER

1 OF 1

© 2017 This drawing shall not be reproduced in whole or in part without written permission of East Coast Engineering & Surveying , P.C.

ECES PROJECT NO. 3300.06