


COUNTY OF BRUNSWICK

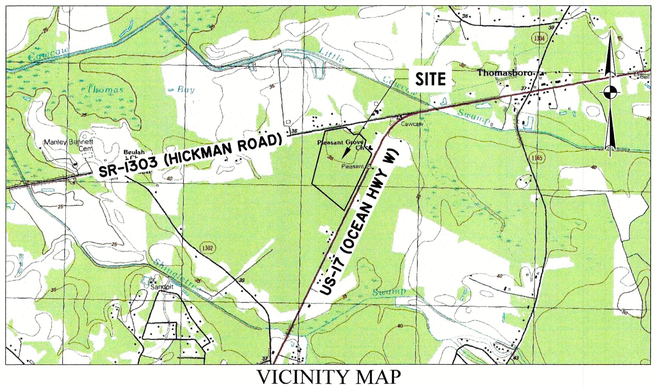

VICINITY MAP
(Not to Scale)

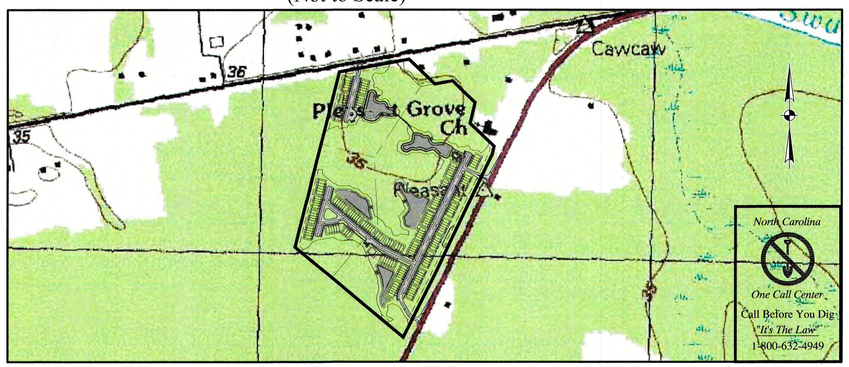

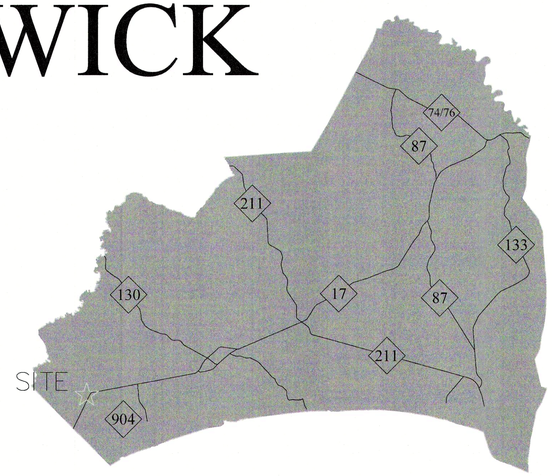

PARCEL ID #: 22500035

CALABASH POINTE
PHASE 3
WATER & SEWER
RECORD DRAWINGS

OWNER

LENNAR CAROLINAS, LLC
1359 21ST AVENUE NORTH
SUITE 105
MYRTLE BEACH,
SOUTH CAROLINA
29577

ENGINEER / SURVEYOR

THOMAS & HUTTON

INDEX OF SHEETS

Sheet List Table

Sheet Number	Sheet Title
C0	Brunswick County Cover Sheet
SH1	WATER
SH2	SEWER
SH3	SEWER PROFILES

NUMBER	DATE	BY	REVISION DESCRIPTION

APPROVAL STATUS	DATE	BY	DEPARTMENT
☐ YES ☐ NO ☐ N/A			PLANNING
☐ YES ☐ NO ☐ N/A			ENGINEERING
☐ YES ☐ NO ☐ N/A			PUBLIC UTILITIES

"ENGINEER'S CERTIFICATION OF COMPLIANCE WITH BRUNSWICK COUNTY SPECIFICATIONS AND DETAILS"
I hereby certify that the plans, details, and associated project specifications comply with the latest version, as of this date, of Brunswick County's Standard Specifications and Standard Details per standard engineering practice. Furthermore, I confirm my understanding that reviews and approvals by Brunswick County personnel do not imply that Brunswick County personnel have reviewed and are in agreement with every portion of the plans and specifications that I have submitted. I understand that Brunswick County reviews and approvals are meant to ensure that the overall plans are in general compliance with County objectives. I understand that it is my full responsibility to ensure that plans and specifications are in full compliance with applicable County, State, Federal, and other municipal requirements. Additionally, I understand that the County will not assume operation, maintenance, or ownership of constructed facilities that do not meet County requirements and the County may refuse to issue permits at facilities that the County deems are non-compliant with County Specifications. I also confirm my understanding that County Inspections are for the sole use of the County and I certify that I will not use, or direct others to use, County inspections for State compliance purposes or any other purpose."

DATE: 8/4/26

SUBMITTAL: FINAL

PROJECT NAME: Calabash Pointe
LOCATION: Brunswick County, North Carolina
OWNER: Lennar Carolinas, LLC.
DESIGNER: Thomas & Hutton

NORTH CAROLINA PROFESSIONAL SEAL 053169 ENGINEER NATHAN T. POLAND

THOMAS & HUTTON ENGINEERING CO. No. F-0871 CERTIFICATE OF AUTHORIZATION

TECH: DLF

DES: WPH

CHK: NTP

PROJECT NO. 31725.0000

SHEET NO. C0