
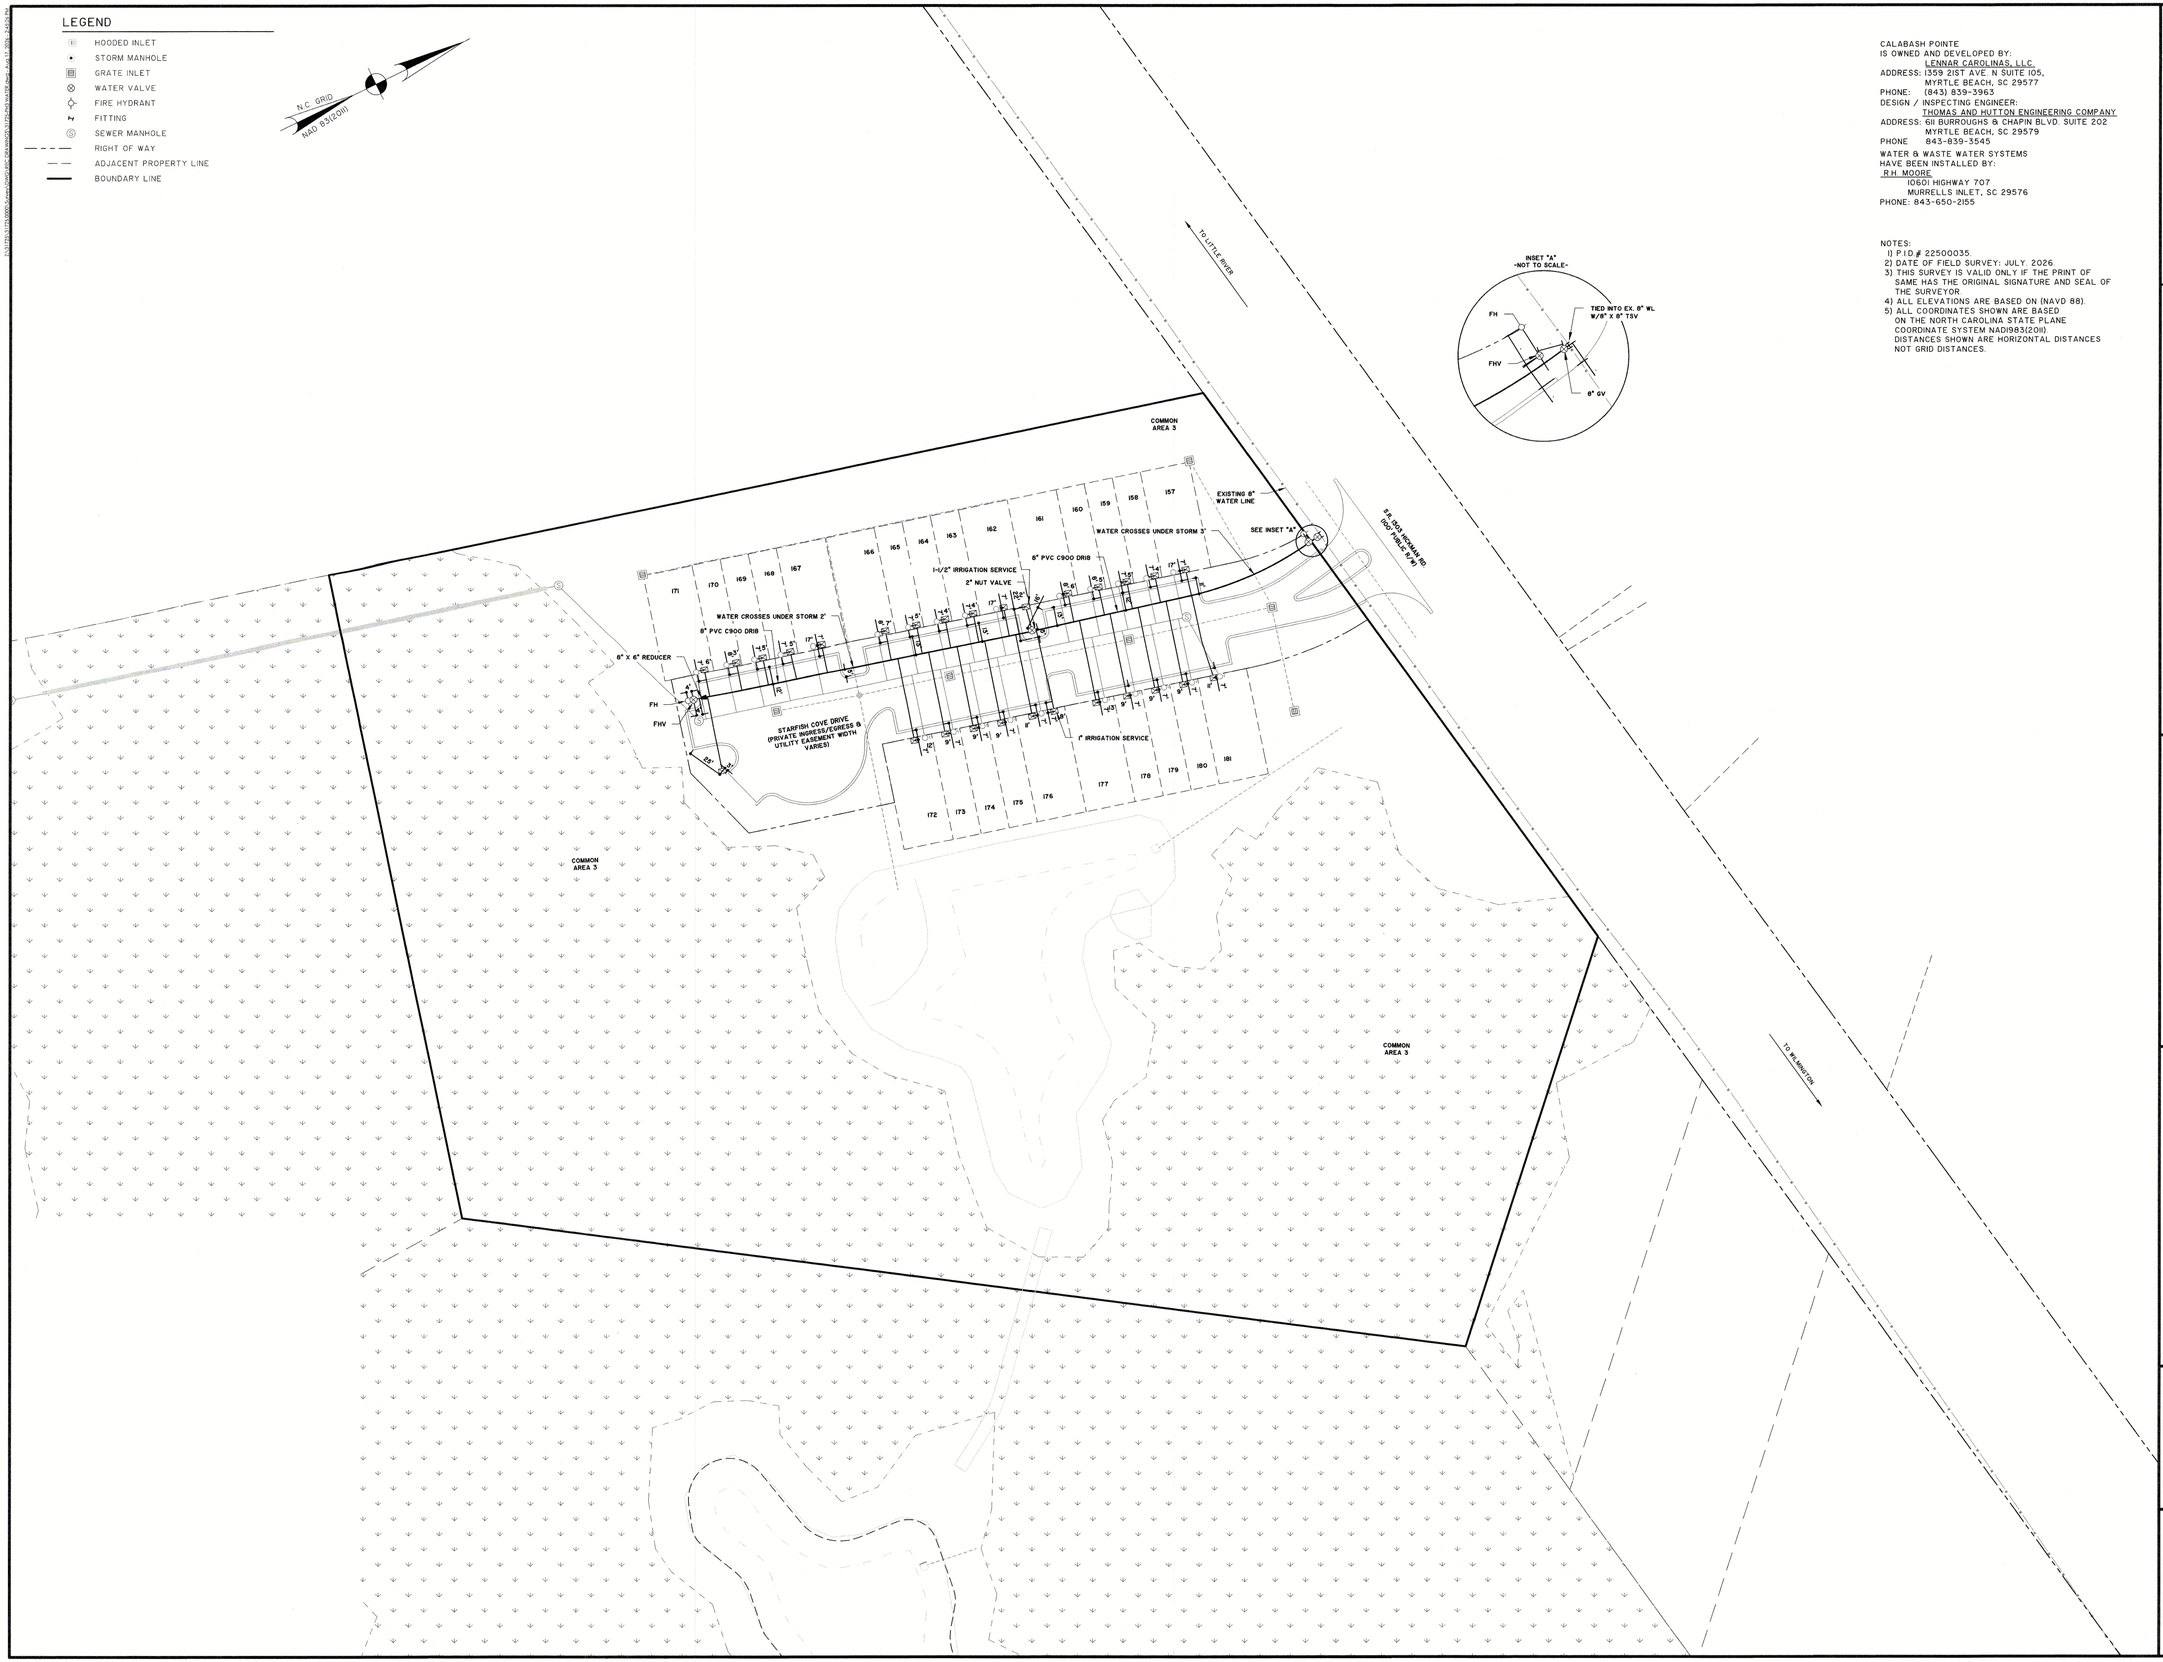



CALABASH POINTE
IS OWNED AND DEVELOPED BY:
LENNAR CAROLINAS, LLC
ADDRESS: 1359 21ST AVE. N SUITE 105,
MYRTLE BEACH, SC 29577
PHONE: (843) 839-3963
DESIGN / INSPECTING ENGINEER:
THOMAS AND HUTTON ENGINEERING COMPANY
ADDRESS: 611 BURROUGHS & CHAPIN BLVD. SUITE 202
MYRTLE BEACH, SC 29579
PHONE 843-839-3545
WATER & WASTE WATER SYSTEMS
HAVE BEEN INSTALLED BY:
R.H. MOORE
10601 HIGHWAY 707
MURRELLS INLET, SC 29576
PHONE: 843-650-2155

NOTES:
1) P.I.D.# 22500035.
2) DATE OF FIELD SURVEY: JULY, 2026.
3) THIS SURVEY IS VALID ONLY IF THE PRINT OF SAME HAS THE ORIGINAL SIGNATURE AND SEAL OF THE SURVEYOR.
4) ALL ELEVATIONS ARE BASED ON (NAVD 88).
5) ALL COORDINATES SHOWN ARE BASED ON THE NORTH CAROLINA STATE PLANE COORDINATE SYSTEM NAD(2011). DISTANCES SHOWN ARE HORIZONTAL DISTANCES NOT GRID DISTANCES.

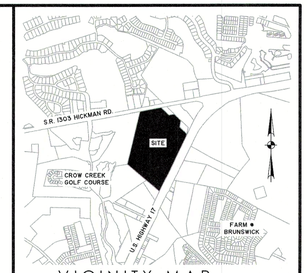


VICINITY MAP not to scale

This document and all reproducible copies of this document are the property of Thomas & Hutton. Reproduction of this document is not permitted without written consent of Thomas & Hutton unless this document becomes a matter of public record. ALTERATIONS TO THIS DOCUMENT ARE NOT PERMITTED.

NORTH CAROLINA THOMAS & HUTTON ENGINEERING CO No. F-0871 CERTIFICATE OF AUTHORIZATION

NORTH CAROLINA PROFESSIONAL SEAL 53169 ENGINEER NATHAN T. POUND 8/4/26

THE FACILITIES HAVE BEEN CONSTRUCTED AS SHOWN ON THE "RECORD DRAWING" PLAN, AND THE FACILITIES MEET THE APPROVED WATER AND WASTEWATER PLAN AND SPECIFICATIONS OR ACHIEVE THE FUNCTION FOR WHICH THEY WERE DESIGNED.

NORTH CAROLINA THOMAS & HUTTON ENGINEERING CO No. F-0871 CERTIFICATE OF AUTHORIZATION

NORTH CAROLINA PROFESSIONAL SEAL L-5564 LAND SURVEYOR MATTHEW D. SVEJKOVSKY

I, MATTHEW D. SVEJKOVSKY, CERTIFY THAT THIS WATER & WASTE WATER SYSTEM RECORD DRAWING IS DRAWN UNDER MY DIRECT SUPERVISION, AND BASED ON A FIELD SURVEY BY THOMAS AND HUTTON; THAT THE FIELDWORK WAS COMPLETED ON 27TH DAY OF JULY 2026; THAT THE BOUNDARY LINES SHOWN ARE COMPILED FROM PREVIOUSLY RECORDED MAPS. WITNESS MY HAND AND SEAL THIS 4TH DAY OF AUGUST 2026.

8/4/26
MATTHEW D. SVEJKOVSKY N. PROFESSIONAL LAND SURVEYOR
LICENSE NO. L-5564

WATER & SEWER
RECORD DRAWING
OF

# CALABASH POINTE PHASE 3

SHALLOTTE TOWNSHIP
BRUNSWICK COUNTY, NORTH CAROLINA

prepared for
LENNAR CAROLINAS, LLC

| No. | Revision | By | Date |
|---|---|---|---|

THOMAS & HUTTON
611 Burroughs & Chapin Blvd. • Suite 202
Myrtle Beach, SC 29577 • 843.839-3545
www.thomasandhutton.com

50 0 50 100
1 INCH = 50 FEET

| plat | drawn | reviewed | field | crew |
|---|---|---|---|---|
| 8/4/26 | DLF | JC/DOB | 7/26 | HR |

job 31725-PH3-WATER SHEET 1 OF 3