Z:\31725\31725.0000\Survey\DWG\REC DRAWINGS\31725.0000 PH3 Sewer Pros.dwg - Aug 17, 2026 - 12:26:45 PM

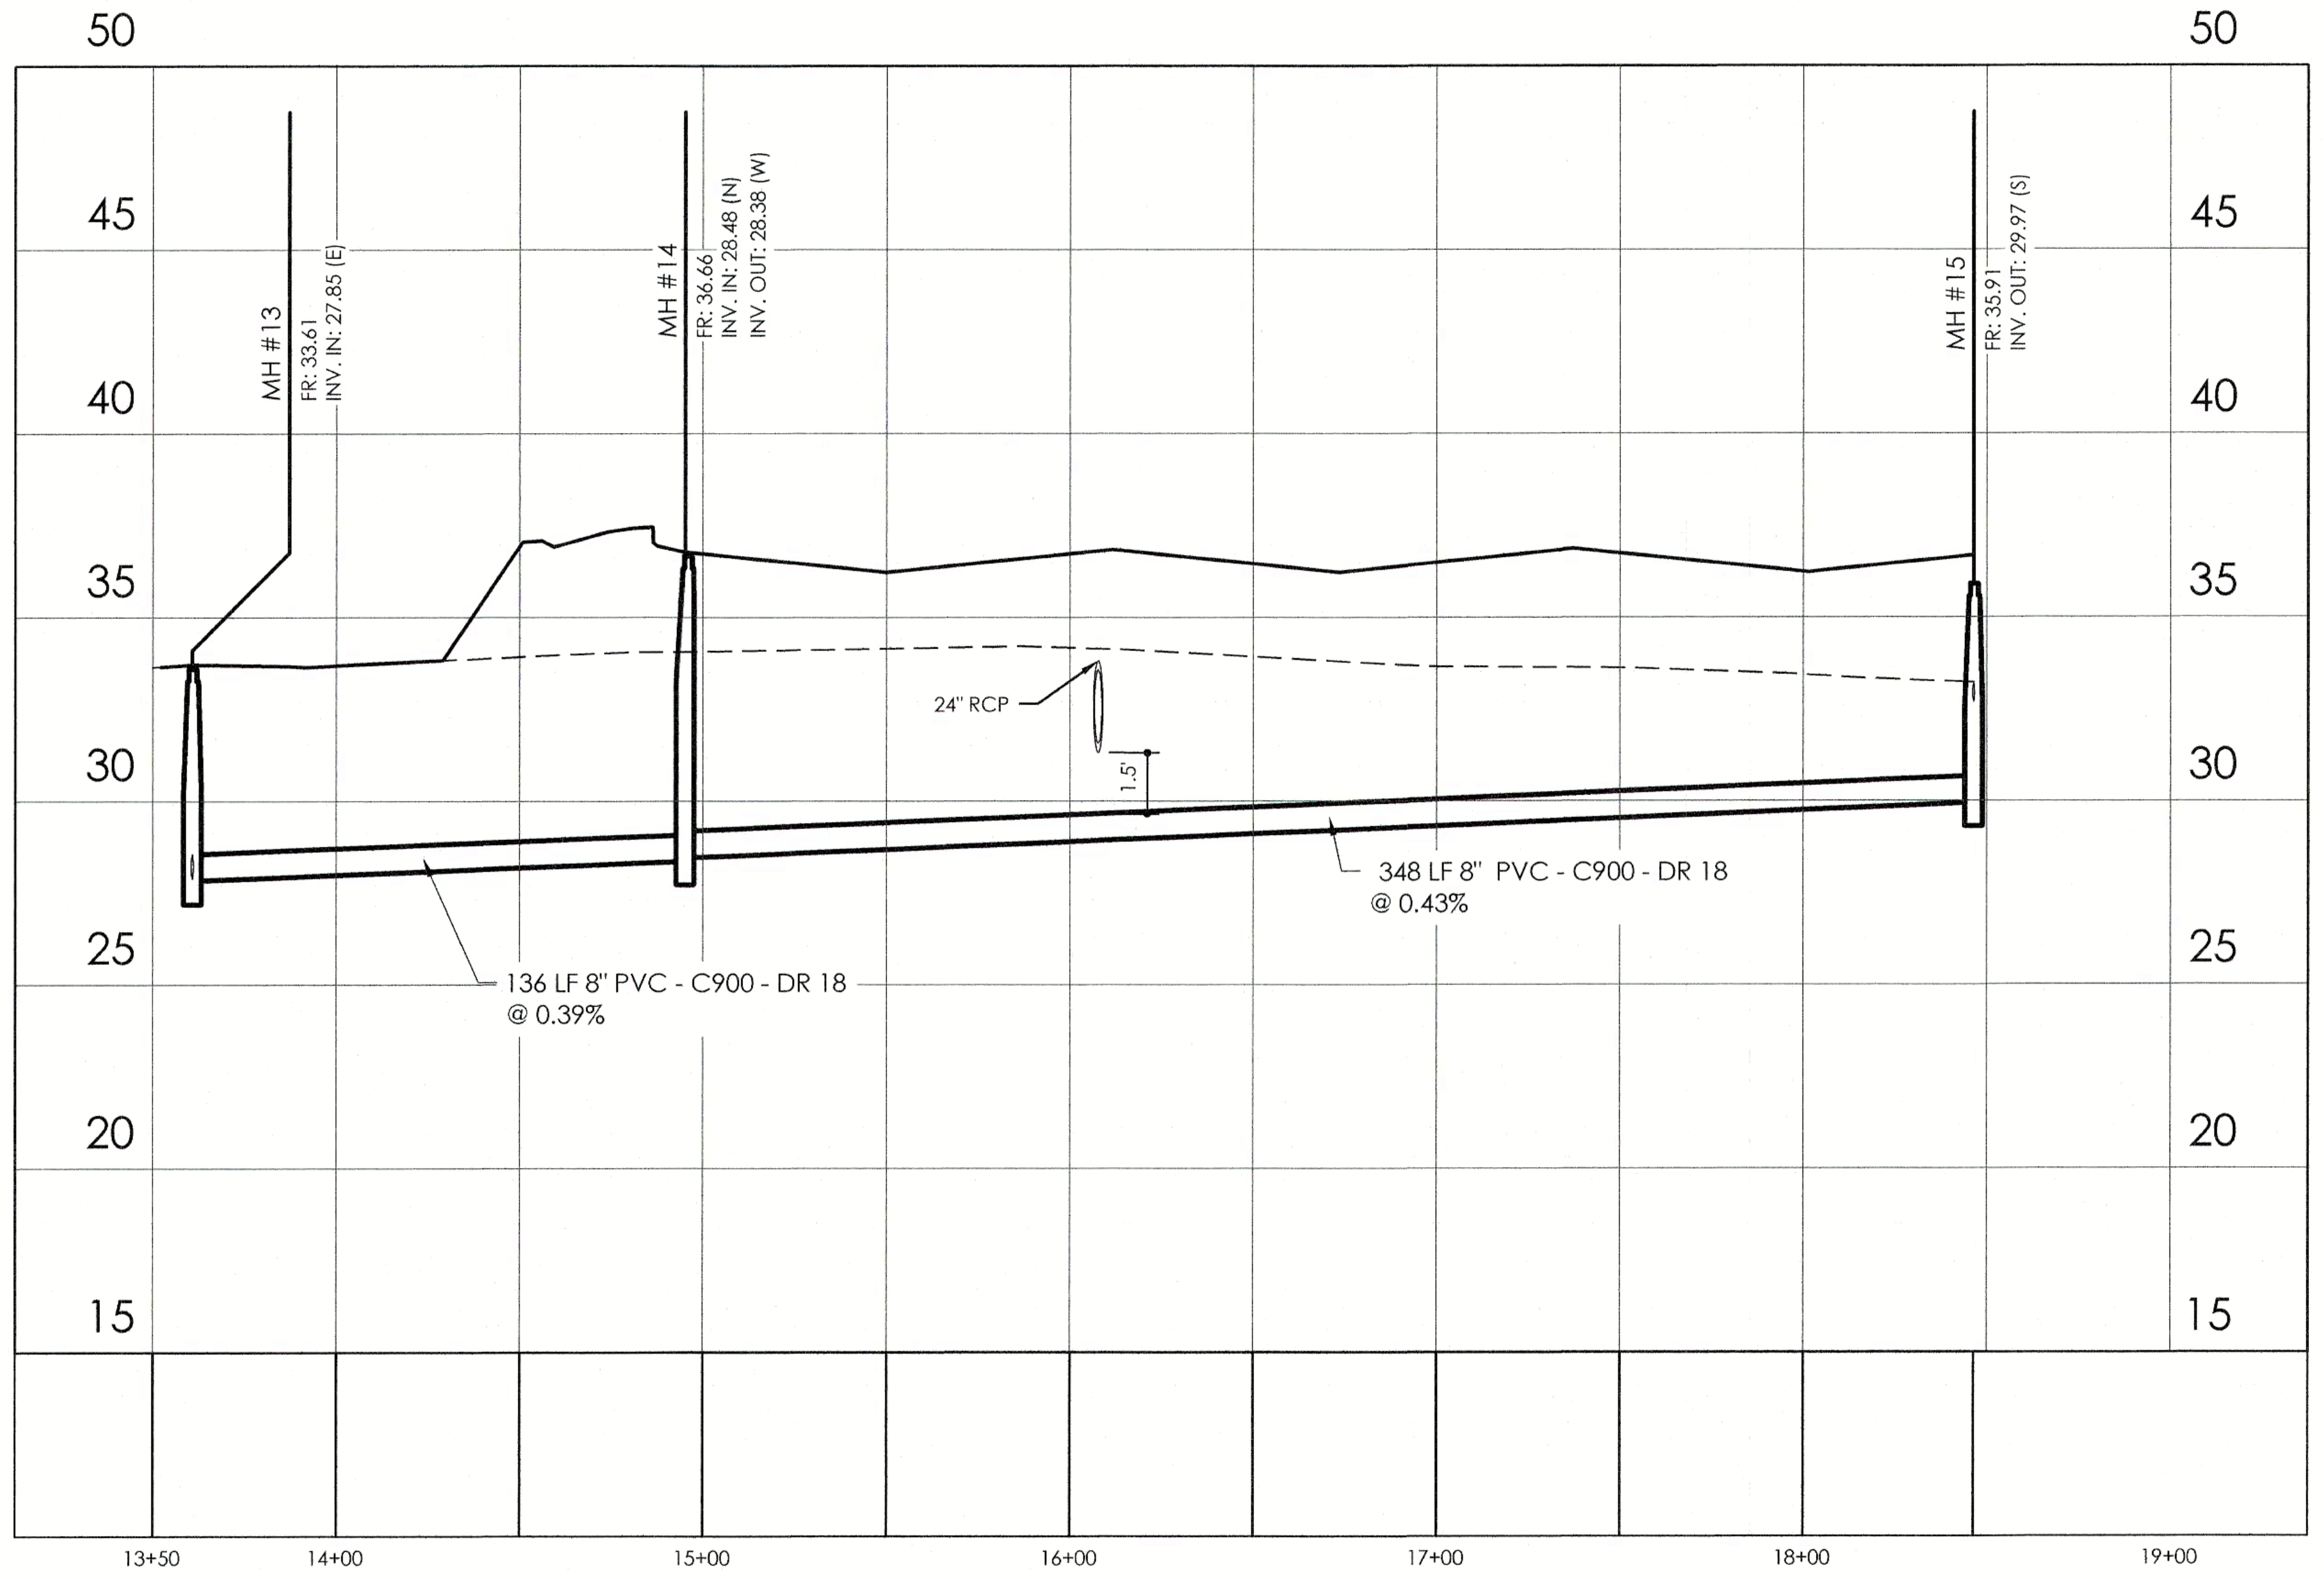

31725.0000 - Sewer - Run 3

STATIONS: 13+50 - 19+00
SCALE: HORZ.: 1" = 50'
VERT.: 1" = 5'

▬▬▬	PROPOSED GRADE
– – –	EXISTING GRADE

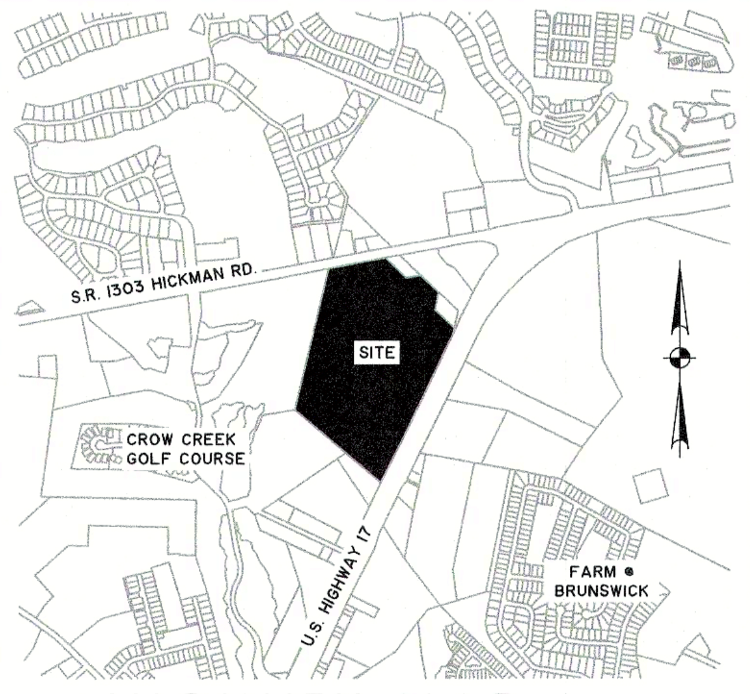

VICINITY MAP not to scale

This document and all reproducible copies of this document are the property of Thomas & Hutton. Reproduction of this document is not permitted without written consent of Thomas & Hutton unless this document becomes a matter of public record. ALTERATIONS TO THIS DOCUMENT ARE NOT PERMITTED.

THOMAS & HUTTON ENGINEERING CO. No. F-0871

SEAL 53169 NATHAN T. POUND

8/4/26

THE FACILITIES HAVE BEEN CONSTRUCTED AS SHOWN ON THE "RECORD DRAWING" PLAN, AND THE FACILITIES MEET THE APPROVED WATER AND WASTEWATER PLAN AND SPECIFICATIONS OR ACHIEVE THE FUNCTION FOR WHICH THEY WERE DESIGNED.

THOMAS & HUTTON ENGINEERING CO. No. F-0871

SEAL L-5564 MATTHEW D. SVEJKOVSKY

I, MATTHEW D. SVEJKOVSKY, CERTIFY THAT THIS WATER & WASTE WATER SYSTEM RECORD DRAWING IS DRAWN UNDER MY DIRECT SUPERVISION, AND BASED ON A FIELD SURVEY BY THOMAS AND HUTTON; THAT THE FIELDWORK WAS COMPLETED ON 27TH DAY OF JULY 2026; THAT THE BOUNDARY LINES SHOWN ARE COMPILED FROM PREVIOUSLY RECORDED MAPS. WITNESS MY HAND AND SEAL THIS 4TH DAY OF AUGUST 2026.

8/4/26

MATTHEW D. SVEJKOVSKY N.C. PROFESSIONAL LAND SURVEYOR
LICENSE NO. L-5564

WATER & SEWER
RECORD DRAWING
OF

CALABASH POINTE
PHASE 3

SHALOTTE TOWNSHIP
BRUNSWICK COUNTY, NORTH CAROLINA

prepared for
LENNAR CAROLINAS, LLC

No.	Revision	By	Date

THOMAS & HUTTON

611 Burroughs & Chapin Blvd. • Suite 202
Myrtle Beach, SC 29577 • 843.839-3545
www.thomasandhutton.com

50 0 50 100
1 INCH = 50 FEET

plat	drawn	reviewed	field	crew
8/4/26	DLF	JC/DOB	7/26	HR

job 31725-PH3-WATER

SHEET 3 OF 3