THOMAS & HUTTON
Engineering | Surveying | Planning | GIS | Consulting

Letter of Transmittal

To: Brunswick County Engineering
Brigit Flora

Date: August 19, 2026
Job 31725.500
Re: Calabash Pointe Phase 3

☐ Shop Drawings ☐ Prints ☐ Plans ☐ Samples ☐ Specifications

☐ Copy of Letter ☐ Change Order ☐ Other: UPS overnight

Copies	Date	Description
1		Engineering Certification letter (W&S)
2 sets		Record Drawings
1		Checklist
1		Indemnity Agreements
1		Water & Sewer Testing
1		Water & Sewer Fixed Asset Amount
1		Contractor's license & Insurance certificate
1		Bac T testing
1		Deed of Dedication and Affidavit
		Check for recording fees (Please confirm amount and I will forward) - forthcoming
1		Thumb drive with separate page record drawing (PDF& CAD)

THESE ARE TRANSMITTED AS CHECKED BELOW:

☒ For Approval ☐ Approved as Submitted ☐ Resubmit _____ Copies for Approval
☐ For Your Use ☐ Approved as Noted ☐ Submit _____ Copies for Distribution
☐ As Requested ☐ Returned for Corrections ☐ Return _____ Corrected Prints
☒ For Review and Comment

Remarks

Copy to _____ Signed Ida Hussey

THOMAS & HUTTON

Public Water System Project

Engineer Certification Form

By the signature below I certify:

The referenced public water system project was completed in substantial compliance with the approved engineering plans and specifications, including any provisions stipulated in the Department's plan approval letter or authorization to construct letter, and revised only in accordance with the provisions of Rule .0306.

This is a

__X__ Full certification

____ Partial certification, covering _____

This certification is based upon inspections conducted (select one):

____ Daily

____ Continuously

__X__ Periodically

By (select one):

____ Myself

__X__ Another under my responsible charge

Seal here:

Engineer Signature: _____ Engineer Name(Print): Nathan Pound, PE

Project Name: Calabash Pointe Phase 3 Date: 6/17/26

Serial No: 24-00129 Water System Name: Brunswick County

Certifications can be sent by mail, fax (919-715-4374), or attachment to an e-mail message to PWSSection.PlanReview@ncdenr.gov

Docusign Envelope ID: 3F3D747E-D9BA-45B6-BEE4-6CAAC6984EB3

FAST TRACK SEWER ENGINEERING CERTIFICATION

PERMITTEE: Brunswick County
PERMIT #: WQ0045877
PROJECT: Calabash Pointe Public Pump Station and Sewer
ISSUE DATE: October 15, 2024
COUNTY: Brunswick

This project shall not be considered complete nor allowed to operate in accordance with Condition 7 of this permit until the Division has received this Certification and all required supporting documentation. Consequently, it should be submitted in a manner that documents the Division's receipt. Send the required documentation to the Wilmington Regional Supervisor, Water Quality Section at the address at the bottom.

The Permittee is responsible for tracking all partial certifications up until a final certification is received. Certifications shall include Phase/Section covered, line size & lengths installed, and listing of lots/connections to be served and pump station design, if applicable. A Final Certification shall be a complete set of record drawings and design calculations regardless of whether partials have been submitted.

PERMITTEE'S CERTIFICATION

I, the undersigned agent for the Permittee, hereby state that this project has been constructed pursuant to the applicable standards & requirements, the Professional Engineer below has provided applicable design/construction information to the Permittee, and the Permittee is prepared to operate & maintain the wastewater collection system permitted herein or portions thereof.

Printed Name, Title	Signature	Date

ENGINEER'S CERTIFICATION

I, Nathan Pound, PE, as a duly registered Professional Engineer in the State of North Carolina, having been authorized to (☑ periodically, ☐ weekly, ☐ full time) observe the construction of the project name and location as referenced above for the above Permittee hereby state that, to the best of my abilities, due care and diligence was used in the observation of the following construction:

approximately 3,822 linear feet of 8-inch gravity sewer; a 250–gallon per minute pump station with duplex pumps, on-site audible and visual high water alarms, telemetry, and a permanent generator with automatic transfer switch as well as approximately 905 linear feet of 6-inch force main to serve 181 three-bedroom residences (38,010 gallons per day), a 113-person swimming pool complex (1,130 gallons per day), and a 35-seat amenity center (175 gallons per day) as part of the CALABASH POINTE PUBLIC PUMP STATION AND SEWER project, and the discharge of 39,315 gallons per day;

such that the construction was observed to be built in compliance of this permit; 15A NCAC 2T; the Division of Water Resources' (Division) Gravity Sewer Minimum Design Criteria adopted February 12, 1996 as applicable; the Division's Minimum Design Criteria for the Fast-Track Permitting of Pump Stations and Force Mains adopted June 1, 2000 as applicable; and other supporting materials.

North Carolina Professional Engineer's Seal w/signature & date

☑ **Final** ☐ **Partial (include description)**

Certification Comments/Qualifiers (attach if necessary):

Docusign Envelope ID: 3F3D747E-D9BA-45B6-BEE4-6CAAC6984EB3

SEWER ENGINEERING CERTIFICATION CHECKLIST

To be completed by the certifying engineer prior to operation of the permitted sewers, per 15A NCAC 02T.0116.

Certifying Engineer: Nathan Pound, PE

Certification Review Date: _____

Project Name: Calabash Pointe Phase 3

WQ00 45877 **Project County:** Brunswick

1) Has permittee information changed since the permit was issued (or last modified): change of mailing address, change of ownership, transfer from developer to HOA/POA, etc. ☐ Yes ☒ No
   - If yes, please provide either a change of ownership form or new contact information. Note that transfer of permits from the developer to the HOA/POA must occur with the first certification.
2) Have the as-built drawings have been signed, sealed, and dated by an N.C. PE? ☒ Yes ☐ No
3) Final Engineering certification? ☒ Yes ☐ No
   - **If Partial Engineering certification, provide detailed narrative including what is being certified in the current phase, what was previously certified (if applicable), and what is left to be certified.**
4) Adequate information related to sewer lines: ☒ Yes ☐ No ☐ N/A
   - Three feet minimum cover has been provided for all sewers unless ferrous pipe was installed.
   - Minimum diameters for gravity sewers are 8-inches for public lines and 6-inches for private lines.
   - Manholes have been installed: At the end of each line, at all changes in grade, size, or alignment, at all intersections, and at distances not greater than 425 feet; minimum diameter shall be 4 feet (48-inches).
5) Adequate information related to pump stations: ☒ Yes ☐ No ☐ N/A
   - Ensure power reliability option was selected per 15A NCAC 02T.0305(h).
6) Was project construction completed in accordance with all of the following: ☒ Yes ☐ No ☐ N/A
   - 15A NCAC 02T, Minimum Design Criteria (MDC) for the permitting of Gravity Sewers (latest version), and MDC for the Permitting of Pump Stations and Force Mains (latest version)?

If not, a variance approval is required in accordance with 15A NCAC 02T.0105(b), **prior to certification and operation.**

- Contact the Central Office to discuss the variance to determine a course of action.
- Applicant must submit two copies of the variance request form, plans, specifications, calculations, and any other pertinent information to the Central Office (one hard copy, one digital copy).
- The central office will review the variance request, and if approvable, specific language regarding the variance will be incorporated into the permit, either via a special condition or a supplementary letter. A copy of the reissued permit with variance language or the variance letter must be maintained with the original documents.

7) Does the project contains high priority lines (15A NCAC 02T .0402(2))? ☐ Yes ☒ No
   - If yes, ensure that the permit already contains the necessary condition related to high priority lines 15A NCAC 02T.0403 (a)(5). If the permit does not include this language, the Fast Track reviewer will reissue the permit with the appropriate language.
8) Are Permit modifications are required for any changes resulting in non-compliance with this permit (including pipe length difference of 10% or greater, change in flow, pump station design capacity design change of 5% or greater, and change in the number/type of connections)? ☐ Yes ☒ No
   - If yes, a permit modification request must be submitted to the appropriate Regional Office, and **a modified permit with revised certification must be issued prior to certification and operation**.

BRUNSWICK COUNTY CONSTRUCTION CHECKLIST

Project: Calabash Pointe Phase: 3 Lots: _____

Engineering Firm: Thomas & Hutton Contractor(s): RH Moore

Date of PreCon Meeting: _____ Date of NCDOT PreCon Meeting: _____

WATER / SEWER / BOTH

Substantial Completion

X Engineering Certification for Water

Rec'd from Engineer: _____ PWSS Partial or Final Approval: _____

X Engineering Certification for Sewer

Rec'd from Engineer: _____ DWQ Partial or Final Approval: _____

X Bacteriological Test Reports (from a N. C. licensed lab)

X All Testing Results

X Substantial Completion Walkthrough

Note: if older style double meter boxes installed verify direct bury check valve installed on double boxes Yes: _____ No: _____

X Water Indemnity Agreement

X Sewer Indemnity Agreement

X Copy of Contractor's Utilities License

X Copy of Contractor's Certificate of Insurance

X Asbuilt record drawings – (1) sealed paper set and a USB flash drive with AutoCAD file (AutoCAD version 2007 minimum and 2022 latest version) **and** PDFs of all individual sheets; AutoCAD file **must** be georeferenced or asbuilts will not be accepted
Note: Water and /or Sewer Certifications will not be processed without approved asbuilts

Final Acceptance

_____ Paving on all Streets

_____ Final Walk Through

_____ Revised Asbuilts (if any changes)

_____ Check for recording fees

X Fixed Assets Amount
Water $125,232.00
Sewer $107,350.00

X Deed of Dedication / Affidavit

SEWER INDEMNITY AGREEMENT

This Agreement made this the 8th day of May, 20 26, between Lennar Carolinas LLC, hereinafter Developer, and the County of Brunswick, a body politic and corporate, duly organized under the Constitution and laws of North Carolina, hereinafter County,

Whereas, the Developer has declared an intention to or has constructed a new sewer system to serve a property generally known as Calabash Pointe Phase 3, and has made provision for the use of this sewer system to supply the current and future needs of its development goals, and it is the intention of the Developer and the County that the new sewer system will be accepted into the County's sewer system to serve its customers at or near the subject property area, and

Whereas, the Developer has expressed a desire to have the new sewer system installed in an area that the Developer intends to cover with an impervious material, for uses including, but not limited to, parking, storage, or any other use that would impair the County's access to the said sewer system in the event of needed repair or other modification of the said system, and

Whereas, the County wishes not to unduly impede the progress of the Developer in the business of its scheduled construction and development, and to help the Developer meet its sewer needs while supplying quality sewer service to all of its customers,

Therefore, in consideration of the mutual covenants herein, the County will supply sewer service to Calabash Pointe Phase 3, in exchange for this agreement, whereby the Developer agrees that at all times subsequent to the transfer of this new sewer system by the Developer to, and acceptance by, the County into the County's sewer system, this agreement shall continue in force.

The said Developer for so long as it owns, or until NC DOT has accepted for maintenance as a dedicated public roadway, the area covered with an impervious material which lay above the sewer line, in exchange for the County's acceptance of the said sewer line being located beneath an impervious material, shall timely make all necessary and prudent repairs to the said impervious surface should said surface be disrupted by the County due to necessary maintenance activity. All repairs shall conform with the surrounding material such that there shall not be, after any pavement repair, that a hazardous condition exist, or any condition that would result in damage or injury to the said sewer system.

Developer further agrees that upon transfer of title to a third party, it shall include a covenant or other express condition applicable to the grantee, its successors or assigns (including a property owner association which holds title to the property as common area), assigning the obligation to make in a timely manner all necessary and prudent repairs to the said impervious surface under which the sewer line is located. Developer further agrees that the instrument assigning the obligation shall be appropriately filed with the Brunswick County Registry of Deeds. Provided that, in the case of a dedicated public road, upon receipt of a maintenance agreement from NC DOT, Developer will assign said repair obligation by covenant or other instrument, on the grantees, their successors or assigns (including a property owners association), of the development in which said public roads are located.

In witness thereof, the parties hereto have affixed their signatures on the date first entered above.

Developer — Date: 5/8/2026

Brunswick County — Date

Brigit Flora, PE, CFM
Engineering Services Director

WATER INDEMNITY AGREEMENT

This Agreement made this the 8th day of May, 20 26, between Lennar Carolinas LLC, hereinafter Developer, and the County of Brunswick, a body politic and corporate, duly organized under the Constitution and laws of North Carolina, hereinafter County,

Whereas, the Developer has declared an intention to or has constructed a new water system to serve a property generally known as Calabash Pointe Phase 3, and has made provision for the use of this water system to supply the current and future needs of its development goals, and it is the intention of the Developer and the County that the new water system will be accepted into the County's water system to serve its customers at or near the subject property area, and

Whereas, the Developer has expressed a desire to have the new water system installed in an area that the Developer intends to cover with an impervious material, for uses including, but not limited to, parking, storage, or any other use that would impair the County's access to the said water system in the event of needed repair or other modification of the said system, and

Whereas, the County wishes not to unduly impede the progress of the Developer in the business of its scheduled construction and development, and to help the Developer meet its water needs while supplying quality water service to all of its customers,

Therefore, in consideration of the mutual covenants herein, the County will supply water service to Calabash Pointe Phase 3, in exchange for this agreement, whereby the Developer agrees that at all times subsequent to the transfer of this new water system by the Developer to, and acceptance by, the County into the County's water system, this agreement shall continue in force.

The said Developer for so long as it owns, or until NC DOT has accepted for maintenance as a dedicated public roadway, the area covered with an impervious material which lay above the water line, in exchange for the County's acceptance of the said water line being located beneath an impervious material, shall timely make all necessary and prudent repairs to the said impervious surface should said surface be disrupted by the County due to necessary maintenance activity. All repairs shall conform with the surrounding material such that there shall not be, after any pavement repair, that a hazardous condition exist, or any condition that would result in damage or injury to the said water system.

Developer further agrees that upon transfer of title to a third party, it shall include a covenant or other express condition applicable to the grantee, its successors or assigns (including a property owner association which holds the property as common area), assigning the obligation to make in a timely manner all necessary and prudent repairs to the said impervious surface under which the water line is located. Developer further agrees that the instrument assigning the obligation shall be appropriately filed with the Brunswick County Registry of Deeds. Provided that, in the case of a dedicated public road, upon receipt of a maintenance agreement from NC DOT, Developer will assign said repair obligation by covenant or other instrument, on the grantees, their successors or assigns (including a property owners association), of the development in which said public roads are located.

In witness thereof, the parties hereto have affixed their signatures on the date first entered above.

Earl Bailey 5/8/2026

Developer Date

Brunswick County Date
Brigit Flora, PE, CFM
Engineering Services Director

BRUNSWICK COUNTY ENGINEERING DEPARTMENT

UTILITY SYSTEM TESTING LOG

5-7-2026

Project	Calabash Point Phase 3
Engineer	Thomas & Hutton Engineering Co./ Nathan Pound,P.E.
Contractor	R.H.Moore Company,INC.
Performed by (Cont)	Name Tyler Steele Sign:
Witnessed by (Eng)	Name: Jason Caud Sign:
Witnessed by (BC)	Name: CHRIS ROBINSON Sign:

Gravity Sewer Testing (go-no go mandrel, 5 PSIG air test)

From SSMH	To SSMH	Mandrel Pass /Fail	5 PSIG Air Test Pass / Fail
MH 15	MH 14	PASS	PASS
MH 14	MH 13	PASS	PASS
MH 13	MH 12	PASS	PASS

BRUNSWICK COUNTY ENGINEERING DEPARTMENT

UTILITY SYSTEM TESTING LOG

Project	Calabash Pointe Phase 3
Engineer	Thomas & Hutton Engineering Co./Nathan Pound, PE.
Contractor	R. A. Moore Company, INC.
Performed by (Cont.)	Name: Tyler Steele Sign:
Witnessed by (Eng)	Name: Jimmy Card Sign:
Witnessed by (Brun Co)	Name: CHRIS ROBINSON Sign:
Date:	5-7-2026

WATER MAIN Pressure Test – 150 PSI minimum for (2) hours minimum

System	Beginning PSIG	Time	End PSIG	Time	Pass / Fail
8" C900/DR18 PVC					
	: Test all Phase 3				
	107s-157-181				

Pressure Gauge Located at: TS+GV

Blew off at: 2 F.H.

Gauge(s) went to zero? Yes ✓ No _____

Signed: _____

envirochem
ANALYTICAL & CONSULTING CHEMISTS

Environmental Chemists, Inc.

6602 Windmill Way, Wilmington, NC 28405 • 910.392.0223 Lab • 910.392.4424 Fax
710 Bowsertown Road, Manteo, NC 27954 • 252.473.5702 Lab/Fax
255-A Wilmington Highway, Jacksonville, NC 28540 • 910.347.5843 Lab/Fax

info@environmentalchemists.com

BACTERIOLOGICAL ANALYSIS

Note ALL applicable information must be supplied for compliance credit

Water System ID #: Calabash Pointe (North Drill) **County:**

System Type: **Water Source:**

Distribution - Total Coliform Rule (TCR)

SampleType: Special
Facility ID: D01 Location Code: FH1
Sample Point: Special Location: FYI

Collected by: Reece Warfel **DATE:** 5/14/2026 **TIME:** 2:30:00 PM

Mail Results to (water system representative):

N3 Construction
4829 Cocoronado Drive
Wilmington NC 28409
Phone Number: 910-777-9284
Fax Number:

Complete for Repeat, Triggered, or Additional / Confirmation Samples:
Previous Positive Laboratory ID Number: _____
" Positive Laboratory Log Number _____
" Positive Location Code _____
" Positive Collection Date: _____

Disinfectant Used:

Total Chlorine Residual 2.3 mg/L
Free Chlorine Residual: mg/L

Responsible Person's Name | Customer Number 25010020

LABORATORY ID # 37729 ☐ Repeat Samples Required from Client ☐ Resample Required from Client

CONTAM CODE	CONTAMINANT	METHOD CODE	QUANTIFIED RESULTS	ANALYSES BEGUN	ANALYSES COMPLETED
3100	Total Coliform	SM 9223B	Absent	05/14/2026 16:50	5/15/2026 11:00
3014	E. Coli	SM 9223B	Absent	05/14/2026 16:50	5/15/2026 11:00

Comment:

Reviewed by: Sara Howell

Laboratory Log Number: 26-26095 REPORT #: 2026-10464

Project: Calabash Pointe Phase 3				Location: BRUNSWICK COUNTY	
Owner: LENNAR CAROLINAS					
Engineer: THOMAS & HUTTON ENGINEERING					
		CONTRACT ESTIMATE			
NO.	DESCRIPTION		BID	UNIT	BID
		UNIT	QTY	PRICE	TOTAL
	2851 - WATER				
1.	12" x 8" Tappping Sleeve & Valve	EA	1	$11,240.00	$11,240.00
2.	8" DR18 PVC Water	LF	711	$35.00	$24,885.00
3.	8" MJ Gate Valve	EA	2	$2,525.00	$5,050.00
4.	8" x 6" MJ Reducer	EA	1	$600.00	$600.00
5.	8" Obstruction Bypass	EA	1	$5,620.00	$5,620.00
6.	8" Bell Restraints	EA	7	$190.00	$1,330.00
7.	Fire Hydrant Assembly	EA	2	$7,425.00	$14,850.00
8.	Single Water Services	EA	25	$1,935.00	$48,375.00
9.	1" Irrigation Tap	EA	2	$2,395.00	$4,790.00
10.	1.5" Irrigation Tap	EA	1	$3,250.00	$3,250.00
11.	Marker Balls	EA	11	$22.00	$242.00
12.	Testing and Chlorination	LS	1	$10,000.00	$5,000.00
	SUBTOTAL WATER				**$125,232.00**

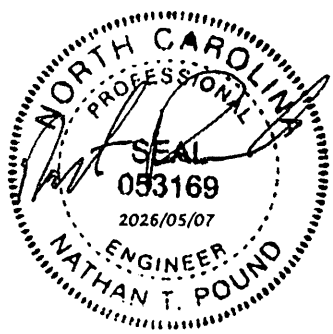

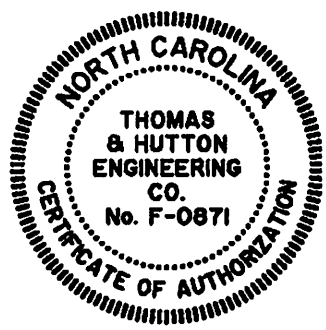

Project: Calabash Pointe Phase 3				Location: BRUNSWICK COUNTY	
Owner: LENNAR CAROLINAS					
Engineer: THOMAS & HUTTON ENGINEERING					
ITEM	DESCRIPTION		UNIT	BID	TOTALS
				UNIT	
	2751 - GRAVITY SEWER				
1.	8" PVC SDR18 Gravity (0 - 6)	LF	600	$67.00	$40,200.00
2.	4' Dia Manhole (0 - 6)	EA	1	$5,250.00	$5,250.00
3.	4' Dia Manhole (6 - 8)	EA	1	$5,820.00	$5,820.00
4.	4' Dia Manhole (8 - 10)	EA	1	$6,330.00	$6,330.00
5.	Single Sewer Services	EA	25	$1,790.00	$44,750.00
6.	Testing	LS	1	$10,000.00	$5,000.00
	SUBTOTAL GRAVITY SEWER				**$107,350.00**

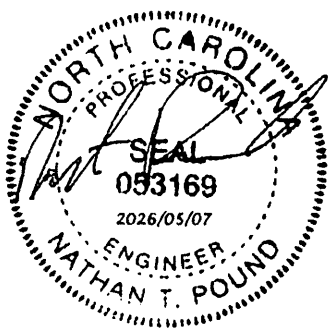

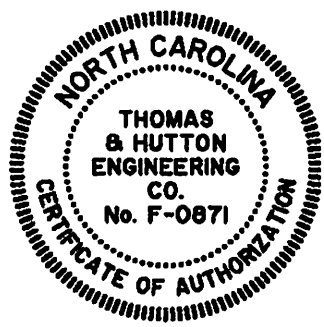

Client#: 192344 RHMOOR

ACORD™ CERTIFICATE OF LIABILITY INSURANCE

DATE (MM/DD/YYYY): 6/26/2026

THIS CERTIFICATE IS ISSUED AS A MATTER OF INFORMATION ONLY AND CONFERS NO RIGHTS UPON THE CERTIFICATE HOLDER. THIS CERTIFICATE DOES NOT AFFIRMATIVELY OR NEGATIVELY AMEND, EXTEND OR ALTER THE COVERAGE AFFORDED BY THE POLICIES BELOW. THIS CERTIFICATE OF INSURANCE DOES NOT CONSTITUTE A CONTRACT BETWEEN THE ISSUING INSURER(S), AUTHORIZED REPRESENTATIVE OR PRODUCER, AND THE CERTIFICATE HOLDER.

IMPORTANT: If the certificate holder is an ADDITIONAL INSURED, the policy(ies) must have ADDITIONAL INSURED provisions or be endorsed. If SUBROGATION IS WAIVED, subject to the terms and conditions of the policy, certain policies may require an endorsement. A statement on this certificate does not confer any rights to the certificate holder in lieu of such endorsement(s).

PRODUCER
Propel Insurance
1410 Blanding Street
Suite 100
Columbia, SC 29201-2967

CONTACT NAME: Madison Johnston
PHONE (A/C, No, Ext): 803 733-5284 **FAX (A/C, No):** 866 577-1326
E-MAIL ADDRESS: Madison.Johnston@propelinsurance.com

INSURER(S) AFFORDING COVERAGE	NAIC #
INSURER A : Amerisure Insurance Company	19488
INSURER B : Amerisure Mutual Insurance Company	23396
INSURER C : SiriusPoint Specialty Insurance Corp	16820
INSURER D : Amerisure Partners Insurance Company	11050
INSURER E : Colony Specialty Insuance Company	36927
INSURER F :	

INSURED
RH Moore Company, Inc.
PO Box 830
Murrells Inlet, SC 29576

COVERAGES **CERTIFICATE NUMBER:** **REVISION NUMBER:**

THIS IS TO CERTIFY THAT THE POLICIES OF INSURANCE LISTED BELOW HAVE BEEN ISSUED TO THE INSURED NAMED ABOVE FOR THE POLICY PERIOD INDICATED. NOTWITHSTANDING ANY REQUIREMENT, TERM OR CONDITION OF ANY CONTRACT OR OTHER DOCUMENT WITH RESPECT TO WHICH THIS CERTIFICATE MAY BE ISSUED OR MAY PERTAIN, THE INSURANCE AFFORDED BY THE POLICIES DESCRIBED HEREIN IS SUBJECT TO ALL THE TERMS, EXCLUSIONS AND CONDITIONS OF SUCH POLICIES. LIMITS SHOWN MAY HAVE BEEN REDUCED BY PAID CLAIMS.

INSR LTR	TYPE OF INSURANCE	ADDL INSR	SUBR WVD	POLICY NUMBER	POLICY EFF (MM/DD/YYYY)	POLICY EXP (MM/DD/YYYY)	LIMITS	
A	X COMMERCIAL GENERAL LIABILITY			CPP21262460201	07/01/2026	07/01/2027	EACH OCCURRENCE	$1,000,000
	CLAIMS-MADE X OCCUR						DAMAGE TO RENTED PREMISES (Ea occurrence)	$100,000
							MED EXP (Any one person)	$5,000
							PERSONAL & ADV INJURY	$1,000,000
	GEN'L AGGREGATE LIMIT APPLIES PER:						GENERAL AGGREGATE	$2,000,000
	POLICY X PRO-JECT LOC						PRODUCTS - COMP/OP AGG	$2,000,000
	OTHER:							$
A	AUTOMOBILE LIABILITY			CA21262450201	07/01/2026	07/01/2027	COMBINED SINGLE LIMIT (Ea accident)	$1,000,000
	X ANY AUTO						BODILY INJURY (Per person)	$
	OWNED AUTOS ONLY / SCHEDULED AUTOS						BODILY INJURY (Per accident)	$
	X HIRED AUTOS ONLY / X NON-OWNED AUTOS ONLY						PROPERTY DAMAGE (Per accident)	$
	X Drive Oth Car							$
B	X UMBRELLA LIAB X OCCUR			CU21262480202	07/01/2026	07/01/2027	EACH OCCURRENCE	$10,000,000
C	EXCESS LIAB CLAIMS-MADE			ARCUSXC333442026	07/01/2026	07/01/2027	AGGREGATE	$10,000,000
	DED X RETENTION $10000							$
D	WORKERS COMPENSATION AND EMPLOYERS' LIABILITY			WC21262110205	07/01/2026	07/01/2027	X PER STATUTE / OTH-ER	
	ANY PROPRIETOR/PARTNER/EXECUTIVE OFFICER/MEMBER EXCLUDED? Y / N: N	N / A					E.L. EACH ACCIDENT	$1,000,000
	(Mandatory in NH)						E.L. DISEASE - EA EMPLOYEE	$1,000,000
	If yes, describe under DESCRIPTION OF OPERATIONS below						E.L. DISEASE - POLICY LIMIT	$1,000,000
E	Install Floater Contractors Equip			IM2571264	07/01/2026	07/01/2027	$2,000,000 Inst Floater $750,000 Leased/Rented $2,500 Deductible	

DESCRIPTION OF OPERATIONS / LOCATIONS / VEHICLES (ACORD 101, Additional Remarks Schedule, may be attached if more space is required)

** Excess Liability Information **

C ARCUSXC333442026 Eff Date: 07/01/2026 Exp Date: 07/01/2027
Excess Liability Each Occ Limit: $5,000,000
(See Attached Descriptions)

CERTIFICATE HOLDER

Lennar Carolinas, LLC
1941 Savage Road
Suite 100-C
Charleston, SC 29407

CANCELLATION

SHOULD ANY OF THE ABOVE DESCRIBED POLICIES BE CANCELLED BEFORE THE EXPIRATION DATE THEREOF, NOTICE WILL BE DELIVERED IN ACCORDANCE WITH THE POLICY PROVISIONS.

AUTHORIZED REPRESENTATIVE

© 1988-2015 ACORD CORPORATION. All rights reserved.

DESCRIPTIONS (Continued from Page 1)

Excess Liability Aggregate Limit: $5,000,000
**** Workers Comp Information ****
Experience Mod Factor 1 ; Total Factor:
Deductible Adjustment ; Total Factor:

Coverage is provided for all Jobs/Locations Lennar Corporation including its subsidiaries, partners, partnerships, affiliated companies, successors and assigns and all other parties as required by written contract with the Named Insured are additional insureds on a primary and noncontributory basis with regards to General Liability for on-going and completed operations per CGL7324(03/23). General Liability policy does not contain an exclusion for Explosion, Collapse or Underground Operations. General Liability policy includes coverage for Contractual Liability subject to policy terms, conditions & exclusions. Waiver of Subrogation applies in favor of Lennar Corporation including its subsidiaries, partners, partnerships, affiliated companies, successors and assigns with regard to general liability per CGL7049(04/17) and workers compensation per WC000313 as required by written contract with the Named Insured. A 30 Day Notice of Cancellation is provided in favor of the certificate holder (except 10 days for non-payment of premium).

Expiration Date

2026

License No.

15276

North Carolina

Licensing Board for General Contractors

This is to Certify That:

R. H. Moore Company, Inc.

Murrells Inlet, SC

is duly registered and entitled to practice

General Contracting

Limitation: Unlimited

Classification: H (Grading & Excavating), PU(Water Lines & Sewer Lines)

until

December 31, 2026

when this Certificate expires.

Witness our hands and seal of the Board.

Dated, Raleigh, N.C.

01/01/2026

This certificate may not be altered.

LICENSING BOARD FOR GENERAL CONTRACTORS * NORTH CAROLINA * MAY 20, 1775

Chairman

Secretary-Treasurer

Prepared by: St. Amand & Efird, PLLC
3315 Springbank Lane, Suite 308
Charlotte, NC 28226

This instrument prepared by: Paul Comer, a licensed North Carolina attorney. Delinquent taxes, if any, to be paid by the closing attorney to the county tax collector upon disbursement of closing proceeds.

DEED OF DEDICATION

STATE OF NORTH CAROLINA

COUNTY OF BRUNSWICK

THIS DEED OF DEDICATION, is made and entered into this the ____ day of _____, 2026 by and between LENNAR CAROLINAS, LLC, a Delaware limited liability company, whose mailing address is 1505 King Street Extension, Suite 100, Charleston, SC 29405, party of the first part, herein referred to as "**Developer**," MILLROSE PROPERTIES NORTH CARLINA, LLC, a North Carolina limited liability company, whose mailing address is 600 Brickell Ave., Miami, FL 33131, party of the second part, herein referred to as "**Owner**," and BRUNSWICK COUNTY, a governmental entity created and existing under the laws of the State of North Carolina, whose mailing address is P.O. Box 249, Bolivia, NC 28422, party of the third part, herein after referred to as "**Grantee**";

WITNESSETH:

Whereas, Developer is the developer of a tract of parcel located in Shallotte Township, Brunswick County, North Carolina known as Calabash Pointe Phase 3, herein referred to as the "Subdivision";

Whereas, Owner is the record owner of the Subdivision and joins in this Deed of Dedication for the limited purpose of consenting to the conveyance of the water lines, gravity sewer lines, and force main herein described to the Grantee for public maintenance, but for no other purpose;

And whereas Developer has caused to be installed water lines, gravity sewer lines, and force main under and along the road rights-of-way hereinafter described and referenced;

And whereas Developer wishes to obtain water and sewer from Grantee for the Subdivision and to make water and sewer from Grantee's system available to individual lot owners within the Subdivision; and

Whereas Grantee has adopted through appropriate resolution stated policy regarding water distribution and sewer systems under the terms of which, among other things, in order to obtain water and sewer for said Subdivision, Developer must convey title to the water and sewer distribution system to Grantee through an instrument of dedication acceptable to Grantee.

NOW, THEREFORE, Developer, in consideration of Grantee accepting said water and sewer lines and making water and sewer available to said Subdivision, has conveyed by these presents does hereby convey to Grantee, its lawful successors and assigns, the following described property:

> All of the water lines, gravity sewer lines, and force main and related and ancillary equipment to serve the Subdivision as shown on the survey maps attached hereto as **Exhibit "A"** for Calabash Pointe Phase 3 (herein, the "**Facilities**").

TO HAVE AND TO HOLD said Facilities above described together with the privileges and appurtenances thereto belonging to Grantee forever.

Non-exclusive easements over, along, and upon the entire area of the streets and cul-de-sacs depicted on the maps and serving the areas referenced above for purposes of entry into the Subdivision for maintenance, repair, and upkeep of Facilities and for connecting the same to the individual lots developed or to be developed lying adjacent to said streets and cul-de-sacs reserving unto Developer, its successor and assigns, equal rights of easement and easement over, in, along, and upon said streets and cul-de-sacs for

purposes of installing and maintaining such utilities as may be required for the development of said Subdivision, including, but not limited to, electric, gas, telephone, cable, and sewer.

And Developer does hereby covenant that it is seized of said water and sewer lines and equipment described above in fee simple and has the right to convey the same in fee simple, that the same are free and clear of encumbrances, and that it will warrant and defend the title to the same against all persons whomsoever.

Developer warrants to Grantee that the system herein conveyed is of good quality and free from faults and defects, and conforms to as-built drawings. Developer's foregoing warranty for said system shall expire and be of no further force or effect after a period of one (1) year from the date of recording of this Deed of Dedication in the office of the Brunswick County Register of Deeds. For the avoidance of all doubt, the warranties and obligations in this Deed of Dedication, are the sole and exclusive responsibility of Developer, and Owner shall have no obligation to carry out the same.

[SIGNATURE PAGE TO FOLLOW]

IN WITNESS WHEREOF, the Developer has caused this instrument to be duly executed, the day and year first above written.

DEVELOPER:

LENNAR CAROLINAS, LLC
a Delaware limited liability company

By: Earl Bailey
Name: Earl Bailey
Title: Vice President

STATE OF SOUTH CAROLINA

COUNTY OF HORRY

Signed and sworn to (or affirmed) before me this day by _____, Vice President of Lennar Carolinas, LLC, a Delaware limited liability company in the capacity and for the purposes herein indicated.

Date: 8-19-26

Signature of Notary Public

(NOTARY SEAL)

Maggie Montanaro
Printed or Typed Name of Notary Public

My Commission Expires: 6-19-35

IN WITNESS WHEREOF, the Owner has caused this instrument to be duly executed, the day and year first above written, for the limited purpose of conveying any interest in the Facilities that Owner may have, but without making or assuming any of the warranties and/or obligations of Developer herein.

OWNER: Carolina DMH
MILLROSE PROPERTIES NORTH ~~CARLINA~~, LLC, a North Carolina limited liability company

By: _____
Printed: Graig Bantle

State of Pennsylvania

County of Montgomery

The foregoing instrument was acknowledged before me this 18 day of August, 2026, by Graig Bantle, as Authorized Signatory for MILLROSE PROPERTIES NORTH ~~CARLINA~~ Carolina, LLC, a North Carolina limited liability company. DMH

Denise M Hundemann
(Notary Signature)

(AFFIX NOTARY SEAL BELOW)

Denise M. Hundemann
(Notary Name Printed)
NOTARY PUBLIC

Commonwealth of Pennsylvania - Notary Seal
DENISE M HUNDEMANN - Notary Public
Montgomery County
My Commission Expires March 31, 2029
Commission Number 1215742

Commission No. 1215742

My Commission Expires: March 31, 2029

ACCEPTANCE OF DEED

This Deed of Dedication and accompanying Affidavit for (Developer) was accepted by the Brunswick County Board of Commissioners on the _____ day of _____, 2026.

Brunswick County Board of Commissioners

_____
Randy Thompson, Chairman

_____
Daralyn Spivey
Clerk to the Board

Exhibit "A"

[SEE ATTACHED PAGES]

Z:\31725.0000\Survey\DWG\SUB PLATS\31725.0000s01(PH 3).dwg - Jan 12, 2026 - 8:05:26 AM

NC GRID NAD 83(2011)

STATE ROUTE 1303 HICKMAN RD.
(100' PUBLIC R/W)

TO WILMINGTON

TO LITTLE RIVER

N: 67,954.00
E: 2,129,648.15

N 79°45'31" E 123.71'(TIE)

1/2"

1/2"

N: 67,870.73
E: 2,129,187.17

1"

S 79°47'45" W 1391.85'(TIE)

1/2"

N 79°45'31" E 468.45'(TOTAL)

74.16'

273.10'

10' NCDOT EASEMENT

30' PROPERTY BUFFER

121.19'

10' NCDOT EASEMENT

30' PROPERTY BUFFER

C1

C2

EDWARD STANLEY
2250003501
D.B. 1632 PG. 1089

S 46°18'27" E 300.08'

LXA HOLDINGS, LLC
2250003502
D.B. 5475 PG. 164
M.C. 163, PG. 3

1"

COMMON AREA 3

PRIVATE D.E.

74'

L48 L88 L49 L4
157) 2,612 S.F. L5
L47 L46 L77 L6
158) 1,500 S.F.
L45 L76 L7
159) 1,500 S.F.
L44 L75 L8
160) 1,500 S.F.
L43 L74 L9
161) 2,612 S.F.
L42 L73 L10
162) 2,612 S.F.
L41 L72 L11
163) 1,500 S.F.
L40 L71 L12
164) 1,500 S.F.
L39 L70 L13
165) 1,500 S.F.
L38 L69
166) 2,612 S.F.
L37 L68 L14
167) 2,612 S.F.
L36 L67 L15
168) 1,500 S.F.
L35 L66 L16
169) 1,500 S.F.
L34 L65 L17
170) 1,500 S.F.
L33 L64 L18
171) 2,612 S.F.
L32 L19 L20

622.92'

389.00'(TOTAL)

398.80'(TOTAL)

30' PROPERTY BUFFER

N 14°04'05" E

S 14°04'05" W

20' PRIVATE D.E.

10' PRIVATE D.E.

STARFISH COVE DRIVE
(PRIVATE INGRESS/EGRESS & UTILITY EASEMENT WIDTH VARIES)

L31 L50 L51
181) 2,612 S.F. L87 L52
L30 L78
180) 1,500 S.F. L53
L29 L79
179) 1,500 S.F. L54
L28 L80
178) 1,500 S.F. L55
L27 L81
177) 2,612 S.F. L56
L26 L82
176) 2,612 S.F. L57
L25 L83
175) 1,500 S.F. L58
L24 L84
174) 1,500 S.F. L59
L23 L85
173) 1,500 S.F. L60
L22 L86
172) 2,612 S.F. L61
L21 L3 L63 L62

263.63'(TOTAL)

259.33'(TOTAL)

N 14°04'05" E

S 14°04'05" W

PRIVATE D.E.

COMMON AREA 3

WETLAND
(SEE NOTE #15)

13.5' PRIVATE LAKE MAINTENANCE EASEMENT & TOP BANK OF POND

POND D
34,802 S.F.

APPROXIMATE WATER LOCATION OF POND

13.5'

13.5'

706.00'

S 33°05'51" W

CROW CREEK GOLF GROUP, LLC
2250003602
D.B. 4314 PG. 792
P.B. 115 PG. 79

30'

N 14°04'05" E

30' PROPERTY BUFFER

116'

103.84'

N 14°04'05" E

66.82'

S 75°55'55" E

L2

10' PRIVATE D.E.

CALABASH POINTE
PHASE I

COMMON AREA I
MILLROSE PROPERTIES
NORTH CAROLINA, LLC
225EF00101
D.B. 5331, PG. 99
M.C. 177, PG. 27

13.5' PRIVATE LAKE MAINTENANCE EASEMENT & TOP BANK OF POND

APPROXIMATE WATER LOCATION OF POND

POND A

WETLAND
(SEE NOTE #15)

COMMON AREA 3

WETLAND
(SEE NOTE #15)

N: 67,266.49
E: 2,129,035.75

N 75°55'55" W

457.58'

CALABASH POINTE
PHASE 2

COMMON AREA 2
MILLROSE PROPERTIES
NORTH CAROLINA, LLC
225FJ00101

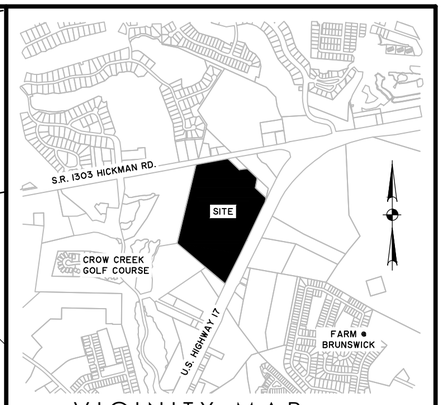

VICINITY MAP not to scale

This document and all reproducible copies of this document are the property of Thomas & Hutton. Reproduction of this document is not permitted without written consent of Thomas & Hutton unless this document becomes a matter of public record. ALTERATIONS TO THIS DOCUMENT ARE NOT PERMITTED.

NORTH CAROLINA
THOMAS & HUTTON ENGINEERING CO.
No. F-0871
CERTIFICATE OF AUTHORIZATION

NORTH CAROLINA
PROFESSIONAL
SEAL
L-5564
MATTHEW D. SVEJKOVSKY
LAND SURVEYOR

I, MATTHEW D. SVEJKOVSKY, CERTIFY THAT THIS PLAT WAS DRAWN FROM AN ACTUAL FIELD SURVEY UNDER MY SUPERVISION (DEED DESCRIPTION RECORDED IN D.B. 5331, PG. 99); THAT THE BOUNDARIES NOT SURVEYED ARE CLEARLY INDICATED AS DRAWN FROM INFORMATION FOUND IN DEED BOOK N/A, THAT THE RATIO OF PRECISION AS CALCULATED IS 1:10,000, AND THAT THIS PLAT WAS PREPARED IN ACCORDANCE WITH G.S. 47-30 AS AMENDED. WITNESS MY HAND AND SEAL THIS 26TH DAY OF MARCH 2026.

THIS SURVEY CREATES A SUBDIVISION OF LAND WITHIN AN AREA OF A COUNTY OR MUNICIPALITY THAT HAS AN ORDINANCE THAT REGULATES PARCELS OF LAND.

MATTHEW D. SVEJKOVSKY, N.C. PROFESSIONAL LAND SURVEYOR
LICENSE NO. L-5564

SUBDIVISION PLAT OF

CALABASH POINTE PHASE 3

SHALLOTTE TOWNSHIP
BRUNSWICK COUNTY, NORTH CAROLINA

prepared for
LENNAR CAROLINAS, LLC

No.	Revision	By	Date
1.	UPDATED FOR RECORDING	JED	6/12/26

THOMAS & HUTTON
611 Burroughs & Chapin Blvd. • Suite 202
Myrtle Beach, SC 29577 • 843.839-3545
www.thomasandhutton.com

60 0 60 120
1 INCH = 60 FEET

plat	drawn	reviewed	field	crew
8/7/2024	JED	MDS	1/24/2024	CDH

job 31725.0000s01(PH3)

Z:\31725\31725.0000\Survey\DWG\SUB PLATS\31725.0000s01(PH 3).dwg - Jan 12, 2026 - 8:13:19 AM

CURVE TABLE					
CURVE	RADIUS	LENGTH	CH BEARING	CH LENGTH	DELTA
C1	163.00'	56.11'	N 04°12'26" E	55.83'	19°43'17"
C2	237.00'	87.51'	S 03°29'24" W	87.01'	21°09'21"

LINE TABLE		
LINE	BEARING	LENGTH
L1	N 79°43'42" E	180.97'
L2	N 71°34'15" E	58.31'
L3	N 75°55'55" W	42.00'
L4	S 14°04'05" W	14.30'
L5	S 14°04'05" W	34.83'
L6	S 14°04'05" W	20.00'
L7	S 14°04'05" W	20.00'
L8	S 14°04'05" W	20.00'
L9	S 14°04'05" W	34.83'
L10	S 14°04'05" W	34.83'
L11	S 14°04'05" W	20.00'
L12	S 14°04'05" W	20.00'
L13	S 14°04'05" W	20.00'
L14	S 14°04'05" W	34.83'
L15	S 14°04'05" W	34.83'
L16	S 14°04'05" W	20.00'
L17	S 14°04'05" W	20.00'
L18	S 14°04'05" W	20.00'
L19	S 14°04'05" W	30.33'
L20	S 14°04'05" W	4.50'
L21	N 14°04'05" E	34.83'
L22	N 14°04'05" E	20.00'
L23	N 14°04'05" E	20.00'
L24	N 14°04'05" E	20.00'
L25	N 14°04'05" E	34.83'
L26	N 14°04'05" E	34.83'
L27	N 14°04'05" E	20.00'
L28	N 14°04'05" E	20.00'
L29	N 14°04'05" E	20.00'
L30	N 14°04'05" E	34.83'
L31	N 14°04'05" E	4.30'
L32	N 75°55'55" W	75.00'
L33	N 14°04'05" E	34.83'
L34	N 14°04'05" E	20.00'
L35	N 14°04'05" E	20.00'
L36	N 14°04'05" E	20.00'
L37	N 14°04'05" E	34.83'
L38	N 14°04'05" E	34.83'
L39	N 14°04'05" E	20.00'
L40	N 14°04'05" E	20.00'
L41	N 14°04'05" E	20.00'
L42	N 14°04'05" E	34.83'
L43	N 14°04'05" E	34.83'
L44	N 14°04'05" E	20.00'
L45	N 14°04'05" E	20.00'
L46	N 14°04'05" E	20.00'
L47	N 14°04'05" E	34.83'
L48	S 75°55'55" E	32.14'
L49	S 75°55'55" E	42.86'
L50	S 75°55'55" E	63.88'
L51	S 75°55'55" E	11.12'
L52	S 14°04'05" W	27.65'
L53	S 14°04'05" W	7.19'
L54	S 14°04'05" W	20.00'
L55	S 14°04'05" W	20.00'
L56	S 14°04'05" W	20.00'
L57	S 14°04'05" W	34.83'
L58	S 14°04'05" W	34.83'
L59	S 14°04'05" W	20.00'
L60	S 14°04'05" W	20.00'
L61	S 14°04'05" W	20.00'
L62	S 14°04'05" W	34.83'
L63	N 75°55'55" W	75.00'
L63	N 75°55'55" W	33.00'
L64	S 75°55'55" E	75.00'
L65	S 75°55'55" E	75.00'
L66	S 75°55'55" E	75.00'
L67	S 75°55'55" E	75.00'
L68	S 75°55'55" E	75.00'
L69	S 75°55'55" E	75.00'
L70	S 75°55'55" E	75.00'
L71	S 75°55'55" E	75.00'
L72	S 75°55'55" E	75.00'
L73	S 75°55'55" E	75.00'
L74	S 75°55'55" E	75.00'
L75	S 75°55'55" E	75.00'
L76	S 75°55'55" E	75.00'
L77	S 75°55'55" E	75.00'
L78	N 75°55'55" W	75.00'
L79	N 75°55'55" W	75.00'
L80	N 75°55'55" W	75.00'
L81	N 75°55'55" W	75.00'
L82	N 75°55'55" W	75.00'
L83	N 75°55'55" W	75.00'
L84	N 75°55'55" W	75.00'
L85	N 75°55'55" W	75.00'
L86	N 75°55'55" W	75.00'
L87	N 07°50'22" W	29.80'
L88	S 85°56'33" W	23.30'
L89	S 14°04'05" W	122.42'
L90	S 75°55'55" E	65.00'
L91	N 75°55'55" W	65.00'
L92	S 14°04'05" W	119.67'

CERTIFICATE OF OWNERSHIP AND DEDICATION

I (WE) HEREBY CERTIFY THAT I AM (WE ARE) THE OWNER(S) OF THE PROPERTY SHOWN AND DESCRIBED HEREON WHICH WAS CONVEYED TO ME (US) BY DEED RECORDED IN BOOK _____ , PAGE_____, AND THAT I (WE) HEREBY ADOPT THIS PLAN OF SUBDIVISION WITH MY (OUR) FREE CONSENT, ESTABLISH THE MINIMUM BUILDING LINES, AND DEDICATED ALL STREETS, ALLEYS, WALKS, PARKS, DRAINAGE-WAYS, AND OTHER OPEN SPACES TO PUBLIC OR PRIVATE USE AS NOTED. FURTHER, I (WE) CERTIFY THAT THE LAND AS SHOWN HEREON IS WITHIN THE SUBDIVISION REGULATION JURISDICTION OF BRUNSWICK COUNTY.

_____

OWNERS/DATE

CERTIFICATE OF APPROVAL FOR INSTALLED IMPROVEMENTS

THE UNDERSIGNED HEREBY CERTIFIES THAT THE REQUIRED IMPROVEMENTS

(_____)

HAVE BEEN INSTALLED IN AN ACCEPTABLE MATTER AND IN ACCORDANCE WITH THE REGULATIONS OF THE BRUNSWICK COUNTY ENGINEERING AND UTILITIES DEPARTMENTS AND ALL REQUIREMENTS OF THE BRUNSWICK COUNTY UNIFIED DEVELOPMENT ORDINANCE.

_____ _____

DEVELOPER OR AUTHORIZED AGENT SIGNATURE (S) DATE

_____ _____

BRUNSWICK COUNTY ENGINEERING DIRECTOR DATE

MAINTENANCE DISCLOSURE FOR PRIVATE SUBDIVISION/PD STREETS

I (WE), THE RESPONSIBLE PARTY(IES) OF _____

HEREBY STATE THAT THE SUBDIVISION STREETS IN _____ ARE PRIVATE STREETS. THESE ROAD(S) ARE TO BE PRIVATELY MAINTAINED AND SHALL NOT BE MAINTAINED BY THE NORTH CAROLINA DEPARTMENT OF TRANSPORTATION, BRUNSWICK COUNTY OR OTHER PUBLIC AGENCY. OWNERSHIP AND MAINTENANCE OF ALL PRIVATE STREETS IN THE AFOREMENTIONED MAJOR SUBDIVISION OR PLANNED DEVELOPMENT ARE THE RESPONSIBILITY OF

_____

_____ _____

DEVELOPER OR AUTHORIZED AGENT SIGNATURE (S) DATE

I, MATTHEW D. SVEJKOVSKY, CERTIFY THAT THIS MAP WAS DRAWN UNDER MY SUPERVISION FROM AN ACTUAL GPS (OR GNSS) SURVEY MADE UNDER UNDER MY SUPERVISION AND THE FOLLOWING INFORMATION WAS USED TO PERFORM THE SURVEY

CLASS OF SURVEY: (A)
POSITIONAL ACCURACY: 0.05
TYPE GPS (OR GNSS) FIELD PROCEDURE: FIELD PROCEDURE: RTN - BASE ROVER
DATE(S) OF SURVEY: JAN. 2024
DATUM/EPOCH: NAD 83(2011)/2010
PUBLISHED/FIXED CONTROL: 'GLEN' PID AJ4914 & 'WILSON' PID AJ4913
GEOID MODEL: 2018
COMBINED GRID FACTOR: 1.000140645
UNITS: U.S. SURVEY FEET

LOTS = 1.12 AC.
COMMON AREA = 8.60 AC.
TOTAL AREA = 9.72 AC.

REFERENCE MAPS:
1) "BOUNDARY SURVEY FOR BOSTIC DEVELOPMENT AT CROW CREEK, LLC" DATED DEC. 22, 2004 BY NORRIS & WARD LAND SURVEYORS, P.A. & RECORDED IN THE BRUNSWICK COUNTY R.O.D. OFFICE IN M.C. 31, PG. 403.
2) "BOUNDARY SURVEY FOR BENNETT COMMERCIAL PROPERTIES, LLC" DATED JUNE 16, 2015 BY NORRIS & WARD LAND SURVEYORS, P.A. & RECORDED IN THE BRUNSWICK COUNTY R.O.D. OFFICE IN M.C. 91, PG. 84.
3) "SURVEY FOR CROW CREEK GOLF GROUP, LLC" DATED JULY 28, 2019 BY NORRIS & WARD LAND SURVEYORS, P.A. & RECORDED IN THE BRUNSWICK COUNTY R.O.D. OFFICE IN M.C. 115, PG. 74.
4) "SURVEY FOR ELIZABETH LONG WILLIS" DATED NOV. 28, 1978 BY BOBBY M. LONG & RECORDED IN THE BRUNSWICK COUNTY R.O.D. OFFICE IN M.C. K, PG. 10.
5) "ALTA/NSPS LAND TITLE SURVEY OF 54.83 ACRES BEING THE LANDS OF DELANA W. HOLDEN; PREPARED FOR LENNAR CAROLINAS, LLC" DATED FEB. 21, 2024 BY THIS OFFICE.
6) "SUBDIVISION PLAT OF CALABASH POINTE PHASE 1; PREPARED FOR LENNAR CAROLINAS, LLC" DATED AUG. 1, 2024 BY THIS OFFICE & RECORDED IN THE BRUNSWICK COUNTY R.O.D. OFFICE IN M.C. 177, PG. 27.
7) "SUBDIVISION PLAT OF CALABASH POINTE PHASE 2; PREPARED FOR LENNAR CAROLINAS, LLC" DATED AUG. 5, 2024 BY THIS OFFICE & RECORDED IN THE BRUNSWICK COUNTY R.O.D. OFFICE IN M.C. 178, PG. 90.
8) "SUBDIVISION PLAT OF A PORTION OF THE LANDS OF DELANA W. HOLDEN TOTALING 0.69 AC.; PREPARED FOR LENNAR CAROLINAS, LLC" DATED DEC. 11, 2024 BY THIS OFFICE & RECORDED IN THE BRUNSWICK COUNTY R.O.D. OFFICE IN M.C. 183, PG. 3.

ENGINEERS' CERTIFICATE OF ROAD CONSTRUCTION

I (WE) HEREBY CERTIFY THAT ALL ROADS AS DEPICTED ON THIS SUBDIVISION PLAT HAVE BEEN DESIGNED AND INSTALLED IN ACCORDANCE WITH THE APPROVED PLANS PER SECTION 6.11.5.B. OF THE BRUNSWICK COUNTY UNIFIED DEVELOPMENT ORDINANCE.

_____ _____

PROFESSIONAL ENGINEER DATE

_____

REGISTRATION NUMBER

NORTH CAROLINA PROFESSIONAL SEAL 53169 ENGINEER NATHAN T. POUND

ELECTRICAL SERVICE CERTIFICATION

I (WE) HEREBY CERTIFY THAT ELECTRICAL SERVICE TO ALL LOTS AS DEPICTED ON THIS SUBDIVISION PLAT HAVE BEEN INSTALLED IN ACCORDANCE WITH THE UTILITY PROVIDER'S SPECIFICATIONS PER SECTION 3.3.3.B.16.ii. OF THE BRUNSWICK COUNTY UNIFIED DEVELOPMENT ORDINANCE.

_____ _____

DEVELOPER OF PROJECT MANAGER DATE

FLOODPLAIN ADMINISTRATOR CERTIFICATION

THE UNDERSIGNED HEREBY CERTIFIES THIS DOCUMENT/PROJECT HAS BEEN REVIEWED AND APPROVED FOR COMPLIANCE WITH THE BRUNSWICK COUNTY FLOOD DAMAGE PREVENTION ORDINANCE.

_____ _____

BRUNSWICK COUNTY FLOODPLAIN ADMINISTRATOR DATE

THE UNDERSIGNED HEREBY APPROVES THAT THE REQUIRED FIRE HYDRANT SYSTEM(S) HAVE BEEN TESTED IN ACCORDANCE WITH NFPA 291 IN AN ACCEPTABLE MANNER AND SUCH FIRE HYDRANT SYSTEM(S) LOCATED IN ACCORDANCE WITH THE NORTH CAROLINA FIRE PREVENTION CODE.

_____ _____

BRUNSWICK COUNTY FIRE CODE OFFICIAL DATE

STATE OF NORTH CAROLINA
COUNTY OF BRUNSWICK

I, _____, REVIEW OFFICER OF _____ COUNTY, CERTIFY THAT THE MAP OR PLAT TO WHICH THIS CERTIFICATION IS AFFIXED MEETS ALL STATUTORY REQUIREMENTS FOR RECORDING.

_____

REVIEW OFFICER

DATE _____

NOTES:
1) PARCEL ID NO.: 22500035.
2) THIS SURVEY IS VALID ONLY IF THE PRINT OF SAME HAS THE ORIGINAL SIGNATURE AND SEAL OF THE SURVEYOR.
3) A TITLE SEARCH WAS NOT PERFORMED BY THIS OFFICE ON THIS DATE.
4) THE PROPERTY PLATTED HEREON IS SUBJECT TO ALL EASEMENTS AND RESTRICTIONS OF RECORD.
5) THIS AREA IS LOCATED IN FLOOD ZONE "X" AS SHOWN ON PANEL NO. 3720102600K, DATED AUG. 28, 2018 -NATIONAL FLOOD INSURANCE PROGRAM FLOOD INSURANCE RATE MAP.
6) AREA COMPUTED BY CROSS COORDINATE MULTIPLICATION.
7) ALL BEARINGS AND COORDINATES SHOWN ARE BASED ON THE NORTH CAROLINA GRID SYSTEM NAD 83(2011).
8) THIS PROPERTY IS A PORTION OF THE PROPERTY DESCRIBED IN D.B. 5331, PG. 99.
9) PLAT REFERENCE: M.C K, PG. 10.
10) OWNER: MILLROSE PROPERTIES NORTH CAROLINA, LLC
5505 WATERFORD DISTRICT DR.
MIAMI, FL 33126
DEVELOPER: LENNAR CAROLINAS, LLC
1359 21ST AVE. NORTH SUITE 105
MYRTLE BEACH, SC 29577
11) MINIMUM BUILDING SETBACKS ARE:
FRONT: 10'
SIDE ROAD: 10'
SIDE: 0'
REAR: 10'
MIN. LOT SIZE
SINGLE FAMILY ATTACHED: 1,500 S.F.±
BUILDING HEIGHTS NOT TO EXCEED 35'
FFE SHALL BE A MINIMUM OF 1' ABOVE BACK OF CURB
TOTAL NUMBER OF LOTS: 25.
12) ALL PROPERTIES CREATED BY THIS SUBDIVISION ARE SUBJECT TO THE DECLARATION OF COVENANTS, CONDITIONS AND RESTRICTIONS FOR CALABASH POINTE RECORDED IN PLAT BOOK _____ , PAGE _____ , AT THE BRUNSWICK COUNTY REGISTER OF DEEDS OFFICE.
13) ROADS SHALL BE BUILT TO NCDOT SUBDIVISION STANDARDS.
14) SUBSURFACE AND ENVIRONMENTAL CONDITIONS WERE NOT EXAMINED OR CONSIDERED AN ELEMENT OF THIS SURVEY. NO STATEMENT IS MADE REGARDING THE EXISTENCE OF UNDERGROUND OR OVERHEAD CONTINGENCIES THAT MAY AFFECT THE USE OF THESE PARCELS.
15) WETLANDS SHOWN HAVE BEEN SUPPLIED BY THE BRIGMAN COMPANY PER DELINEATION DATED JAN. 25, 2024. WETLANDS HAVE NOT BEEN FIELD LOCATED BY THOMAS & HUTTON.

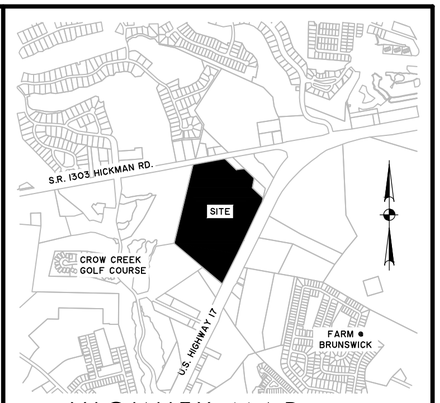

VICINITY MAP not to scale

This document and all reproducible copies of this document are the property of Thomas & Hutton. Reproduction of this document is not permitted without written consent of Thomas & Hutton unless this document becomes a matter of public record. ALTERATIONS TO THIS DOCUMENT ARE NOT PERMITTED.

NORTH CAROLINA THOMAS & HUTTON ENGINEERING CO. No. F-0871 CERTIFICATE OF AUTHORIZATION

NORTH CAROLINA PROFESSIONAL SEAL L-5564 LAND SURVEYOR MATTHEW D. SVEJKOVSKY

I, MATTHEW D. SVEJKOVSKY, CERTIFY THAT THIS PLAT WAS DRAWN FROM AN ACTUAL FIELD SURVEY UNDER MY SUPERVISION (DEED DESCRIPTION RECORDED IN D.B. 5331, PG. 99); THAT THE BOUNDARIES NOT SURVEYED ARE CLEARLY INDICATED AS DRAWN FROM INFORMATION FOUND IN DEED BOOK N/A, THAT THE RATIO OF PRECISION AS CALCULATED IS 1:10,000, AND THAT THIS PLAT WAS PREPARED IN ACCORDANCE WITH G.S. 47-30 AS AMENDED. WITNESS MY HAND AND SEAL THIS 26TH DAY OF MARCH 2026.

THIS SURVEY CREATES A SUBDIVISION OF LAND WITHIN AN AREA OF A COUNTY OR MUNICIPALITY THAT HAS AN ORDINANCE THAT REGULATES PARCELS OF LAND.

_____

MATTHEW D. SVEJKOVSKY, N.C. PROFESSIONAL LAND SURVEYOR
LICENSE NO. L-5564

SUBDIVISION PLAT OF

CALABASH POINTE PHASE 3

SHALLOTTE TOWNSHIP
BRUNSWICK COUNTY, NORTH CAROLINA

prepared for
LENNAR CAROLINAS, LLC

No.	Revision	By	Date
1.	UPDATED FOR RECORDING	JED	6/12/26

THOMAS & HUTTON

611 Burroughs & Chapin Blvd. • Suite 202
Myrtle Beach, SC 29577 • 843.839-3545

www.thomasandhutton.com

60 0 60 120
1 INCH = 60 FEET

plat	drawn	reviewed	field	crew
8/7/2024	JED	MDS	1/24/2024	CDH

Prepared by: St. Amand & Efird, PLLC
3315 Springbank Lane, Suite 308
Charlotte, NC 28226

STATE OF NORTH CAROLINA

COUNTY OF BRUNSWICK AFFIDAVIT

Lennar Carolinas, LLC, a Delaware limited liability company whose mailing address is 1505 King Street Extension, Suite 100, Charleston, SC 29405, hereinafter referred to as Affiant, being first duly sworn, hereby deposes and says under oath as follows:

1. That it is the developer of certain property located in Shallotte Township, Brunswick County, North Carolina, known as Calabash Pointe Phase 3 Subdivision, including a water lines, gravity sewer lines, and force main, as more particularly described in a Deed of Dedication in favor of Brunswick County of even date herewith.

2. That it has caused to be installed water distribution lines and sewer lines under and along the road rights-of-way property herein described and referenced:

> All of the water lines, gravity sewer lines, and force main and related and ancillary equipment to serve the Subdivision as shown on the survey maps attached hereto as **Exhibit "A"** for Calabash Pointe Phase 1 (herein, the "**Facilities**")

3. All the work which has been performed in the construction and installation of said water distribution lines and sewer lines described in paragraph 2, above, has been fully paid for and there are now no liens of any kind including any lien for labor or material against the subdivision property which would in any way jeopardize title of Affiant to the property in said subdivision nor are there any legal actions pending against Affiant or any contractor arising out of any work performed in said subdivision or the water

liens and sewer lines installed therein which would in any way jeopardize title to the subdivision or the water distribution lines and sewer lines located therein.

[SIGNATURE PAGE TO FOLLOW]

IN WITNESS WHEREOF, the Affiant has caused this instrument to be duly executed by its authorized officer(s), this _____ day of _____, 2026.

LENNAR CAROLINAS, LLC
a Delaware limited liability company

By: Earl Bailey
Name: Earl Bailey
Title: Vice President

STATE OF SOUTH CAROLINA

COUNTY OF HORRY

Signed and sworn to (or affirmed) before me this day by Earl Bailey Vice President of Lennar Carolinas, LLC, a Delaware limited liability company in the capacity and for the purposes herein indicated.

Date: 8-19-2026

(NOTARY SEAL)

Elizabeth Kane
Signature of Notary Public

Elizabeth Kane
Printed or Typed Name of Notary Public

My Commission Expires: 7-8-2036

Exhibit "A"

[SEE ATTACHED PAGES]

177 /27

MAP CABINET 177 PAGE 27 1 OF 4

4-2-26 JH

B0177 P0027 04-02-2026 13:02:09.000 PLAT
Brunswick County, NC Register of Deeds Dana Varnam page 1 of 4

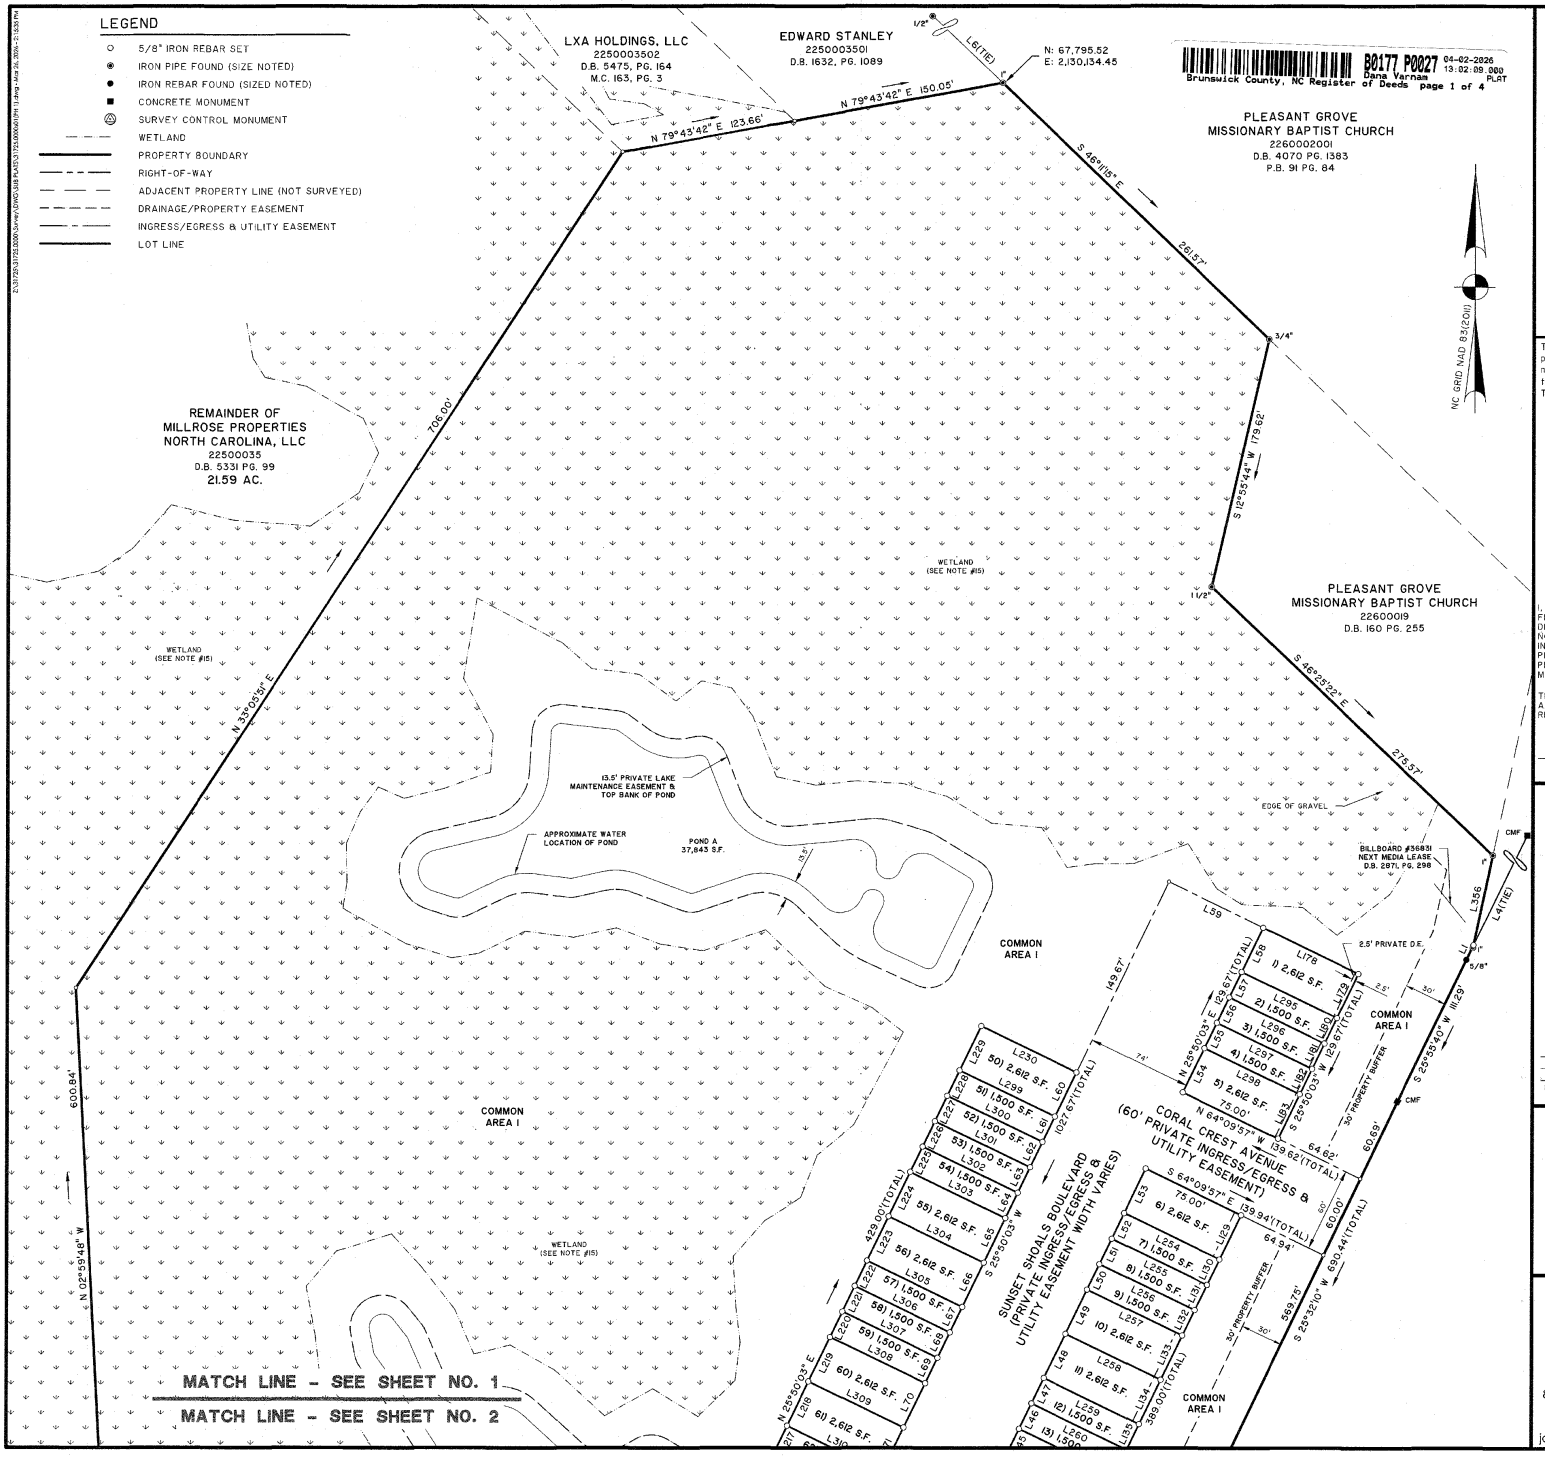

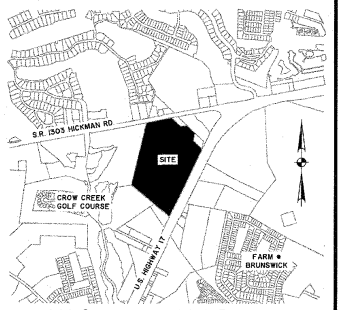

VICINITY MAP not to scale

This document and all reproducible copies of this document are the property of Thomas & Hutton. Reproduction of this document is not permitted without written consent of Thomas & Hutton unless this document becomes a matter of public record. ALTERATIONS TO THIS DOCUMENT ARE NOT PERMITTED.

NORTH CAROLINA THOMAS & HUTTON ENGINEERING CO. No. F-0871 CERTIFICATE OF AUTHORIZATION

NORTH CAROLINA PROFESSIONAL SEAL L-5564 LAND SURVEYOR MATTHEW D. SVEJKOVSKY

I, MATTHEW D. SVEJKOVSKY, CERTIFY THAT THIS PLAT WAS DRAWN FROM AN ACTUAL FIELD SURVEY UNDER MY SUPERVISION (DEED DESCRIPTION RECORDED IN D.B. 5331, PG. 99); THAT THE BOUNDARIES NOT SURVEYED ARE CLEARLY INDICATED AS DRAWN FROM INFORMATION FOUND IN DEED BOOK N/A; THAT THE RATIO OF PRECISION AS CALCULATED IS 1:10,000, AND THAT THIS PLAT WAS PREPARED IN ACCORDANCE WITH G.S. 47-30 AS AMENDED. WITNESS MY HAND AND SEAL THIS 26TH DAY OF MARCH 2026.

THIS SURVEY CREATES A SUBDIVISION OF LAND WITHIN AN AREA OF A COUNTY OR MUNICIPALITY THAT HAS AN ORDINANCE THAT REGULATES PARCELS OF LAND.

MD Svejkovsky 3/26/26

MATTHEW D. SVEJKOVSKY, NC PROFESSIONAL LAND SURVEYOR
LICENSE NO. L-5564

SUBDIVISION PLAT OF

CALABASH POINTE PHASE 1

SHALLOTTE TOWNSHIP
BRUNSWICK COUNTY, NORTH CAROLINA

prepared for
LENNAR CAROLINAS, LLC

No.	Revision	By	Date
2	UPDATED CERTS	JED	3/26/2026
1	UPDATED FOR RECORDING	JED	2/4/2026

THOMAS & HUTTON
611 Burroughs & Chapin Blvd. • Suite 202
Myrtle Beach, SC 29577 • 843.839-3545
www.thomasandhutton.com

60 0 60 120
1 INCH = 60 FEET

plat	drawn	reviewed	field	crew
8/1/2024	JED	MDS	1/24/2024	CDH

job 31725.0000s01(PH1) SHEET 1 OF 4

177 / 28

MAP CABINET 177 PAGE 28 2 OF 4 4-2-26 JH

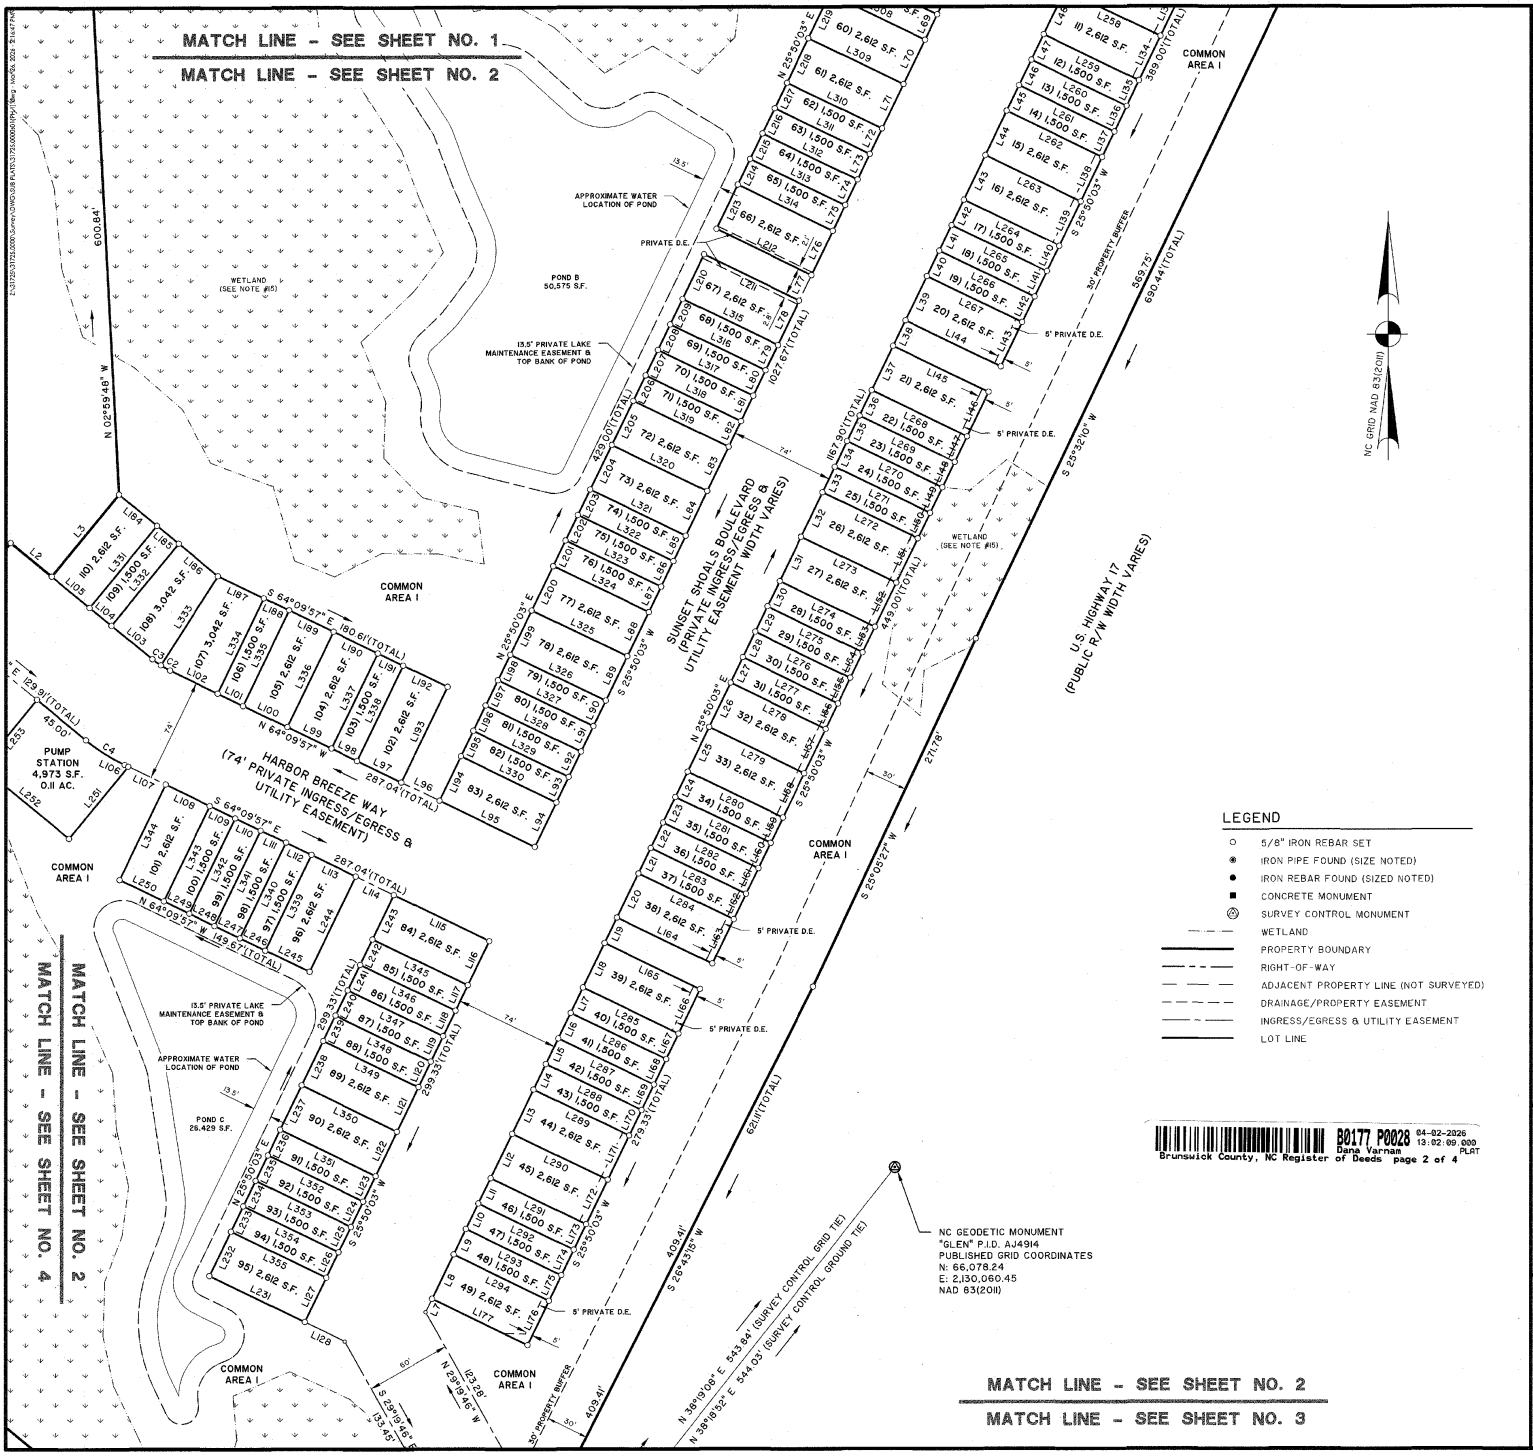

B0177 P0028 04-02-2026 13:02:09.000 PLAT
Brunswick County, NC Register of Deeds Dana Varnam page 2 of 4

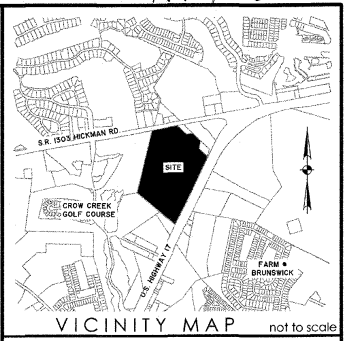

VICINITY MAP not to scale

This document and all reproducible copies of this document are the property of Thomas & Hutton. Reproduction of this document is not permitted without written consent of Thomas & Hutton unless this document becomes a matter of public record. ALTERATIONS TO THIS DOCUMENT ARE NOT PERMITTED.

NORTH CAROLINA THOMAS & HUTTON ENGINEERING CO. No. F-0871 CERTIFICATE OF AUTHORIZATION

NORTH CAROLINA PROFESSIONAL SEAL L-5564 LAND SURVEYOR MATTHEW D. SVEJKOVSKY

I, MATTHEW D. SVEJKOVSKY, CERTIFY THAT THIS PLAT WAS DRAWN FROM AN ACTUAL FIELD SURVEY UNDER MY SUPERVISION (DEED DESCRIPTION RECORDED IN D.B. 5351, PG. 99); THAT THE BOUNDARIES NOT SURVEYED ARE CLEARLY INDICATED AS DRAWN FROM INFORMATION FOUND IN DEED BOOK N/A; THAT THE RATIO OF PRECISION AS CALCULATED IS 1:10,000; AND THAT THIS PLAT WAS PREPARED IN ACCORDANCE WITH G.S. 47-30 AS AMENDED. WITNESS MY HAND AND SEAL THIS 26TH DAY OF MARCH 2026.

THIS SURVEY CREATES A SUBDIVISION OF LAND WITHIN AN AREA OF A COUNTY OR MUNICIPALITY THAT HAS AN ORDINANCE THAT REGULATES PARCELS OF LAND.

3/26/26
MATTHEW D. SVEJKOVSKY, N.C. PROFESSIONAL LAND SURVEYOR
LICENSE NO. L-5564

SUBDIVISION PLAT OF

CALABASH POINTE PHASE 1

SHALLOTTE TOWNSHIP
BRUNSWICK COUNTY, NORTH CAROLINA

prepared for
LENNAR CAROLINAS, LLC

No.	Revision	By	Date
2	UPDATED CERTS	JED	3/26/2026
1	UPDATED FOR RECORDING	JED	2/4/2026

THOMAS & HUTTON
611 Burroughs & Chapin Blvd. • Suite 202
Myrtle Beach, SC 29577 • 843.839-3545
www.thomasandhutton.com

60 0 60 120
1 INCH = 60 FEET

plat	drawn	reviewed	field	crew
8/1/2024	JED	MDS	1/24/2024	CDH

job 31725.0000s01(PH1) SHEET 2 OF 4

177 / 29

MAP CABINET 177 PAGE 29 3 of 4 4-2-26 JH

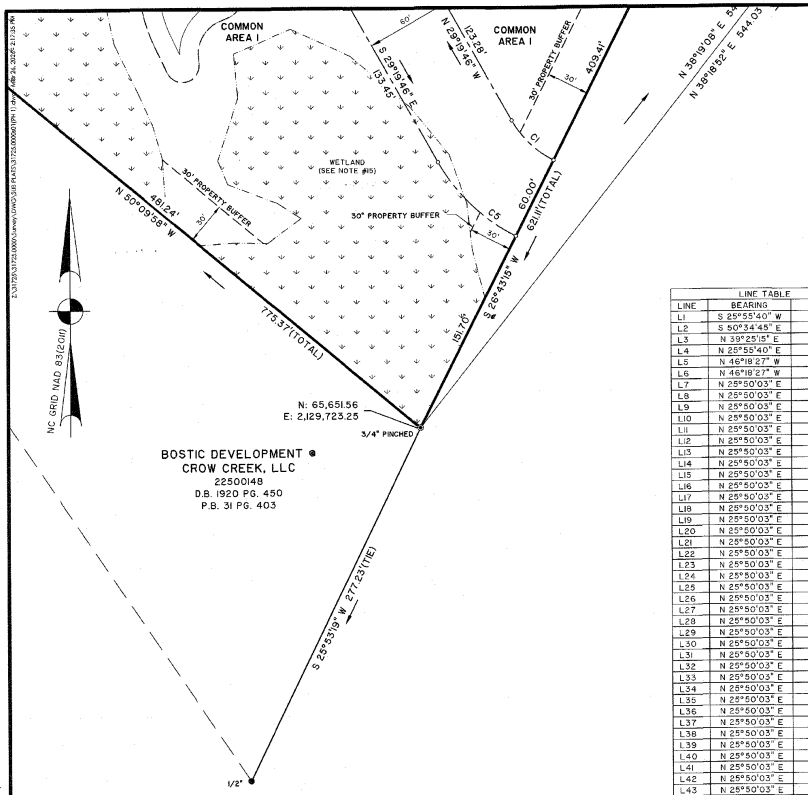

MATCH LINE - SEE SHEET NO. 2

MATCH LINE - SEE SHEET NO. 3

B0177 P0029 04-02-2026 13:02:09.000
Dana Varnam PLAT
Brunswick County, NC Register of Deeds page 3 of 4

LEGEND

- ○ 5/8" IRON REBAR SET
- ◉ IRON PIPE FOUND (SIZE NOTED)
- ● IRON REBAR FOUND (SIZED NOTED)
- ■ CONCRETE MONUMENT
- ⊛ SURVEY CONTROL MONUMENT
- WETLAND
- PROPERTY BOUNDARY
- RIGHT-OF-WAY
- ADJACENT PROPERTY LINE (NOT SURVEYED)
- DRAINAGE/PROPERTY EASEMENT
- INGRESS/EGRESS & UTILITY EASEMENT
- LOT LINE

CURVE TABLE

CURVE	RADIUS	LENGTH	CH BEARING	CH LENGTH	DELTA
C1	70.00'	41.48'	N 46°18'16" W	40.87'	33°56'59"
C2	63.00'	7.47'	N 60°46'09" W	7.47'	6°47'36"
C3	63.00'	7.47'	N 53°58'33" W	7.47'	6°47'36"
C4	137.00'	32.49'	S 57°22'21" E	32.41'	13°35'12"
C5	130.00'	77.03'	S 46°18'16" E	75.91'	33°56'59"

LINE TABLE

LINE	BEARING	LENGTH
L1	S 25°55'40" W	11.54'
L2	S 50°34'45" E	37.54'
L3	N 39°25'15" E	75.00'
L4	N 25°55'40" E	506.92'
L5	N 46°18'27" W	300.01'
L6	N 46°18'27" W	300.01'
L7	N 25°50'03" E	10.56'
L8	N 25°50'03" E	34.83'
L9	N 25°50'03" E	20.00'
L10	N 25°50'03" E	20.00'
L11	N 25°50'03" E	20.00'
L12	N 25°50'03" E	34.83'
L13	N 25°50'03" E	34.83'
L14	N 25°50'03" E	20.00'
L15	N 25°50'03" E	20.00'
L16	N 25°50'03" E	20.00'
L17	N 25°50'03" E	20.00'
L18	N 25°50'03" E	34.83'
L19	N 25°50'03" E	20.00'
L20	N 25°50'03" E	34.83'
L21	N 25°50'03" E	20.00'
L22	N 25°50'03" E	20.00'
L23	N 25°50'03" E	20.00'
L24	N 25°50'03" E	20.00'
L25	N 25°50'03" E	34.83'
L26	N 25°50'03" E	34.83'
L27	N 25°50'03" E	20.00'
L28	N 25°50'03" E	20.00'
L29	N 25°50'03" E	20.00'
L30	N 25°50'03" E	20.00'
L31	N 25°50'03" E	34.83'
L32	N 25°50'03" E	34.83'
L33	N 25°50'03" E	20.00'
L34	N 25°50'03" E	20.00'
L35	N 25°50'03" E	20.00'
L36	N 25°50'03" E	20.00'
L37	N 25°50'03" E	34.83'
L38	N 25°50'03" E	20.00'
L39	N 25°50'03" E	34.83'
L40	N 25°50'03" E	20.00'
L41	N 25°50'03" E	20.00'
L42	N 25°50'03" E	20.00'
L43	N 25°50'03" E	34.83'
L44	N 25°50'03" E	34.83'
L45	N 25°50'03" E	20.00'
L46	N 25°50'03" E	20.00'
L47	N 25°50'03" E	20.00'
L48	N 25°50'03" E	34.83'
L49	N 25°50'03" E	34.83'
L50	N 25°50'03" E	20.00'
L51	N 25°50'03" E	20.00'
L52	N 25°50'03" E	20.00'
L53	N 25°50'03" E	34.83'
L54	N 25°50'03" E	34.83'
L55	N 25°50'03" E	20.00'
L56	N 25°50'03" E	20.00'
L57	N 25°50'03" E	20.00'
L58	N 25°50'03" E	34.83'
L59	N 64°09'57" W	74.00'
L60	S 25°50'03" W	34.83'
L61	S 25°50'03" W	20.00'
L62	S 25°50'03" W	20.00'
L63	S 25°50'03" W	20.00'
L64	S 25°50'03" W	20.00'
L65	S 25°50'03" W	34.83'
L66	S 25°50'03" W	34.83'
L67	S 25°50'03" W	20.00'
L68	S 25°50'03" W	20.00'
L69	S 25°50'03" W	20.00'
L70	S 25°50'03" W	34.83'
L71	S 25°50'03" W	34.83'
L72	S 25°50'03" W	20.00'
L73	S 25°50'03" W	20.00'
L74	S 25°50'03" W	20.00'
L75	S 25°50'03" W	20.00'
L76	S 25°50'03" W	34.83'
L77	S 25°50'03" W	20.00'
L78	S 25°50'03" W	34.83'
L79	S 25°50'03" W	20.00'
L80	S 25°50'03" W	20.00'
L81	S 25°50'03" W	20.00'
L82	S 25°50'03" W	20.00'
L83	S 25°50'03" W	34.83'
L84	S 25°50'03" W	34.83'
L85	S 25°50'03" W	20.00'
L86	S 25°50'03" W	20.00'
L87	S 25°50'03" W	20.00'
L88	S 25°50'03" W	34.83'
L89	S 25°50'03" W	34.83'
L90	S 25°50'03" W	20.00'
L91	S 25°50'03" W	20.00'
L92	S 25°50'03" W	20.00'
L93	S 25°50'03" W	20.00'
L94	S 25°50'03" W	34.83'
L95	N 64°09'57" W	75.00'
L96	N 64°09'57" W	30.00'
L97	N 64°09'57" W	34.83'
L98	N 64°09'57" W	20.00'
L99	N 64°09'57" W	34.83'
L100	N 64°09'57" W	34.83'

LINE TABLE

LINE	BEARING	LENGTH
L101	N 64°09'57" W	20.00'
L102	N 64°09'57" W	37.54'
L103	N 50°34'45" W	37.54'
L104	N 50°34'45" W	20.00'
L105	N 50°34'45" W	34.83'
L106	S 64°09'57" E	2.90'
L107	S 64°09'57" E	29.47'
L108	S 64°09'57" E	34.83'
L109	S 64°09'57" E	20.00'
L110	S 64°09'57" E	20.00'
L111	S 64°09'57" E	20.00'
L112	S 64°09'57" E	20.00'
L113	S 64°09'57" E	34.83'
L114	S 64°09'57" E	30.00'
L115	S 64°09'57" E	75.00'
L116	S 25°50'03" W	34.83'
L117	S 25°50'03" W	20.00'
L118	S 25°50'03" W	20.00'
L119	S 25°50'03" W	20.00'
L120	S 25°50'03" W	20.00'
L121	S 25°50'03" W	34.83'
L122	S 25°50'03" W	34.83'
L123	S 25°50'03" W	20.00'
L124	S 25°50'03" W	20.00'
L125	S 25°50'03" W	20.00'
L126	S 25°50'03" W	20.00'
L127	S 25°50'03" W	34.83'
L128	S 64°09'57" E	31.38'
L129	S 25°50'03" W	34.83'
L130	S 25°50'03" W	20.00'
L131	S 25°50'03" W	20.00'
L132	S 25°50'03" W	20.00'
L133	S 25°50'03" W	34.83'
L134	S 25°50'03" W	34.83'
L135	S 25°50'03" W	20.00'
L136	S 25°50'03" W	20.00'
L137	S 25°50'03" W	20.00'
L138	S 25°50'03" W	34.83'
L139	S 25°50'03" W	34.83'
L140	S 25°50'03" W	20.00'
L141	S 25°50'03" W	20.00'
L142	S 25°50'03" W	20.00'
L143	S 25°50'03" W	34.83'
L144	N 64°09'57" W	75.00'
L145	S 64°09'57" E	75.00'
L146	S 25°50'03" W	34.83'
L147	S 25°50'03" W	20.00'
L148	S 25°50'03" W	20.00'
L149	S 25°50'03" W	20.00'
L150	S 25°50'03" W	20.00'
L151	S 25°50'03" W	34.83'
L152	S 25°50'03" W	34.83'
L153	S 25°50'03" W	20.00'
L154	S 25°50'03" W	20.00'
L155	S 25°50'03" W	20.00'
L156	S 25°50'03" W	20.00'
L157	S 25°50'03" W	34.83'
L158	S 25°50'03" W	34.83'
L159	S 25°50'03" W	20.00'
L160	S 25°50'03" W	20.00'
L161	S 25°50'03" W	20.00'
L162	S 25°50'03" W	20.00'
L163	S 25°50'03" W	34.83'
L164	N 64°09'57" W	75.00'
L165	S 64°09'57" E	75.00'
L166	S 25°50'03" W	34.83'
L167	S 25°50'03" W	20.00'
L168	S 25°50'03" W	20.00'
L169	S 25°50'03" W	20.00'
L170	S 25°50'03" W	20.00'
L171	S 25°50'03" W	34.83'
L172	S 25°50'03" W	34.83'
L173	S 25°50'03" W	20.00'
L174	S 25°50'03" W	20.00'
L175	S 25°50'03" W	20.00'
L176	S 25°50'03" W	34.83'
L177	N 64°09'57" W	75.00'
L178	S 64°09'57" E	75.00'
L179	S 25°50'03" W	34.83'
L180	S 25°50'03" W	20.00'
L181	S 25°50'03" W	20.00'
L182	S 25°50'03" W	20.00'
L183	S 25°50'03" W	34.83'
L184	S 50°34'45" E	34.83'
L185	S 50°34'45" E	20.00'
L186	S 50°34'45" E	36.11'
L187	S 64°09'57" E	36.11'
L188	S 64°09'57" E	20.00'
L189	S 64°09'57" E	34.83'
L190	S 64°09'57" E	34.83'
L191	S 64°09'57" E	20.00'
L192	S 64°09'57" E	34.83'
L193	S 25°50'03" W	75.00'
L194	N 25°50'03" E	34.83'
L195	N 25°50'03" E	20.00'
L196	N 25°50'03" E	20.00'
L197	N 25°50'03" E	20.00'
L198	N 25°50'03" E	20.00'
L199	N 25°50'03" E	34.83'
L200	N 25°50'03" E	34.83'

LINE TABLE

LINE	BEARING	LENGTH
L201	N 25°50'03" E	20.00'
L202	N 25°50'03" E	20.00'
L203	N 25°50'03" E	20.00'
L204	N 25°50'03" E	34.83'
L205	N 25°50'03" E	34.83'
L206	N 25°50'03" E	20.00'
L207	N 25°50'03" E	20.00'
L208	N 25°50'03" E	20.00'
L209	N 25°50'03" E	20.00'
L210	N 25°50'03" E	34.83'
L211	S 64°09'57" E	75.00'
L212	N 64°09'57" W	75.00'
L213	N 25°50'03" E	34.83'
L214	N 25°50'03" E	20.00'
L215	N 25°50'03" E	20.00'
L216	N 25°50'03" E	20.00'
L217	N 25°50'03" E	20.00'
L218	N 25°50'03" E	34.83'
L219	N 25°50'03" E	34.83'
L220	N 25°50'03" E	20.00'
L221	N 25°50'03" E	20.00'
L222	N 25°50'03" E	20.00'
L223	N 25°50'03" E	34.83'
L224	N 25°50'03" E	34.83'
L225	N 25°50'03" E	20.00'
L226	N 25°50'03" E	20.00'
L227	N 25°50'03" E	20.00'
L228	N 25°50'03" E	20.00'
L229	N 25°50'03" E	34.83'
L230	S 64°09'57" E	75.00'
L231	N 64°09'57" W	75.00'
L232	N 25°50'03" E	34.83'
L233	N 25°50'03" E	20.00'
L234	N 25°50'03" E	20.00'
L235	N 25°50'03" E	20.00'
L236	N 25°50'03" E	20.00'
L237	N 25°50'03" E	34.83'
L238	N 25°50'03" E	34.83'
L239	N 25°50'03" E	20.00'
L240	N 25°50'03" E	20.00'
L241	N 25°50'03" E	20.00'
L242	N 25°50'03" E	20.00'
L243	N 25°50'03" E	34.83'
L244	S 25°50'03" W	75.00'
L245	N 64°09'57" W	34.83'
L246	N 64°09'57" W	20.00'
L247	N 64°09'57" W	20.00'
L248	N 64°09'57" W	20.00'
L249	N 64°09'57" W	20.00'
L250	N 64°09'57" W	34.83'
L251	S 39°25'15" W	66.01'
L252	N 50°34'45" W	80.00'
L253	N 39°25'15" E	61.50'
L254	N 64°09'57" W	75.00'
L255	N 64°09'57" W	75.00'
L256	N 64°09'57" W	75.00'
L257	N 64°09'57" W	75.00'
L258	N 64°09'57" W	75.00'
L259	N 64°09'57" W	75.00'
L260	N 64°09'57" W	75.00'
L261	N 64°09'57" W	75.00'
L262	N 64°09'57" W	75.00'
L263	N 64°09'57" W	75.00'
L264	N 64°09'57" W	75.00'
L265	N 64°09'57" W	75.00'
L266	N 64°09'57" W	75.00'
L267	N 64°09'57" W	75.00'
L268	N 64°09'57" W	75.00'
L269	N 64°09'57" W	75.00'
L270	N 64°09'57" W	75.00'
L271	N 64°09'57" W	75.00'
L272	N 64°09'57" W	75.00'
L273	N 64°09'57" W	75.00'
L274	N 64°09'57" W	75.00'
L275	N 64°09'57" W	75.00'
L276	N 64°09'57" W	75.00'
L277	N 64°09'57" W	75.00'
L278	N 64°09'57" W	75.00'
L279	N 64°09'57" W	75.00'
L280	N 64°09'57" W	75.00'
L281	N 64°09'57" W	75.00'
L282	N 64°09'57" W	75.00'
L283	N 64°09'57" W	75.00'
L284	N 64°09'57" W	75.00'
L285	N 64°09'57" W	75.00'
L286	N 64°09'57" W	75.00'
L287	N 64°09'57" W	75.00'
L288	N 64°09'57" W	75.00'
L289	N 64°09'57" W	75.00'
L290	N 64°09'57" W	75.00'
L291	N 64°09'57" W	75.00'
L292	N 64°09'57" W	75.00'
L293	N 64°09'57" W	75.00'
L294	N 64°09'57" W	75.00'
L295	N 64°09'57" W	75.00'
L296	N 64°09'57" W	75.00'
L297	N 64°09'57" W	75.00'
L298	N 64°09'57" W	75.00'
L299	S 64°09'57" E	75.00'
L300	S 64°09'57" E	75.00'

LINE TABLE

LINE	BEARING	LENGTH
L301	S 64°09'57" E	75.00'
L302	S 64°09'57" E	75.00'
L303	S 64°09'57" E	75.00'
L304	S 64°09'57" E	75.00'
L305	S 64°09'57" E	75.00'
L306	S 64°09'57" E	75.00'
L307	S 64°09'57" E	75.00'
L308	S 64°09'57" E	75.00'
L309	S 64°09'57" E	75.00'
L310	S 64°09'57" E	75.00'
L311	S 64°09'57" E	75.00'
L312	S 64°09'57" E	75.00'
L313	S 64°09'57" E	75.00'
L314	S 64°09'57" E	75.00'
L315	S 64°09'57" E	75.00'
L316	S 64°09'57" E	75.00'
L317	S 64°09'57" E	75.00'
L318	S 64°09'57" E	75.00'
L319	S 64°09'57" E	75.00'
L320	S 64°09'57" E	75.00'
L321	S 64°09'57" E	75.00'
L322	S 64°09'57" E	75.00'
L323	S 64°09'57" E	75.00'
L324	S 64°09'57" E	75.00'
L325	S 64°09'57" E	75.00'
L326	S 64°09'57" E	75.00'
L327	S 64°09'57" E	75.00'
L328	S 64°09'57" E	75.00'
L329	S 64°09'57" E	75.00'
L330	S 64°09'57" E	75.00'
L331	S 39°25'15" W	75.00'
L332	N 25°50'03" E	75.00'
L333	S 32°37'39" W	75.08'
L334	S 25°50'03" W	75.00'
L335	S 25°50'03" W	75.00'
L336	S 25°50'03" W	75.00'
L337	S 25°50'03" W	75.00'
L338	S 25°50'03" W	75.00'
L339	N 25°50'03" E	75.00'
L340	N 25°50'03" E	75.00'
L341	N 25°50'03" E	75.00'
L342	N 25°50'03" E	75.00'
L343	N 25°50'03" E	75.00'
L344	N 25°50'03" E	75.00'
L345	S 64°09'57" E	75.00'
L346	S 64°09'57" E	75.00'
L347	S 64°09'57" E	75.00'
L348	S 64°09'57" E	75.00'
L349	S 64°09'57" E	75.00'
L350	S 64°09'57" E	75.00'
L351	S 64°09'57" E	75.00'
L352	S 64°09'57" E	75.00'
L353	S 64°09'57" E	75.00'
L354	S 64°09'57" E	75.00'
L355	S 64°09'57" E	75.00'
L356	S 12°01'42" W	64.87'

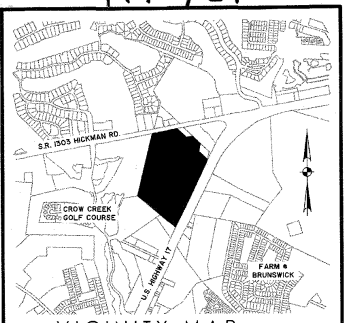

VICINITY MAP not to scale

This document and all reproducible copies of this document are the property of Thomas & Hutton. Reproduction of this document is not permitted without written consent of Thomas & Hutton unless this document becomes a matter of public record. ALTERATIONS TO THIS DOCUMENT ARE NOT PERMITTED.

NORTH CAROLINA THOMAS & HUTTON ENGINEERING CO. No. F-0871 CERTIFICATE OF AUTHORIZATION

NORTH CAROLINA PROFESSIONAL SEAL L-5564 LAND SURVEYOR MATTHEW D. SVEJKOVSKY

I, MATTHEW D. SVEJKOVSKY, CERTIFY THAT THIS PLAT WAS DRAWN FROM AN ACTUAL FIELD SURVEY UNDER MY SUPERVISION (DEED DESCRIPTION RECORDED IN D.B. 5331, PG. 99); THAT THE BOUNDARIES NOT SURVEYED ARE CLEARLY INDICATED AS DRAWN FROM INFORMATION FOUND IN DEED BOOK N/A; THAT THE RATIO OF PRECISION AS CALCULATED IS 1:10,000; AND THAT THIS PLAT WAS PREPARED IN ACCORDANCE WITH G.S. 47-30 AS AMENDED. WITNESS MY HAND AND SEAL THIS 26TH DAY OF MARCH 2026.

THIS SURVEY CREATES A SUBDIVISION OF LAND WITHIN AN AREA OF A COUNTY OR MUNICIPALITY THAT HAS AN ORDINANCE THAT REGULATES PARCELS OF LAND.

Matthew D Svejkovsky 3/26/26

MATTHEW D. SVEJKOVSKY, NC PROFESSIONAL LAND SURVEYOR
LICENSE NO. L-5564

SUBDIVISION PLAT OF

CALABASH POINTE PHASE 1

SHALLOTTE TOWNSHIP
BRUNSWICK COUNTY, NORTH CAROLINA

prepared for
LENNAR CAROLINAS, LLC

No.	Revision	By	Date
2	UPDATED CERTS	JED	3/26/2026
1	UPDATED FOR RECORDING	JED	2/4/2026

THOMAS & HUTTON
611 Burroughs & Chapin Blvd. • Suite 202
Myrtle Beach, SC 29577 • 843.839-3545
www.thomasandhutton.com

60 0 60 120
1 INCH = 60 FEET

plat	drawn	reviewed	field	crew
8/1/2024	JED	MDS	1/24/2024	CDH

job 31725.0000s01(PH1) SHEET 3 OF 4

177 / 30

MAP CABINET 177 PAGE 30 4 OF 4 4-2-26 JH

ENGINEERS' CERTIFICATE OF ROAD CONSTRUCTION

I (WE) HEREBY CERTIFY THAT ALL ROADS AS DEPICTED ON THIS SUBDIVISION PLAT HAVE BEEN DESIGNED AND INSTALLED IN ACCORDANCE WITH THE APPROVED PLANS PER SECTION 6.II.5.B. OF THE BRUNSWICK COUNTY UNIFIED DEVELOPMENT ORDINANCE.

PROFESSIONAL ENGINEER — DATE 3/26/26

53169
REGISTRATION NUMBER

NORTH CAROLINA PROFESSIONAL SEAL 53169 ENGINEER NATHAN T. POUND

ELECTRICAL SERVICE CERTIFICATION

I (WE) HEREBY CERTIFY THAT ELECTRICAL SERVICE TO ALL LOTS AS DEPICTED ON THIS SUBDIVISION PLAT HAVE BEEN INSTALLED IN ACCORDANCE WITH THE UTILITY PROVIDER'S SPECIFICATIONS PER SECTION 3.3.3.B.I6.ii. OF THE BRUNSWICK COUNTY UNIFIED DEVELOPMENT ORDINANCE.

Earl Bass — 3/27/2026
DEVELOPER OF PROJECT MANAGER — DATE

FLOODPLAIN ADMINISTRATOR CERTIFICATION

THE UNDERSIGNED HEREBY CERTIFIES THIS DOCUMENT/PROJECT HAS BEEN REVIEWED AND APPROVED FOR COMPLIANCE WITH THE BRUNSWICK COUNTY FLOOD DAMAGE PREVENTION ORDINANCE.

3/31/26
BRUNSWICK COUNTY FLOODPLAIN ADMINISTRATOR — DATE

CERTIFIED FLOODPLAIN CFM® STEFFAN R. TAUBE NC-22-0870 MANAGER

THE UNDERSIGNED HEREBY APPROVES THAT THE REQUIRED FIRE HYDRANT SYSTEM(S) HAVE BEEN TESTED IN ACCORDANCE WITH NFPA 291 IN AN ACCEPTABLE MANNER AND SUCH FIRE HYDRANT SYSTEM(S) LOCATED IN ACCORDANCE WITH THE NORTH CAROLINA FIRE PREVENTION CODE.

3-31-2026
BRUNSWICK COUNTY FIRE CODE OFFICIAL — DATE

CERTIFICATE OF OWNERSHIP AND DEDICATION

I (WE) HEREBY CERTIFY THAT I AM (WE ARE) THE OWNER(S) OF THE PROPERTY SHOWN AND DESCRIBED HEREON WHICH WAS CONVEYED TO ME (US) BY DEED RECORDED IN BOOK _____, PAGE _____, AND THAT I (WE) HEREBY ADOPT THIS PLAN OF SUBDIVISION WITH MY (OUR) FREE CONSENT, ESTABLISH THE MINIMUM BUILDING LINES, AND DEDICATED ALL STREETS, ALLEYS, WALKS, PARKS, DRAINAGE-WAYS, AND OTHER OPEN SPACES TO PUBLIC OR PRIVATE USE AS NOTED. FURTHER, I (WE) CERTIFY THAT THE LAND AS SHOWN HEREON IS WITHIN THE SUBDIVISION REGULATION JURISDICTION OF BRUNSWICK COUNTY.

Earl Bass — 3/27/2026
OWNERS/DATE

CERTIFICATE OF APPROVAL FOR INSTALLED IMPROVEMENTS

water, sewer, stormwater, roads

THE UNDERSIGNED HEREBY CERTIFIES THAT THE REQUIRED IMPROVEMENTS (Lennar Carolinas, LLC) HAVE BEEN INSTALLED IN AN ACCEPTABLE MATTER AND IN ACCORDANCE WITH THE REGULATIONS OF THE BRUNSWICK COUNTY ENGINEERING AND UTILITIES DEPARTMENTS AND ALL REQUIREMENTS OF THE BRUNSWICK COUNTY UNIFIED DEVELOPMENT ORDINANCE.

Earl Bass — 3/27/2026
DEVELOPER OR AUTHORIZED AGENT SIGNATURE (S) — DATE

Brigit Flora — 3/31/26
BRUNSWICK COUNTY ENGINEERING DIRECTOR — DATE

MAINTENANCE DISCLOSURE FOR PRIVATE SUBDIVISION/PD STREETS

I (WE), THE RESPONSIBLE PARTY(IES) OF Lennar Carolinas, LLC HEREBY STATE THAT THE SUBDIVISION STREETS IN Calabash Pointe Phase 1 ARE PRIVATE STREETS. THESE ROAD(S) ARE TO BE PRIVATELY MAINTAINED AND SHALL NOT BE MAINTAINED BY THE NORTH CAROLINA DEPARTMENT OF TRANSPORTATION, BRUNSWICK COUNTY OR OTHER PUBLIC AGENCY. OWNERSHIP AND MAINTENANCE OF ALL PRIVATE STREETS IN THE AFOREMENTIONED MAJOR SUBDIVISION OR PLANNED DEVELOPMENT ARE THE RESPONSIBILITY OF

Lennar Carolinas, LLC

Earl Bass — 3/27/2026
DEVELOPER OR AUTHORIZED AGENT SIGNATURE (S) — DATE

STATE OF NORTH CAROLINA COUNTY OF BRUNSWICK

I, M. Pages REVIEW OFFICER OF Brunswick COUNTY, CERTIFY THAT THE MAP OR PLAT TO WHICH THIS CERTIFICATION IS AFFIXED MEETS ALL STATUTORY REQUIREMENTS FOR RECORDING.

M. Pages
REVIEW OFFICER

DATE 4/2/26

APPROVED OLD RUSTED
Planned Development/Major Subdivision/ Major Site Plan
Case#: _____
M. Pages
Planning Director or Designee
Date: 4/2/26

REFERENCE MAPS:
1) "BOUNDARY SURVEY FOR BOSTIC DEVELOPMENT AT CROW CREEK, LLC" DATED DEC. 22, 2004 BY NORRIS & WARD LAND SURVEYORS, P.A. & RECORDED IN THE BRUNSWICK COUNTY R.O.D. OFFICE IN M.C. 31, PG. 403.
2) "BOUNDARY SURVEY FOR BENNETT COMMERCIAL PROPERTIES, LLC" DATED JUNE. 16, 2015 BY NORRIS & WARD LAND SURVEYORS, P.A. & RECORDED IN THE BRUNSWICK COUNTY R.O.D. OFFICE IN M.C. 91, PG. 84.
3) "SURVEY FOR CROW CREEK GOLF GROUP, LLC" DATED JULY 28, 2019 BY NORRIS & WARD LAND SURVEYORS, P.A. & RECORDED IN THE BRUNSWICK COUNTY R.O.D. OFFICE IN M.C. 85, PG. 74.
4) "SURVEY FOR ELIZABETH LONG WILLIS" DATED NOV. 28, 1978 BY BOBBY M. LONG & RECORDED IN THE BRUNSWICK COUNTY R.O.D. OFFICE IN M.C. K, PG. 10.
5) "ALTA/NSPS LAND TITLE SURVEY OF 54.83 ACRES BEING THE LANDS OF DELAN... ... ... LLC" DATED FEB. 21, 2024 BY THIS OFFICE.
6) "SUBDIVISION PLAT OF A PORTION OF THE LANDS OF DELANA W. HOLDEN TOTALING 0.69 AC.; PREPARED FOR LENNAR CAROLINAS, LLC" DATED DEC. 11, 2024 BY THIS OFFICE & RECORDED IN THE BRUNSWICK COUNTY R.O.D. OFFICE IN M.C. 163, PG. 3.

NOTES:
1) PARCEL ID NO.: 22500035.
2) THIS SURVEY IS VALID ONLY IF THE PRINT OF SAME HAS THE ORIGINAL SIGNATURE AND SEAL OF THE SURVEYOR.
3) A TITLE SEARCH WAS NOT PERFORMED BY THIS OFFICE ON THIS DATE.
4) THE PROPERTY PLATTED HEREON IS SUBJECT TO ALL EASEMENTS AND RESTRICTIONS OF RECORD.
5) THIS AREA IS LOCATED IN FLOOD ZONE "X" AS SHOWN ON PANEL NO. 3720102600K, DATED AUG. 28, 2018 -NATIONAL FLOOD INSURANCE PROGRAM FLOOD INSURANCE RATE MAP.
6) AREA COMPUTED BY CROSS COORDINATE MULTIPLICATION.
7) ALL BEARINGS AND COORDINATES SHOWN ARE BASED ON THE NORTH CAROLINA GRID SYSTEM NAD 83(2011).
8) THIS PROPERTY IS A PORTION OF THE PROPERTY DESCRIBED IN D.B. 5331, PG. 99.
9) PLAT REFERENCE: M.C K, PG. 10.
10) OWNER: MILLROSE PROPERTIES NORTH CAROLINA, LLC 5505 WATERFORD DISTRICT DR. MIAMI, FL 33126
DEVELOPER: LENNAR CAROLINAS, LLC 1359 21ST AVE. NORTH SUITE 105 MYRTLE BEACH, SC 29577
11) MINIMUM BUILDING SETBACKS ARE:
FRONT: 10'
SIDE ROAD: 10'
SIDE: 0'
REAR: 10'
MIN. LOT SIZE
SINGLE FAMILY ATTACHED: 1,500 S.F.±
BUILDING HEIGHTS NOT TO EXCEED 35'
FFE SHALL BE A MINIMUM OF 1' ABOVE BACK OF CURB
TOTAL NUMBER OF LOTS: 110.
12) ALL PROPERTIES CREATED BY THIS SUBDIVISION ARE SUBJECT TO THE DECLARATION OF COVENANTS, CONDITIONS AND RESTRICTIONS FOR CALABASH POINTE RECORDED IN PLAT BOOK _____, PAGE _____, AT THE BRUNSWICK COUNTY REGISTER OF DEEDS OFFICE.
13) ROADS SHALL BE BUILT TO NCDOT SUBDIVISION STANDARDS.
14) SUBSURFACE AND ENVIRONMENTAL CONDITIONS WERE NOT EXAMINED OR CONSIDERED AN ELEMENT OF THIS SURVEY. NO STATEMENT IS MADE REGARDING THE EXISTENCE OF UNDERGROUND OR OVERHEAD CONTINGENCIES THAT MAY AFFECT THE USE OF THESE PARCELS.
15) WETLANDS SHOWN HAVE BEEN SUPPLIED BY THE BRIGMAN COMPANY PER DELINEATION DATED JAN. 25, 2024. WETLANDS HAVE NOT BEEN FIELD LOCATED BY THOMAS & HUTTON.

LEGEND

- ○ 5/8" IRON REBAR SET
- ◉ IRON PIPE FOUND (SIZE NOTED)
- ● IRON REBAR FOUND (SIZED NOTED)
- ■ CONCRETE MONUMENT
- SURVEY CONTROL MONUMENT
- WETLAND
- PROPERTY BOUNDARY
- RIGHT-OF-WAY
- ADJACENT PROPERTY LINE (NOT SURVEYED)
- DRAINAGE/PROPERTY EASEMENT
- INGRESS/EGRESS & UTILITY EASEMENT
- LOT LINE

I, MATTHEW D. SVEJKOVSKY, CERTIFY THAT THIS MAP WAS DRAWN UNDER MY SUPERVISION FROM AN ACTUAL GPS (OR GNSS) SURVEY MADE UNDER MY SUPERVISION AND THE FOLLOWING INFORMATION WAS USED TO PERFORM THE SURVEY

CLASS OF SURVEY: (A)
POSITIONAL ACCURACY: 0.05
TYPE GPS (OR GNSS) FIELD PROCEDURE: FIELD PROCEDURE: RTN - BASE ROVER
DATE(S) OF SURVEY: JAN. 2024
DATUM/EPOCH: NAD 83(2011)/2010
PUBLISHED/FIXED CONTROL: 'GLEN' PID AJ4914 & 'WILSON' PID AJ4913
GEOID MODEL: 2018
COMBINED GRID FACTOR: 1.0001140645
UNITS: U.S. SURVEY FEET

LOTS =	27.02 AC.
COMMON AREA =	5.42 AC.
PUMP STATION =	0.11 AC.
TOTAL AREA =	32.55 AC.

B0177 P0030 04-02-2026 13:02:09.000
Brunswick County, NC Register of Deeds Dana Varnam page 4 of 4 PLAT

S 80°39'43" W 343.61'(TIE)
V2"
N 50°09'58" W 401.01'(TIE)
N: 66,148.23
E: 2,129,127.84
WOODLANDS AT CROW CREEK HOA INC. 22SEC025 D.B. 2042, PG. 631
WETLAND (SEE NOTE #15)
N 39°28'15" E 408.75'
482.75'(TOTAL)
N 50°09'58" W 294.13'
775.37'(TOTAL)
EXISTING DRAINAGE EASEMENT M.C. 31, PG. 403
REMAINDER OF MILLROSE PROPERTIES NORTH CAROLINA, LLC 22500035 D.B. 5331 PG. 99 21.59 AC.
NC GRID NAD 83(2011)
N 02°59'48" W 600.84'
L2 74.00
L3 (10') 2,668 S.F.
L105
L104
S 50°34'45" E 89.91'(TOTAL) 84.91'
L355 45.00' C4 L106
PUMP STATION 4,973 S.F. 0.11 AC.
L252 L251
COMMON AREA 1
MATCH LINE - SEE SHEET NO. 2
MATCH LINE - SEE SHEET NO. 4

VICINITY MAP not to scale
S.R. 1303 HICKMAN RD.
CROW CREEK GOLF COURSE
FARM @ BRUNSWICK
U.S. HIGHWAY 17

This document and all reproducible copies of this document are the property of Thomas & Hutton. Reproduction of this document is not permitted without written consent of Thomas & Hutton unless this document becomes a matter of public record. ALTERATIONS TO THIS DOCUMENT ARE NOT PERMITTED.

THOMAS & HUTTON ENGINEERING CO. No. F-0871 CERTIFICATE OF AUTHORIZATION

NORTH CAROLINA PROFESSIONAL SEAL L-5564 LAND SURVEYOR MATTHEW D. SVEJKOVSKY

I, MATTHEW D. SVEJKOVSKY, CERTIFY THAT THIS PLAT WAS DRAWN FROM AN ACTUAL FIELD SURVEY UNDER MY SUPERVISION (DEED DESCRIPTION RECORDED IN D.B. 5331, PG. 99); THAT THE BOUNDARIES NOT SURVEYED ARE CLEARLY INDICATED AS DRAWN FROM INFORMATION FOUND IN DEED BOOK N/A; THAT THE RATIO OF PRECISION AS CALCULATED IS 1:10,000; AND THAT THIS PLAT WAS PREPARED IN ACCORDANCE WITH G.S. 47-30 AS AMENDED. WITNESS MY HAND AND SEAL THIS 26TH DAY OF MARCH 2026.

THIS SURVEY CREATES A SUBDIVISION OF LAND WITHIN AN AREA OF A COUNTY OR MUNICIPALITY THAT HAS AN ORDINANCE THAT REGULATES PARCELS OF LAND.

3/26/26
MATTHEW D. SVEJKOVSKY, PLS PROFESSIONAL LAND SURVEYOR LICENSE NO. L-5564

SUBDIVISION PLAT OF

CALABASH POINTE PHASE 1

SHALLOTTE TOWNSHIP
BRUNSWICK COUNTY, NORTH CAROLINA

prepared for
LENNAR CAROLINAS, LLC

No	Revision	By	Date
2	UPDATED CERTS	JED	3/26/2026
1	UPDATED FOR RECORDING	JED	2/4/2026

THOMAS & HUTTON
611 Burroughs & Chapin Blvd. • Suite 202
Myrtle Beach, SC 29577 • 843.839-3545
www.thomasandhutton.com

60 0 60 120
1 INCH = 60 FEET

plat	drawn	reviewed	field	crew
8/1/2024	JED	MDS	1/24/2024	CDH

job 31725.0000s01(PH1) SHEET 4 OF 4

COUNTY OF BRUNSWICK

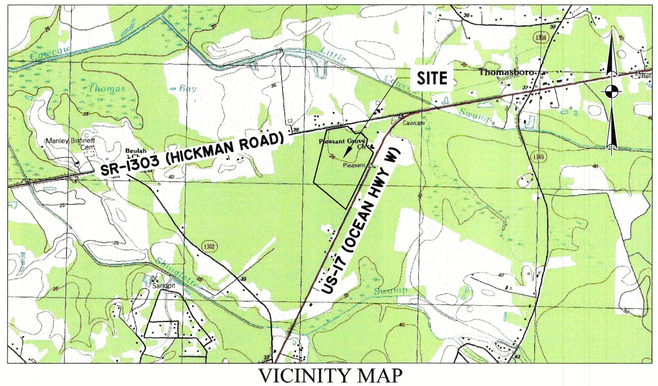

VICINITY MAP
(Not to Scale)

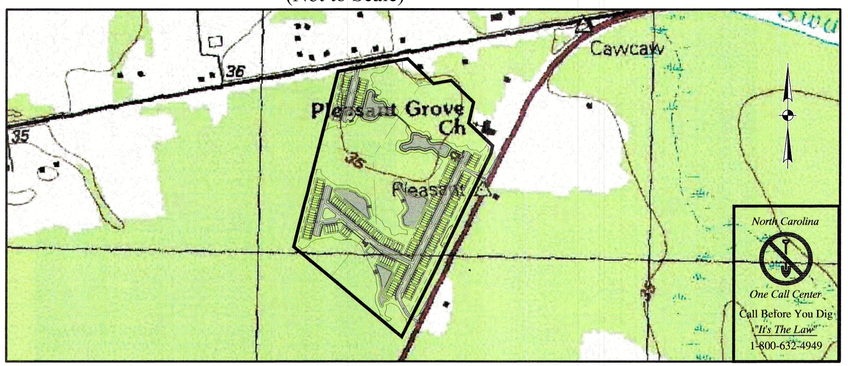

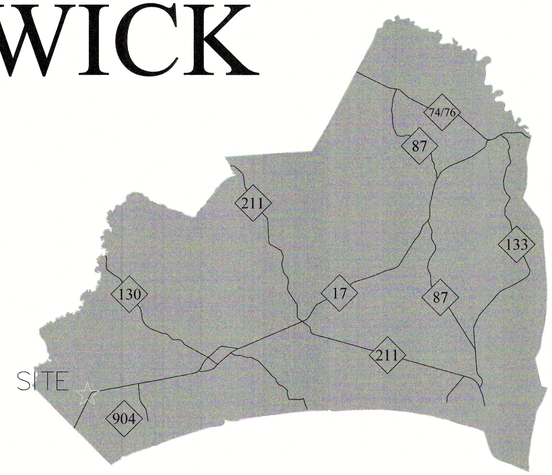

PARCEL ID #: 22500035

CALABASH POINTE
PHASE 1
WATER & SEWER
RECORD DRAWINGS

OWNER

LENNAR CAROLINAS, LLC
1359 21ST AVENUE NORTH
SUITE 105
MYRTLE BEACH,
SOUTH CAROLINA
29577

ENGINEER / SURVEYOR

THOMAS & HUTTON

INDEX OF SHEETS

Sheet List Table

Sheet Number	Sheet Title
C0	Brunswick County Cover Sheet
SH1	WATER
SH2	WATER
SH3	WATER
SH4	SEWER
SH5	SEWER
SH6	SEWER
SH7	PUMP STATION DETAIL
SH8	SEWER PROFILES
SH9	SEWER FORCEMAIN PROFILE

NUMBER	DATE	BY	REVISION DESCRIPTION
1	3/3/26	D.O.B	ADDED WV'S & PUMP CURVE PER BRUNSWICK CO. COMMENTS

APPROVAL STATUS	DATE	BY	DEPARTMENT
☐ YES ☐ NO ☐ N/A			PLANNING
☐ YES ☐ NO ☐ N/A			ENGINEERING
☐ YES ☐ NO ☐ N/A			PUBLIC UTILITIES

"ENGINEER'S CERTIFICATION OF COMPLIANCE WITH BRUNSWICK COUNTY SPECIFICATIONS AND DETAILS"
I hereby certify that the plans, details, and associated project specifications comply with the latest version, as of this date, of Brunswick County's Standard Specifications and Standard Details per standard engineering practice. Furthermore, I confirm my understanding that reviews and approvals by Brunswick County personnel do not imply that Brunswick County personnel have reviewed and are in agreement with every portion of the plans and specifications that I have submitted. I understand that Brunswick County reviews and approvals are meant to ensure that the overall plans are in general compliance with County objectives. I understand that it is my full responsibility to ensure that plans and specifications are in full compliance with applicable County, State, Federal, and other municipal requirements. Additionally, I understand that the County will not assume operation, maintenance, or ownership of constructed facilities that do not meet County requirements and the County may refuse to issue permits at facilities that the County deems are non-compliant with County Specifications. I also confirm my understanding that County Inspections are for the sole use of the County and I certify that I will not use, or direct others to use, County inspections for State compliance purposes or any other purpose."

DATE: 2/9/26

SUBMITTAL: FINAL

PROJECT NAME: Calabash Pointe
LOCATION: Brunswick County, North Carolina
OWNER: Lennar Carolinas, LLC.
DESIGNER: Thomas & Hutton

NORTH CAROLINA PROFESSIONAL SEAL 053169 ENGINEER NATHAN T. POUND 2/9/26

THOMAS & HUTTON ENGINEERING CO. No. F-0871 NORTH CAROLINA CERTIFICATE OF AUTHORIZATION

TECH: DOB

DES: WPH

CHK: NTP

PROJECT NO. 31725.0000

SHEET NO. C0

LEGEND

- HOODED INLET
- STORM MANHOLE
- GRATE INLET
- WATER VALVE
- FIRE HYDRANT
- FITTING
- SEWER MANHOLE
- RIGHT OF WAY
- ADJACENT PROPERTY LINE
- BOUNDARY LINE

N.C. GRID
NAD 83(2011)

CALABASH POINTE
IS OWNED AND DEVELOPED BY:
LENNAR CAROLINAS, LLC.
ADDRESS: 1359 21ST AVE. N SUITE 105,
MYRTLE BEACH, SC 29577
PHONE: (843) 839-3963
DESIGN / INSPECTING ENGINEER:
THOMAS AND HUTTON ENGINEERING COMPANY
ADDRESS: 611 BURROUGHS & CHAPIN BLVD. SUITE 202
MYRTLE BEACH, SC 29579
PHONE 843-839-3545
WATER & WASTE WATER SYSTEMS
HAVE BEEN INSTALLED BY:
R.H. MOORE
10601 HIGHWAY 707
MURRELLS INLET, SC 29576
PHONE: 843-650-2155

NOTES:
1) P.I.D.# 225000035.
2) DATE OF FIELD SURVEY: FEB. 2026.
3) THIS SURVEY IS VALID ONLY IF THE PRINT OF SAME HAS THE ORIGINAL SIGNATURE AND SEAL OF THE SURVEYOR.
4) ALL ELEVATIONS ARE BASED ON (NAVD 88).
5) ALL COORDINATES SHOWN ARE BASED ON THE NORTH CAROLINA STATE PLANE COORDINATE SYSTEM NAD1983(2011). DISTANCES SHOWN ARE HORIZONTAL DISTANCES NOT GRID DISTANCES.

72 71 70 69 68 67 66 65 64 63 62 61 60 59 58 57 56 55 54 53 52 51 50

SUNSET SHOALS BOULEVARD
(PRIVATE INGRESS/EGRESS & UTILITY EASEMENT WIDTH VARIES)

WS FOR FUTURE AMENITY
1" IRRIGATION SERVICE
8" PVC C900 DR18
WATER CROSSES UNDER STORM 1.5'
2" NUT VALVE
8" GV
FHV
FH
8"X 6" REDUCER
IRRIGATION METER
26 25 24 23 22 21 20 19 18 17 16 15 14 13 12 11 10 9 8 7 6 5 4 3 2 1
WATER CROSSES UNDER STORM
WATER CROSSES UNDER STORM 4'
200 LF 10" DR9 IPS HDPE
8" 90° BEND
TIED TO EXISTING WATER MAIN
WITH 12" TAPING SLEEVE & 8" WV

30' PROPERTY BUFFER

U.S. HIGHWAY 17
(PUBLIC R/W WIDTH VARIES)

MATCH LINE – SEE SHEET NO. 2
MATCH LINE – SEE SHEET NO. 1

DIGITRAK LWD
Drill Data

Profile Chart
EOP EOP
Depth, ft
Distance, ft
Blue: Drill Path -- Green: Calculated Terrain

Pressure Chart
Pressure, PSI
Distance, ft
Green: Average Pressure -- Blue: High Pressure -- Gold: Max Pressure

Digital Control Incorporated

Page 2 of 4

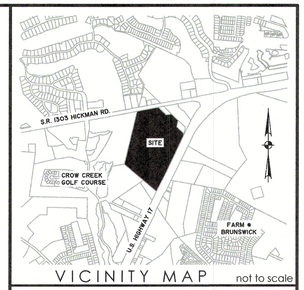

VICINITY MAP not to scale

This document and all reproducible copies of this document are the property of Thomas & Hutton. Reproduction of this document is not permitted without written consent of Thomas & Hutton unless this document becomes a matter of public record. ALTERATIONS TO THIS DOCUMENT ARE NOT PERMITTED.

NORTH CAROLINA PROFESSIONAL ENGINEER SEAL 53169 NATHAN T. POUND 3/3/26
THOMAS & HUTTON ENGINEERING CO. No. F-0871 CERTIFICATE OF AUTHORIZATION

THE FACILITIES HAVE BEEN CONSTRUCTED AS SHOWN ON THE "RECORD DRAWING" PLAN, AND THE FACILITIES MEET THE APPROVED WATER AND WASTEWATER PLAN AND SPECIFICATIONS OR ACHIEVE THE FUNCTION FOR WHICH THEY WERE DESIGNED.

NORTH CAROLINA PROFESSIONAL LAND SURVEYOR SEAL L-5564 MATTHEW D. SVEJKOVSKY
THOMAS & HUTTON ENGINEERING CO. No. F-0871 CERTIFICATE OF AUTHORIZATION

I, MATTHEW D. SVEJKOVSKY, CERTIFY THAT THIS WATER & WASTE WATER SYSTEM RECORD DRAWING IS DRAWN UNDER MY DIRECT SUPERVISION, AND BASED ON A FIELD SURVEY BY THOMAS AND HUTTON; THAT THE FIELDWORK WAS COMPLETED ON 5TH DAY OF FEBRUARY 2026; THAT THE BOUNDARY LINES SHOWN ARE COMPILED FROM PREVIOUSLY RECORDED MAPS. WITNESS MY HAND AND SEAL THIS 3RD DAY OF MARCH 2026.

MATTHEW D. SVEJKOVSKY NC PROFESSIONAL LAND SURVEYOR
LICENSE NO. L-5564

WATER & SEWER
RECORD DRAWING
OF

CALABASH POINTE
PHASE 1

SHALLOTTE TOWNSHIP
BRUNSWICK COUNTY, NORTH CAROLINA

prepared for
LENNAR CAROLINAS, LLC

No.	Revision	By	Date
1	BRUNSWICK CO. COMMENTS	DOB	3/3/26

THOMAS & HUTTON
611 Burroughs & Chapin Blvd. • Suite 202
Myrtle Beach, SC 29577 • 843.839-3545
www.thomasandhutton.com

30 0 30 60
1 INCH = 30 FEET

plat	drawn	reviewed	field	crew
2/9/26	DOB	JC/MDS	2/26	DH

job 31725-WATER

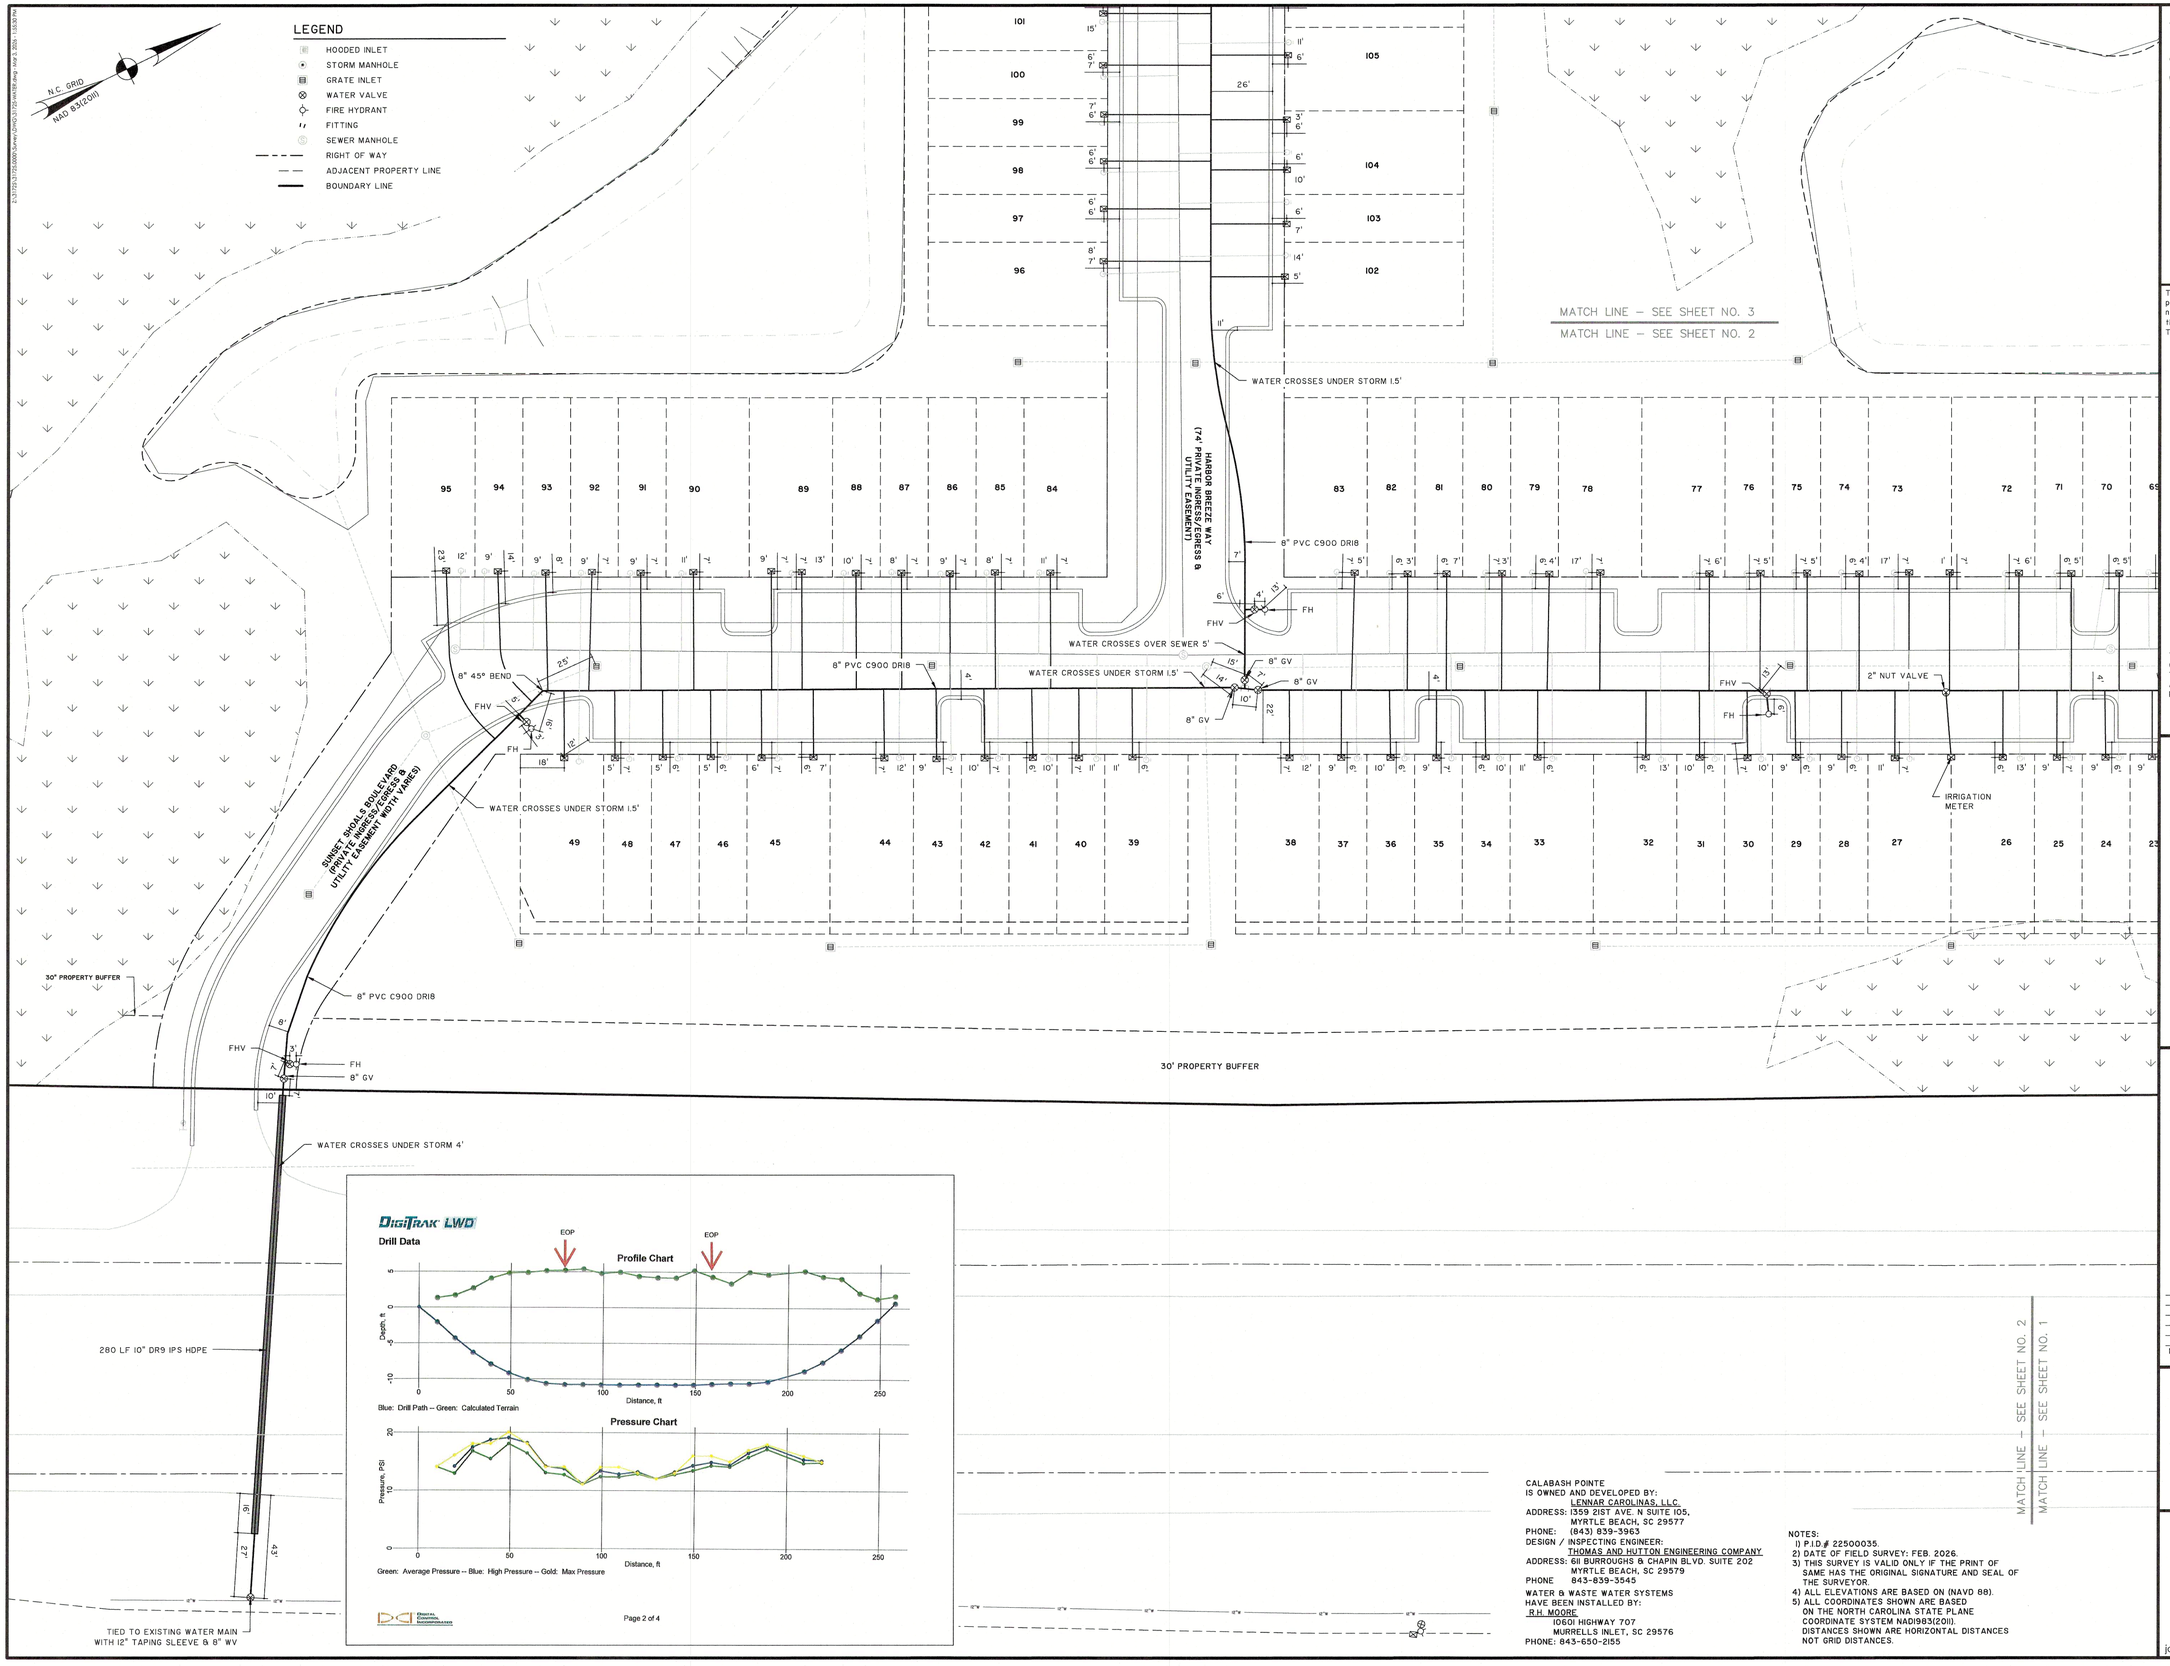

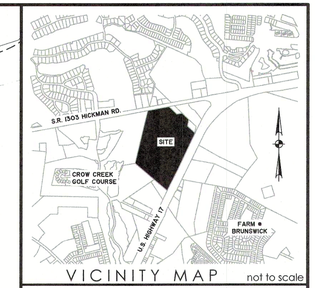

VICINITY MAP not to scale

This document and all reproducible copies of this document are the property of Thomas & Hutton. Reproduction of this document is not permitted without written consent of Thomas & Hutton unless this document becomes a matter of public record. ALTERATIONS TO THIS DOCUMENT ARE NOT PERMITTED.

NORTH CAROLINA PROFESSIONAL ENGINEERING THOMAS & HUTTON ENGINEERING CO. No. F-0871 CERTIFICATE OF AUTHORIZATION

NORTH CAROLINA PROFESSIONAL SEAL 53169 ENGINEER NATHAN T. POUND 3/3/26

THE FACILITIES HAVE BEEN CONSTRUCTED AS SHOWN ON THE "RECORD DRAWING" PLAN, AND THE FACILITIES MEET THE APPROVED WATER AND WASTEWATER PLAN AND SPECIFICATIONS OR ACHIEVE THE FUNCTION FOR WHICH THEY WERE DESIGNED.

NORTH CAROLINA PROFESSIONAL THOMAS & HUTTON ENGINEERING CO. No. F-0871 CERTIFICATE OF AUTHORIZATION

NORTH CAROLINA PROFESSIONAL SEAL L-5564 LAND SURVEYOR MATTHEW D. SVEJKOVSKY

I, MATTHEW D. SVEJKOVSKY, CERTIFY THAT THIS WATER & WASTE WATER SYSTEM RECORD DRAWING IS DRAWN UNDER MY DIRECT SUPERVISION, AND BASED ON A FIELD SURVEY BY THOMAS AND HUTTON; THAT THE FIELDWORK WAS COMPLETED ON 5TH DAY OF FEBRUARY 2026; THAT THE BOUNDARY LINES SHOWN ARE COMPILED FROM PREVIOUSLY RECORDED MAPS. WITNESS MY HAND AND SEAL THIS 3RD DAY OF MARCH 2026.

MATTHEW D. SVEJKOVSKY N.C. PROFESSIONAL LAND SURVEYOR LICENSE NO. L-5564

WATER & SEWER RECORD DRAWING OF

CALABASH POINTE PHASE 1

SHALOTTE TOWNSHIP
BRUNSWICK COUNTY, NORTH CAROLINA

prepared for
LENNAR CAROLINAS, LLC

No.	Revision	By	Date
1.	BRUNSWICK CO. COMMENTS	DOB	3/3/26

THOMAS & HUTTON
611 Burroughs & Chapin Blvd. • Suite 202
Myrtle Beach, SC 29577 • 843.839-3545
www.thomasandhutton.com

30 0 30 60
1 INCH = 30 FEET

plat	drawn	reviewed	field	crew
2/9/26	DOB	JC/MDS	2/26	DH

job 31725-WATER

CALABASH POINTE
IS OWNED AND DEVELOPED BY:
LENNAR CAROLINAS, LLC.
ADDRESS: 1359 21ST AVE. N SUITE 105,
MYRTLE BEACH, SC 29577
PHONE: (843) 839-3963
DESIGN / INSPECTING ENGINEER:
THOMAS AND HUTTON ENGINEERING COMPANY
ADDRESS: 611 BURROUGHS & CHAPIN BLVD. SUITE 202
MYRTLE BEACH, SC 29579
PHONE 843-839-3545
WATER & WASTE WATER SYSTEMS
HAVE BEEN INSTALLED BY:
R.H. MOORE
10601 HIGHWAY 707
MURRELLS INLET, SC 29576
PHONE: 843-650-2155

NOTES:
1) P.I.D.# 22500035.
2) DATE OF FIELD SURVEY: FEB. 2026.
3) THIS SURVEY IS VALID ONLY IF THE PRINT OF SAME HAS THE ORIGINAL SIGNATURE AND SEAL OF THE SURVEYOR.
4) ALL ELEVATIONS ARE BASED ON (NAVD 88).
5) ALL COORDINATES SHOWN ARE BASED ON THE NORTH CAROLINA STATE PLANE COORDINATE SYSTEM NAD1983(2011). DISTANCES SHOWN ARE HORIZONTAL DISTANCES NOT GRID DISTANCES.

MATCH LINE – SEE SHEET NO. 2
MATCH LINE – SEE SHEET NO. 1

REMAINDER OF
MILLROSE PROPERTIES
NORTH CAROLINA, LLC
22500035
D.B. 5331 PG. 99
21.59 AC.

CALABASH POINTE
IS OWNED AND DEVELOPED BY:
LENNAR CAROLINAS, LLC
ADDRESS: 1359 21ST AVE. N SUITE 105,
MYRTLE BEACH, SC 29577
PHONE: (843) 839-3963
DESIGN / INSPECTING ENGINEER:
THOMAS AND HUTTON ENGINEERING COMPANY
ADDRESS: 611 BURROUGHS & CHAPIN BLVD. SUITE 202
MYRTLE BEACH, SC 29579
PHONE 843-839-3545
WATER & WASTE WATER SYSTEMS
HAVE BEEN INSTALLED BY:
R.H. MOORE
10601 HIGHWAY 707
MURRELLS INLET, SC 29576
PHONE: 843-650-2155

NOTES:
1) P.I.D.# 22500035.
2) DATE OF FIELD SURVEY: FEB. 2026.
3) THIS SURVEY IS VALID ONLY IF THE PRINT OF SAME HAS THE ORIGINAL SIGNATURE AND SEAL OF THE SURVEYOR.
4) ALL ELEVATIONS ARE BASED ON (NAVD 88).
5) ALL COORDINATES SHOWN ARE BASED ON THE NORTH CAROLINA STATE PLANE COORDINATE SYSTEM NAD1983(2011). DISTANCES SHOWN ARE HORIZONTAL DISTANCES NOT GRID DISTANCES.

N.C. GRID
(NAD 83(2011))

LEGEND
- HOODED INLET
- STORM MANHOLE
- GRATE INLET
- WATER VALVE
- FIRE HYDRANT
- FITTING
- SEWER MANHOLE
- RIGHT OF WAY
- ADJACENT PROPERTY LINE
- BOUNDARY LINE

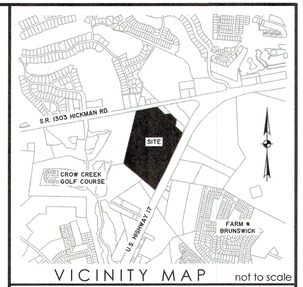

VICINITY MAP not to scale

This document and all reproducible copies of this document are the property of Thomas & Hutton. Reproduction of this document is not permitted without written consent of Thomas & Hutton unless this document becomes a matter of public record. ALTERATIONS TO THIS DOCUMENT ARE NOT PERMITTED.

THOMAS & HUTTON ENGINEERING CO No. F-0871 CERTIFICATE OF AUTHORIZATION

NORTH CAROLINA PROFESSIONAL SEAL 53169 ENGINEER NATHAN T. POUND 3/3/26

THE FACILITIES HAVE BEEN CONSTRUCTED AS SHOWN ON THE "RECORD DRAWING" PLAN, AND THE FACILITIES MEET THE APPROVED WATER AND WASTEWATER PLAN AND SPECIFICATIONS OR ACHIEVE THE FUNCTION FOR WHICH THEY WERE DESIGNED.

THOMAS & HUTTON ENGINEERING CO No. F-0871 CERTIFICATE OF AUTHORIZATION

NORTH CAROLINA PROFESSIONAL SEAL L-5564 LAND SURVEYOR MATTHEW D. SVEJKOVSKY

I, MATTHEW D. SVEJKOVSKY, CERTIFY THAT THIS WATER & WASTE WATER SYSTEM RECORD DRAWING IS DRAWN UNDER MY DIRECT SUPERVISION, AND BASED ON A FIELD SURVEY BY THOMAS AND HUTTON; THAT THE FIELDWORK WAS COMPLETED ON 5TH DAY OF FEBRUARY 2026; THAT THE BOUNDARY LINES SHOWN ARE COMPILED FROM PREVIOUSLY RECORDED MAPS. WITNESS MY HAND AND SEAL, THIS 3RD DAY OF MARCH 2026.

3/3/26
MATTHEW D. SVEJKOVSKY N.C. PROFESSIONAL LAND SURVEYOR
LICENSE NO. L-5564

WATER & SEWER
RECORD DRAWING
OF

CALABASH POINTE PHASE 1

SHALLOTTE TOWNSHIP
BRUNSWICK COUNTY, NORTH CAROLINA

prepared for
LENNAR CAROLINAS, LLC

No	Revision	By	Date
1	BRUNSWICK CO. COMMENTS	DOB	3/3/26

THOMAS & HUTTON
611 Burroughs & Chapin Blvd. • Suite 202
Myrtle Beach, SC 29577 • 843.839-3545
www.thomasandhutton.com

30 0 30 60
1 INCH = 30 FEET

plat	drawn	reviewed	field	crew
2/9/26	DOB	JC/MDS	2/26	DH

job 31725-WATER

MATCH LINE – SEE SHEET NO. 3
MATCH LINE – SEE SHEET NO. 2

8" GV
8" PVC C900 DR18
WATER CROSSES UNDER STORM 1.5'
WATER CROSSES OVER SEWER 5'
8" 45° BEND
FHV
FH
2" NUT VALVE
IRRIGATION METER
HARBOR BREEZE WAY (74' PRIVATE INGRESS/EGRESS & UTILITY EASEMENT)
SUNSET SHOALS BOULEVARD (PRIVATE INGRESS/EGRESS & UTILITY EASEMENT WIDTH VARIES)

LEGEND

- HOODED INLET
- STORM MANHOLE
- GRATE INLET
- WATER VALVE
- FIRE HYDRANT
- FITTING
- SEWER MANHOLE
- RIGHT OF WAY
- ADJACENT PROPERTY LINE
- BOUNDARY LINE

N.C. GRID
NAD 83(2011)

MANHOLE SCHEDULE

MANHOLE	RIM ELEV.	INVERT IN ELEV.	INVERT OUT ELEV
MH 8	38.43		33.67
MH 4	38.67	30.40	30.30
MH 1-2	38.20		22.03
MH 3	38.05	21.32	21.22
MH 7	38.00		29.07
MH 6	38.49	28.01	27.91
MH 5	37.92	26.23	26.13
MH 4	38.67	24.55	24.45
MH 3	38.05	23.19	23.09
MH 2	39.21	21.22	21.12
MH 1	39.39	20.74	20.64

PIPE SCHEDULE

FROM MANHOLE	TO MANHOLE	LENGTH	SLOPE	PIPE MATERIAL (PVC)	SIZE
MH 8	MH 4	304	1.08%	DR 18	8"
MH 1-2	MH 3	168	4.2%	DR 18	8"
MH 7	MH 6	260	4.1%	DR 18	8"
MH 6	MH 5	391	4.3%	DR 18	8"
MH 5	MH 4	388	4.1%	DR 18	8"
MH 4	MH 3	310	4.1%	DR 18	8"
MH 3	MH 2	66	2.83%	DR 18	8"
MH 2	MH 1	27	1.41%	DR 18	8"

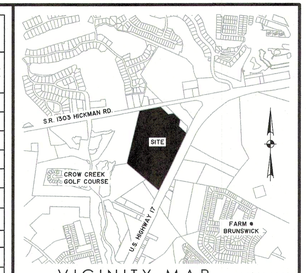

VICINITY MAP not to scale

This document and all reproducible copies of this document are the property of Thomas & Hutton. Reproduction of this document is not permitted without written consent of Thomas & Hutton unless this document becomes a matter of public record. ALTERATIONS TO THIS DOCUMENT ARE NOT PERMITTED.

CALABASH POINTE
IS OWNED AND DEVELOPED BY:
LENNAR CAROLINAS, LLC.
ADDRESS: 1359 21ST AVE. N SUITE 105,
MYRTLE BEACH, SC 29577
PHONE: (843) 839-3963
DESIGN / INSPECTING ENGINEER:
THOMAS AND HUTTON ENGINEERING COMPANY
ADDRESS: 611 BURROUGHS & CHAPIN BLVD. SUITE 202
MYRTLE BEACH, SC 29579
PHONE 843-839-3545
WATER & WASTE WATER SYSTEMS
HAVE BEEN INSTALLED BY:
R.H. MOORE
10601 HIGHWAY 707
MURRELLS INLET, SC 29576
PHONE: 843-650-2155

NORTH CAROLINA — THOMAS & HUTTON ENGINEERING CO. — No. F-0871 — CERTIFICATE OF AUTHORIZATION

NORTH CAROLINA — PROFESSIONAL — SEAL L-5564 — 3/3/26 — LAND SURVEYOR — MATTHEW D. SVEJKOVSKY

THE FACILITIES HAVE BEEN CONSTRUCTED AS SHOWN ON THE "RECORD DRAWING" PLAN, AND THE FACILITIES MEET THE APPROVED WATER AND WASTEWATER PLAN AND SPECIFICATIONS OR ACHIEVE THE FUNCTION FOR WHICH THEY WERE DESIGNED.

NORTH CAROLINA — THOMAS & HUTTON ENGINEERING CO. — No. F-0871 — CERTIFICATE OF AUTHORIZATION

NORTH CAROLINA — PROFESSIONAL — SEAL L-5564 — LAND SURVEYOR — MATTHEW D. SVEJKOVSKY

I, MATTHEW D. SVEJKOVSKY, CERTIFY THAT THIS WATER & WASTE WATER SYSTEM RECORD DRAWING IS DRAWN UNDER MY DIRECT SUPERVISION, AND BASED ON A FIELD SURVEY BY THOMAS AND HUTTON; THAT THE FIELDWORK WAS COMPLETED ON 5TH DAY OF FEBRUARY 2026; THAT THE BOUNDARY LINES SHOWN ARE COMPILED FROM PREVIOUSLY RECORDED MAPS. WITNESS MY HAND AND SEAL THIS 3RD DAY OF MARCH 2026.

MATTHEW D. SVEJKOVSKY NC PROFESSIONAL LAND SURVEYOR
LICENSE NO. L-5564

WATER & SEWER RECORD DRAWING OF

CALABASH POINTE PHASE 1

SHALOTTE TOWNSHIP
BRUNSWICK COUNTY, NORTH CAROLINA

prepared for
LENNAR CAROLINAS, LLC

No.	Revision	By	Date

THOMAS & HUTTON
611 Burroughs & Chapin Blvd. • Suite 202
Myrtle Beach, SC 29577 • 843.839-3545
www.thomasandhutton.com

30 0 30 60
1 INCH = 30 FEET

plat	drawn	reviewed	field	crew
2/9/26	DOB	JC/MDS	2/26	DH

job 31725-SEWER

72 STA: 3+44 32' L
71 STA: 3+65 32' L
70 STA: 3+86 32' L
69 STA: 0+16 32' L
68 STA: 0+38 32' L
67 STA: 0+60 31' L
66 STA: 1+26 31' L
65 STA: 1+48 31' L
64 STA: 1+68 30' L
63 STA: 1+87 31' L
62 STA: 2+08 30' L
61 STA: 2+30 30' L
60 STA: 2+77 30' L
59 STA: 2+97 30' L
58 STA: 3+17 29' L
57 STA: 3+38 29' L
56 STA: 3+59 29' L
55 STA: 0+13 28' L
54 STA: 0+35 29' L
53 STA: 0+55 29' L
52 STA: 0+74 29' L
51 STA: 0+95 29' L
50 STA: 1+17 29' L
STA: 1+68 29' L

SEWER CROSSES BELOW STORM 3'
MH 5
MH 6
SUNSET SHOALS BOULEVARD (PRIVATE INGRESS/EGRESS & UTILITY EASEMENT WIDTH VARIES)
SEWER CROSSES BELOW STORM 2'
MH 7
2.0'

26 STA: 3+50 45' R
25 STA: 3+71 45' R
24 STA: 0+03 45' R
23 STA: 0+24 46' R
22 STA: 0+43 46' R
21 STA: 0+64 46' R
20 STA: 1+31 47' R
19 STA: 1+53 47' R
18 STA: 1+73 47' R
17 STA: 1+93 48' R
16 STA: 2+15 47' R
15 STA: 2+61 48' R
14 STA: 2+83 48' R
13 STA: 3+03 48' R
12 STA: 3+23 48' R
11 STA: 3+45 48' R
10 STA: 3+92 49' R
9 STA: 0+22 48' R
8 STA: 0+43 48' R
7 STA: 0+62 49' R
6 STA: 0+81 49' R
5 STA: 1+89 48' R
4 STA: 2+11 48' R
3 STA: 2+33 48' R
2 STA: 2+51 47' R
1 STA: 2+75 47' R

30' PROPERTY BUFFER
30' PROPERTY BUFFER

MATCH LINE — SEE SHEET NO. 5
MATCH LINE — SEE SHEET NO. 4

U.S. HIGHWAY 17
(PUBLIC R/W WIDTH VARIES)

NOTES:
1) P.I.D.# 22500035.
2) DATE OF FIELD SURVEY: FEB. 2026.
3) THIS SURVEY IS VALID ONLY IF THE PRINT OF SAME HAS THE ORIGINAL SIGNATURE AND SEAL OF THE SURVEYOR.
4) ALL ELEVATIONS ARE BASED ON (NAVD 88).
5) ALL COORDINATES SHOWN ARE BASED ON THE NORTH CAROLINA STATE PLANE COORDINATE SYSTEM NAD1983(2011). DISTANCES SHOWN ARE HORIZONTAL DISTANCES NOT GRID DISTANCES.

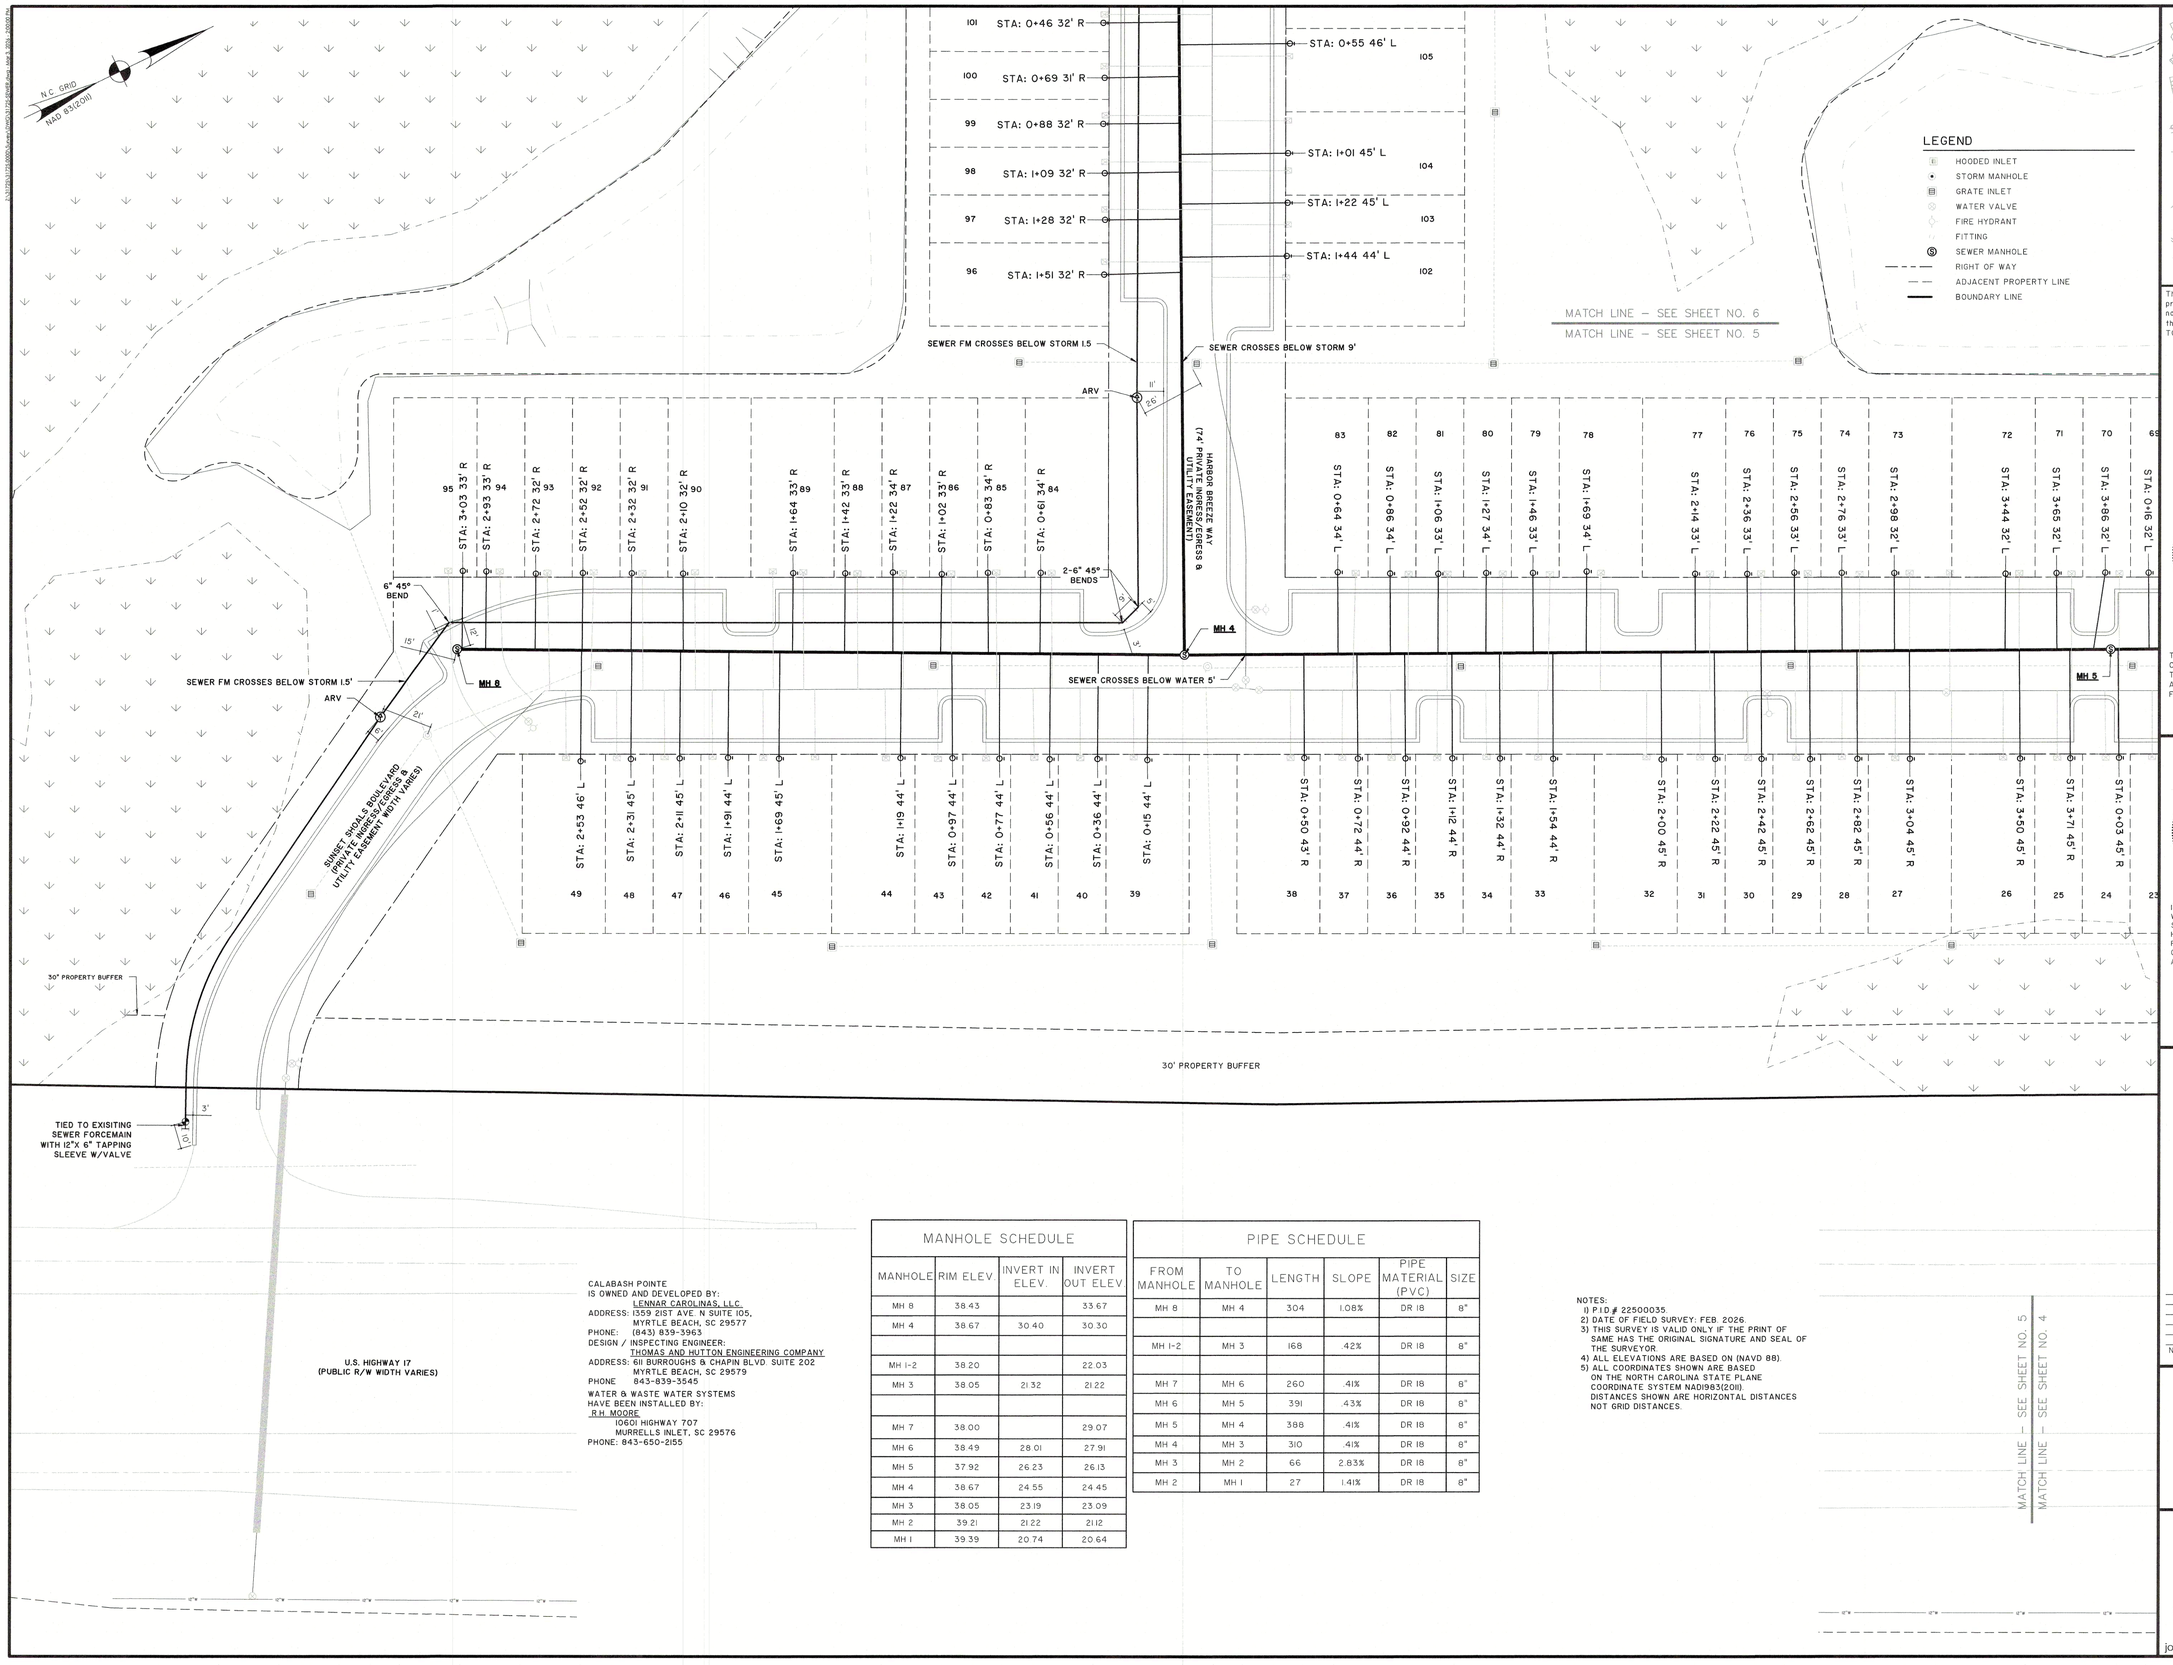

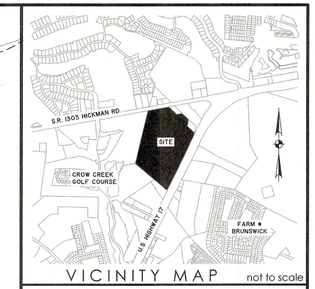

VICINITY MAP not to scale

This document and all reproducible copies of this document are the property of Thomas & Hutton. Reproduction of this document is not permitted without written consent of Thomas & Hutton unless this document becomes a matter of public record. ALTERATIONS TO THIS DOCUMENT ARE NOT PERMITTED.

NORTH CAROLINA PROFESSIONAL ENGINEER SEAL 35169 NATHAN T. POUND 2/6/26
THOMAS & HUTTON ENGINEERING CO. No. F-0871 CERTIFICATE OF AUTHORIZATION

THE FACILITIES HAVE BEEN CONSTRUCTED AS SHOWN ON THE "RECORD DRAWING" PLAN, AND THE FACILITIES MEET THE APPROVED WATER AND WASTEWATER PLAN AND SPECIFICATIONS OR ACHIEVE THE FUNCTION FOR WHICH THEY WERE DESIGNED.

NORTH CAROLINA PROFESSIONAL LAND SURVEYOR SEAL L-5564 MATTHEW D. SVEJKOVSKY
THOMAS & HUTTON ENGINEERING CO. No. F-0871 CERTIFICATE OF AUTHORIZATION

I, MATTHEW D. SVEJKOVSKY, CERTIFY THAT THIS WATER & WASTE WATER SYSTEM RECORD DRAWING IS DRAWN UNDER MY DIRECT SUPERVISION, AND BASED ON A FIELD SURVEY BY THOMAS AND HUTTON; THAT THE FIELDWORK WAS COMPLETED ON 5TH DAY OF FEBRUARY 2026; THAT THE BOUNDARY LINES SHOWN ARE COMPILED FROM PREVIOUSLY RECORDED MAPS. WITNESS MY HAND AND SEAL THIS 3RD DAY OF MARCH 2026.

MATTHEW D. SVEJKOVSKY 3/3/26
MATTHEW D. SVEJKOVSKY N.C. PROFESSIONAL LAND SURVEYOR
LICENSE NO. L-5564

WATER & SEWER RECORD DRAWING OF

CALABASH POINTE PHASE 1

SHALLOTTE TOWNSHIP
BRUNSWICK COUNTY, NORTH CAROLINA

prepared for
LENNAR CAROLINAS, LLC

No.	Revision	By	Date

THOMAS & HUTTON

611 Burroughs & Chapin Blvd. • Suite 202
Myrtle Beach, SC 29577 • 843.839-3545
www.thomasandhutton.com

30 0 30 60
1 INCH = 30 FEET

plat	drawn	reviewed	field	crew
2/9/26	DOB	JC/MDS	2/26	DH

job 31725-SEWER SHEET 5 OF 9

CALABASH POINTE
IS OWNED AND DEVELOPED BY:
LENNAR CAROLINAS, LLC.
ADDRESS: 1359 21ST AVE. N SUITE 105,
MYRTLE BEACH, SC 29577
PHONE: (843) 839-3963
DESIGN / INSPECTING ENGINEER:
THOMAS AND HUTTON ENGINEERING COMPANY
ADDRESS: 611 BURROUGHS & CHAPIN BLVD. SUITE 202
MYRTLE BEACH, SC 29579
PHONE 843-839-3545
WATER & WASTE WATER SYSTEMS
HAVE BEEN INSTALLED BY:
R.H. MOORE
10601 HIGHWAY 707
MURRELLS INLET, SC 29576
PHONE: 843-650-2155

MANHOLE SCHEDULE

MANHOLE	RIM ELEV.	INVERT IN ELEV.	INVERT OUT ELEV.
MH 8	38.43		33.67
MH 4	38.67	30.40	30.30
MH 1-2	38.20		22.03
MH 3	38.05	21.32	21.22
MH 7	38.00		29.07
MH 6	38.49	28.01	27.91
MH 5	37.92	26.23	26.13
MH 4	38.67	24.55	24.45
MH 3	38.05	23.19	23.09
MH 2	39.21	21.22	21.12
MH 1	39.39	20.74	20.64

PIPE SCHEDULE

FROM MANHOLE	TO MANHOLE	LENGTH	SLOPE	PIPE MATERIAL (PVC)	SIZE
MH 8	MH 4	304	1.08%	DR 18	8"
MH 1-2	MH 3	168	.42%	DR 18	8"
MH 7	MH 6	260	.41%	DR 18	8"
MH 6	MH 5	391	.43%	DR 18	8"
MH 5	MH 4	388	.41%	DR 18	8"
MH 4	MH 3	310	.41%	DR 18	8"
MH 3	MH 2	66	2.83%	DR 18	8"
MH 2	MH 1	27	1.41%	DR 18	8"

NOTES:
1) P.I.D.# 22500035.
2) DATE OF FIELD SURVEY: FEB. 2026.
3) THIS SURVEY IS VALID ONLY IF THE PRINT OF SAME HAS THE ORIGINAL SIGNATURE AND SEAL OF THE SURVEYOR.
4) ALL ELEVATIONS ARE BASED ON (NAVD 88).
5) ALL COORDINATES SHOWN ARE BASED ON THE NORTH CAROLINA STATE PLANE COORDINATE SYSTEM NAD1983(2011). DISTANCES SHOWN ARE HORIZONTAL DISTANCES NOT GRID DISTANCES.

MANHOLE SCHEDULE			
MANHOLE	RIM ELEV.	INVERT IN ELEV.	INVERT OUT ELEV.
MH 8	38.43		33.67
MH 4	38.67	30.40	30.30
MH 1-2	38.20		22.03
MH 3	38.05	21.32	21.22
MH 7	38.00		29.07
MH 6	38.49	28.01	27.91
MH 5	37.92	26.23	26.13
MH 4	38.67	24.55	24.45
MH 3	38.05	23.19	23.09
MH 2	39.21	21.22	21.12
MH 1	39.39	20.74	20.64

PIPE SCHEDULE					
FROM MANHOLE	TO MANHOLE	LENGTH	SLOPE	PIPE MATERIAL (PVC)	SIZE
MH 8	MH 4	304	1.08%	DR 18	8"
MH 1-2	MH 3	168	.42%	DR 18	8"
MH 7	MH 6	260	.41%	DR 18	8"
MH 6	MH 5	391	.43%	DR 18	8"
MH 5	MH 4	388	.41%	DR 18	8"
MH 4	MH 3	310	.41%	DR 18	8"
MH 3	MH 2	66	2.83%	DR 18	8"
MH 2	MH 1	27	1.41%	DR 18	8"

CALABASH POINTE
IS OWNED AND DEVELOPED BY:
LENNAR CAROLINAS, LLC.
ADDRESS: 1359 21ST AVE. N SUITE 105,
MYRTLE BEACH, SC 29577
PHONE: (843) 839-3963
DESIGN / INSPECTING ENGINEER:
THOMAS AND HUTTON ENGINEERING COMPANY
ADDRESS: 611 BURROUGHS & CHAPIN BLVD. SUITE 202
MYRTLE BEACH, SC 29579
PHONE 843-839-3545
WATER & WASTE WATER SYSTEMS
HAVE BEEN INSTALLED BY:
R.H. MOORE
1060 HIGHWAY 707
MURRELLS INLET, SC 29576
PHONE: 843-650-2155

NOTES:
1) P.I.D.# 22500035.
2) DATE OF FIELD SURVEY: FEB. 2026.
3) THIS SURVEY IS VALID ONLY IF THE PRINT OF SAME HAS THE ORIGINAL SIGNATURE AND SEAL OF THE SURVEYOR.
4) ALL ELEVATIONS ARE BASED ON (NAVD 88).
5) ALL COORDINATES SHOWN ARE BASED ON THE NORTH CAROLINA STATE PLANE COORDINATE SYSTEM NAD1983(2011). DISTANCES SHOWN ARE HORIZONTAL DISTANCES NOT GRID DISTANCES.

REMAINDER OF
MILLROSE PROPERTIES
NORTH CAROLINA, LLC
22500035
D.B. 5331 PG. 99
21.59 AC.

LEGEND
- HOODED INLET
- STORM MANHOLE
- GRATE INLET
- WATER VALVE
- FIRE HYDRANT
- FITTING
- SEWER MANHOLE
- RIGHT OF WAY
- ADJACENT PROPERTY LINE
- BOUNDARY LINE

N.C. GRID
NAD 83(2011)

MH PH 1-2
15'
STA: 1+49 45' R
SEWER CROSSES BELOW STORM 11'
STA: 1+03 43' R
110
STA: 0+81 44' R
109
STA: 0+59 43' R
108
MH 1
25'
6'
9'
6" GV
2-6" 45° BENDS
MH 2
SEWER CROSSES BELOW FM 11'
MH 3
SEWER CROSSES BELOW STORM 10'
SEWER FM CROSSES BELOW STORM 1.5'
STA: 0+12 47' L
107
STA: 0+34 47' L
106
101 STA: 0+46 32' R
STA: 0+55 46' L
105
100 STA: 0+69 31' R
99 STA: 0+88 32' R
STA: 1+01 45' L
104
98 STA: 1+09 32' R
STA: 1+22 45' L
103
97 STA: 1+28 32' R
STA: 1+44 44' L
102
96 STA: 1+51 32' R
SEWER FM CROSSES BELOW STORM 1.5
SEWER CROSSES BELOW STORM 9'
ARV
11°
26'
HARBOR BREEZE WAY
(74' PRIVATE INGRESS/EGRESS & UTILITY EASEMENT)
2-6" 45° BENDS
19'
15'
5'
MH 4
SEWER CROSSES BELOW WATER 5'
MH 5
6" 45° BEND
15'
20'
MH 8
SEWER FM CROSSES BELOW STORM 1.5'
ARV
21'
SUNSET SHOALS BOULEVARD
(PRIVATE INGRESS/EGRESS & UTILITY EASEMENT WIDTH VARIES)

MATCH LINE – SEE SHEET NO. 6
MATCH LINE – SEE SHEET NO. 5

95 STA: 3+03 33' R
94 STA: 2+93 33' R
93 STA: 2+72 32' R
92 STA: 2+52 32' R
91 STA: 2+32 32' R
90 STA: 2+10 32' R
89 STA: 1+64 33' R
88 STA: 1+42 33' R
87 STA: 1+22 34' R
86 STA: 1+02 33' R
85 STA: 0+83 34' R
84 STA: 0+61 34' R
83 STA: 0+64 34' L
82 STA: 0+86 34' L
81 STA: 1+06 33' L
80 STA: 1+27 34' L
79 STA: 1+46 33' L
78 STA: 1+69 34' L
77 STA: 2+14 33' L
76 STA: 2+36 33' L
75 STA: 2+56 33' L
74 STA: 2+76 33' L
73 STA: 2+98 32' L
72 STA: 3+44 32' L
71 STA: 3+65 32' L
70 STA: 3+86 32' L
69 STA: 0+16 32' L
49 STA: 2+53 46' L
48 STA: 2+31 45' L
47 STA: 2+11 45' L
46 STA: 1+91 44' L
45 STA: 1+69 45' L
44 STA: 1+19 44' L
43 STA: 0+97 44' L
42 STA: 0+77 44' L
41 STA: 0+56 44' L
40 STA: 0+36 44' L
39 STA: 0+15 44' L
38 STA: 0+50 43' R
37 STA: 0+72 44' R
36 STA: 0+92 44' R
35 STA: 1+12 44' R
34 STA: 1+32 44' R
33 STA: 1+54 44' R
32 STA: 2+00 45' R
31 STA: 2+22 45' R
30 STA: 2+42 45' R
29 STA: 2+62 45' R
28 STA: 2+82 45' R
27 STA: 3+04 45' R
26 STA: 3+50 45' R
25 STA: 3+71 45' R
24 STA: 0+03 45' R

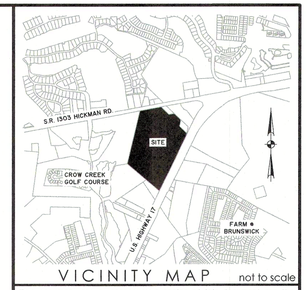

VICINITY MAP not to scale

This document and all reproducible copies of this document are the property of Thomas & Hutton. Reproduction of this document is not permitted without written consent of Thomas & Hutton unless this document becomes a matter of public record. ALTERATIONS TO THIS DOCUMENT ARE NOT PERMITTED.

NORTH CAROLINA THOMAS & HUTTON ENGINEERING CO. No. F-0871 CERTIFICATE OF AUTHORIZATION

NORTH CAROLINA PROFESSIONAL SEAL 5564 ENGINEER NATHAN T. POUND 3/3/26

THE FACILITIES HAVE BEEN CONSTRUCTED AS SHOWN ON THE "RECORD DRAWING" PLAN, AND THE FACILITIES MEET THE APPROVED WATER AND WASTEWATER PLAN AND SPECIFICATIONS OR ACHIEVE THE FUNCTION FOR WHICH THEY WERE DESIGNED.

NORTH CAROLINA THOMAS & HUTTON ENGINEERING CO. No. F-0871 CERTIFICATE OF AUTHORIZATION

NORTH CAROLINA PROFESSIONAL SEAL L-5564 LAND SURVEYOR MATTHEW D. SVEJKOVSKY

I, MATTHEW D. SVEJKOVSKY, CERTIFY THAT THIS WATER & WASTE WATER SYSTEM RECORD DRAWING IS DRAWN UNDER MY DIRECT SUPERVISION, AND BASED ON A FIELD SURVEY BY THOMAS AND HUTTON; THAT THE FIELDWORK WAS COMPLETED ON 5TH DAY OF FEBRUARY 2026; THAT THE BOUNDARY LINES SHOWN ARE COMPILED FROM PREVIOUSLY RECORDED MAPS. WITNESS MY HAND AND SEAL THIS 3RD DAY OF MARCH 2026.

3/3/26
MATTHEW D. SVEJKOVSKY NC PROFESSIONAL LAND SURVEYOR
LICENSE NO. L-5564

WATER & SEWER
RECORD DRAWING
OF

CALABASH POINTE PHASE 1

SHALOTTE TOWNSHIP
BRUNSWICK COUNTY, NORTH CAROLINA

prepared for
LENNAR CAROLINAS, LLC

No.	Revision	By	Date

THOMAS & HUTTON
611 Burroughs & Chapin Blvd. • Suite 202
Myrtle Beach, SC 29577 • 843.839-3545
www.thomasandhutton.com

30 0 30 60
1 INCH = 30 FEET

plat	drawn	reviewed	field	crew
2/9/26	DOB	JC/MDS	2/26	DH

job 31725-SEWER

	ITEM	ELEVATION (NAVD 88)
Ⓐ	TOP ELEV.	39.79'
Ⓑ	INFLUENT PIPE (INVERT)	21.09'
Ⓒ	HIGH WATER ALARM	19.09'
Ⓓ	START LEAD PUMP	17.09'
Ⓔ	START LAG PUMP	18.09'
Ⓕ	PUMP OFF	16.09'
Ⓖ	BOTTOM OF WETWELL	12.09'

ITEM	VALUE
WETWELL DIAMETER (MIN. 8')	8.00'
ROHN 65G TOWER HEIGHT	60' PLUS CONDUIT
PUMP MAKE	FLYGT
PUMP MODEL	NP 3171 SH 3 ~ 275
IMPELLER SIZE	275mm
VOLTAGE	460v
PHASE	3~
HORSEPOWER	35 HP
RPM	3530
DISCHARGE FLOW RATE AT DISCHARGE HEAD	250 GPM @205 TDH

PUMP STATION COST: $970,000

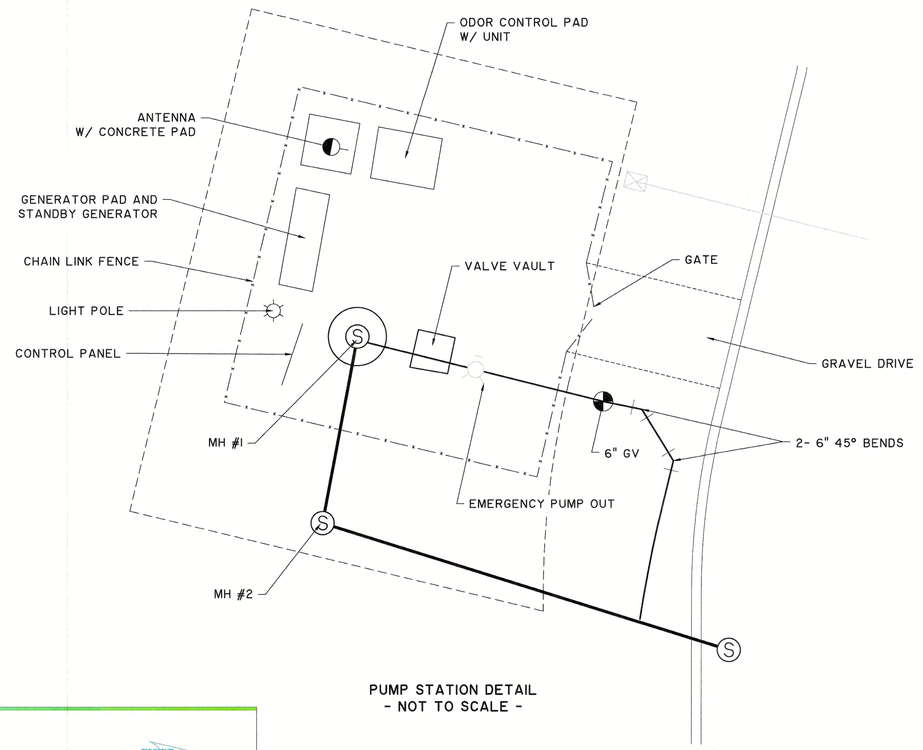

PUMP STATION DETAIL
- NOT TO SCALE -

PUMP CURVE

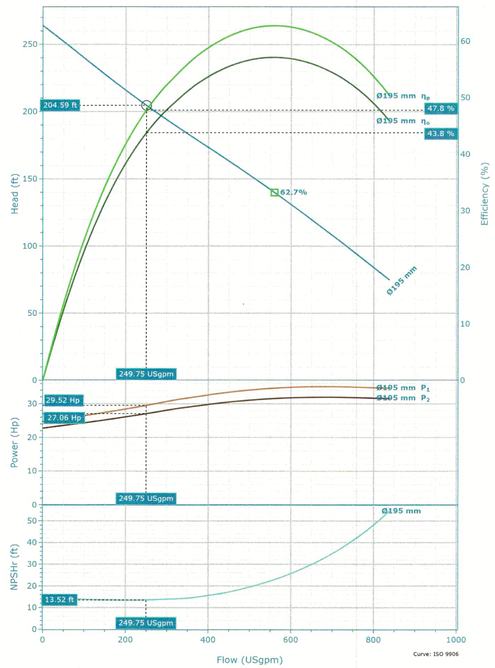

CALABASH POINTE
IS OWNED AND DEVELOPED BY:
LENNAR CAROLINAS, LLC.
ADDRESS: 1359 21ST AVE. N SUITE 105,
MYRTLE BEACH, SC 29577
PHONE: (843) 839-3963
DESIGN / INSPECTING ENGINEER:
THOMAS AND HUTTON ENGINEERING COMPANY
ADDRESS: 611 BURROUGHS & CHAPIN BLVD. SUITE 202
MYRTLE BEACH, SC 29579
PHONE 843-839-3545
WATER & WASTE WATER SYSTEMS
HAVE BEEN INSTALLED BY:
R.H. MOORE
10601 HIGHWAY 707
MURRELLS INLET, SC 29576
PHONE: 843-650-2155

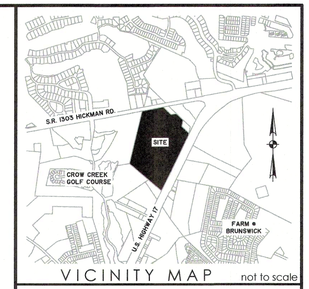

This document and all reproducible copies of this document are the property of Thomas & Hutton. Reproduction of this document is not permitted without written consent of Thomas & Hutton unless this document becomes a matter of public record. ALTERATIONS TO THIS DOCUMENT ARE NOT PERMITTED.

NORTH CAROLINA THOMAS & HUTTON ENGINEERING CO. No. F-0871 CERTIFICATE OF AUTHORIZATION

NORTH CAROLINA PROFESSIONAL SEAL 53169 ENGINEER NATHAN T. POUND 3/3/26

THE FACILITIES HAVE BEEN CONSTRUCTED AS SHOWN ON THE "RECORD DRAWING" PLAN, AND THE FACILITIES MEET THE APPROVED WATER AND WASTEWATER PLAN AND SPECIFICATIONS OR ACHIEVE THE FUNCTION FOR WHICH THEY WERE DESIGNED.

NORTH CAROLINA THOMAS & HUTTON ENGINEERING CO. No. F-0871 CERTIFICATE OF AUTHORIZATION

NORTH CAROLINA PROFESSIONAL SEAL L-5564 LAND SURVEYOR MATTHEW D. SVEJKOVSKY

I, MATTHEW D. SVEJKOVSKY, CERTIFY THAT THIS WATER & WASTE WATER SYSTEM RECORD DRAWING IS DRAWN UNDER MY DIRECT SUPERVISION, AND BASED ON A FIELD SURVEY BY THOMAS AND HUTTON; THAT THE FIELDWORK WAS COMPLETED ON 5TH DAY OF FEBRUARY 2026; THAT THE BOUNDARY LINES SHOWN ARE COMPILED FROM PREVIOUSLY RECORDED MAPS. WITNESS MY HAND AND SEAL THIS 3RD DAY OF MARCH 2026.

Matthew D Svejkovsky 3/3/26

MATTHEW D. SVEJKOVSKY NC PROFESSIONAL LAND SURVEYOR
LICENSE NO. L-5564

NOTES:
1) P.I.D.# 22500035.
2) DATE OF FIELD SURVEY: FEB. 2026.
3) THIS SURVEY IS VALID ONLY IF THE PRINT OF SAME HAS THE ORIGINAL SIGNATURE AND SEAL OF THE SURVEYOR.
4) ALL ELEVATIONS ARE BASED ON (NAVD 88).
5) ALL COORDINATES SHOWN ARE BASED ON THE NORTH CAROLINA STATE PLANE COORDINATE SYSTEM NAD1983(2011). DISTANCES SHOWN ARE HORIZONTAL DISTANCES NOT GRID DISTANCES.

WATER & SEWER
RECORD DRAWING
OF

CALABASH POINTE PHASE 1

SHALOTTE TOWNSHIP
BRUNSWICK COUNTY, NORTH CAROLINA

prepared for
LENNAR CAROLINAS, LLC

No.	Revision	By	Date
1	ADDED PUMP CURVE RESULTS	DOB	3/3/26

THOMAS & HUTTON
611 Burroughs & Chapin Blvd. • Suite 202
Myrtle Beach, SC 29577 • 843.839-3545
www.thomasandhutton.com

30 0 30 60
1 INCH = 30 FEET

plat	drawn	reviewed	field	crew
2/9/26	DOB	JC/MDS	2/26	DH

job 31725-SEWER

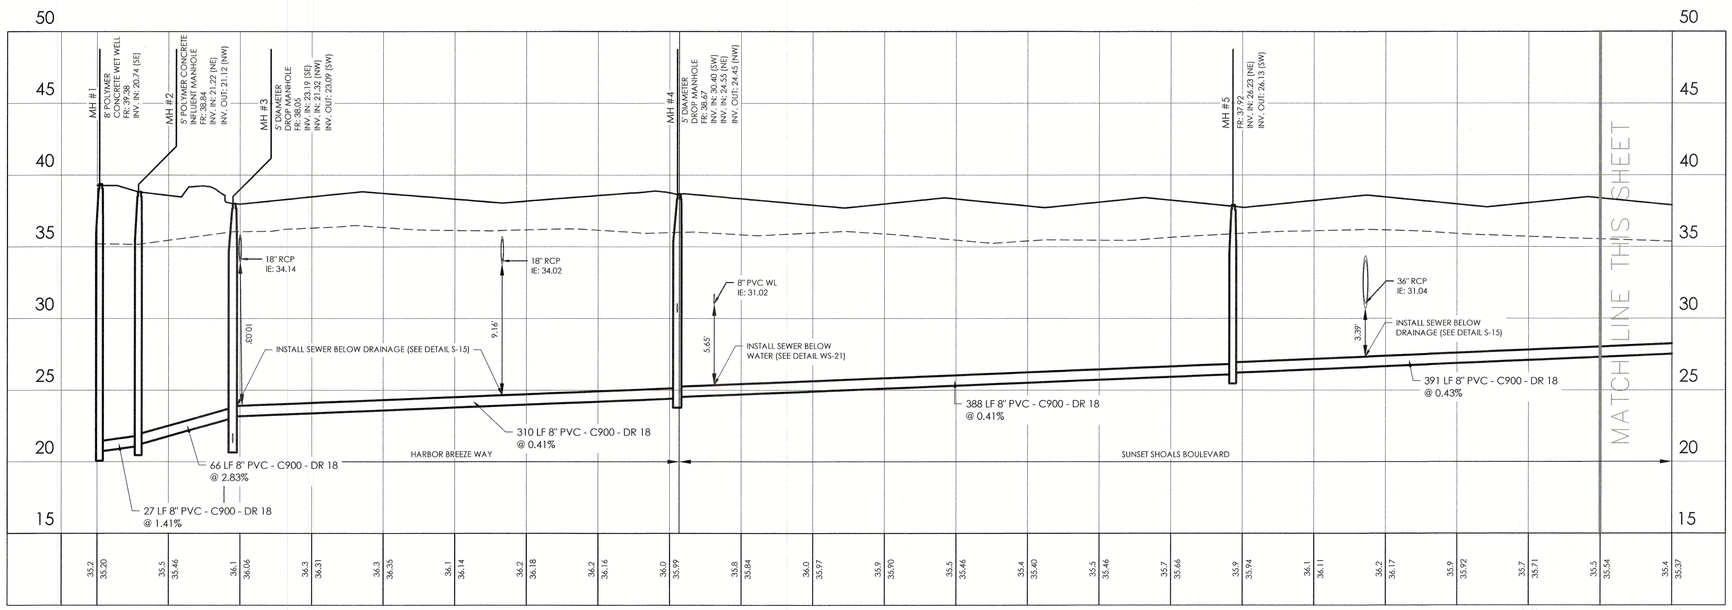

31725.0000 - Sewer - Run 1

STATIONS: -0+25 - 11+00
SCALE: HORZ.: 1" = 50'
VERT.: 1" = 5'

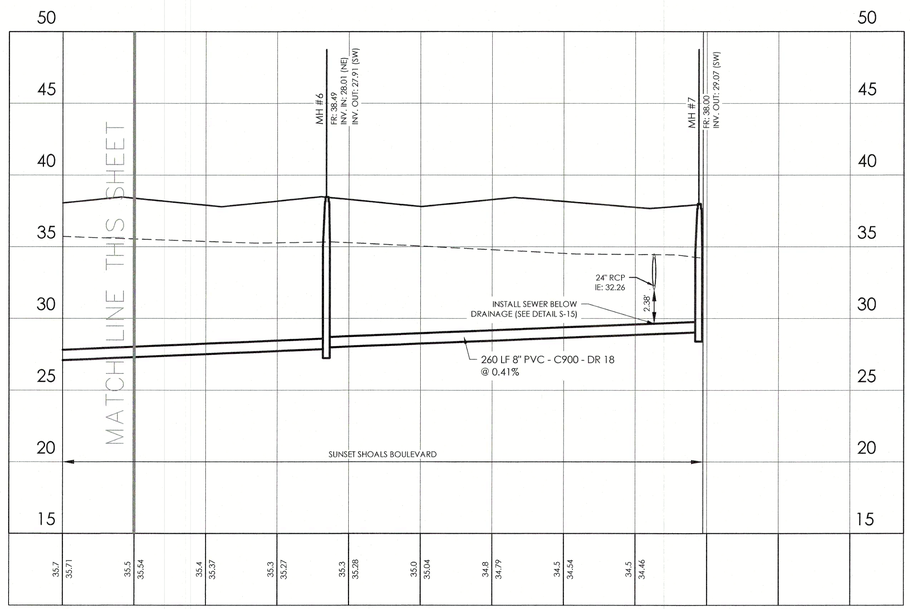

31725.0000 - Sewer - Run 1

STATIONS: 10+00 - 15+50
SCALE: HORZ.: 1" = 50'
VERT.: 1" = 5'

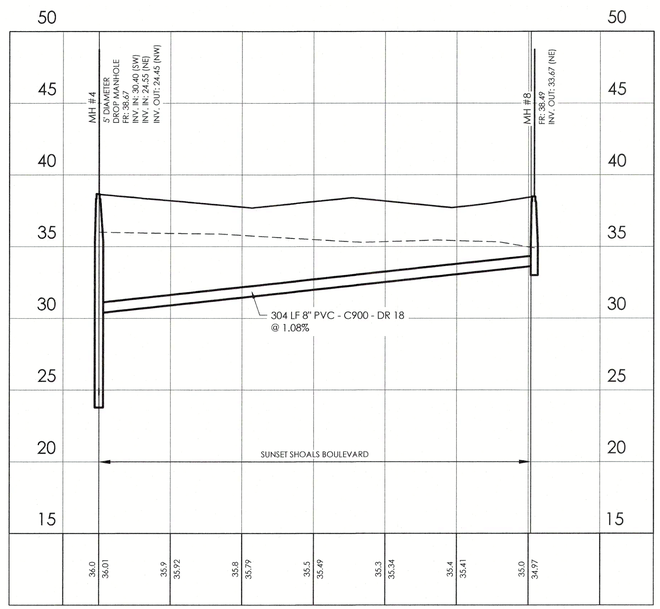

31725.0000 - Sewer - Run 2

STATIONS: -0+25 - 3+50
SCALE: HORZ.: 1" = 50'
VERT.: 1" = 5'

PROPOSED GRADE
EXISTING GRADE

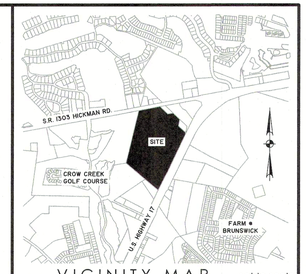

VICINITY MAP not to scale

This document and all reproducible copies of this document are the property of Thomas & Hutton. Reproduction of this document is not permitted without written consent of Thomas & Hutton unless this document becomes a matter of public record. ALTERATIONS TO THIS DOCUMENT ARE NOT PERMITTED.

THOMAS & HUTTON ENGINEERING CO. No. F-0871 CERTIFICATE OF AUTHORIZATION

NORTH CAROLINA PROFESSIONAL SEAL 53169 ENGINEER NATHAN T. POUND

THE FACILITIES HAVE BEEN CONSTRUCTED AS SHOWN ON THE "RECORD DRAWING" PLAN, AND THE FACILITIES MEET THE APPROVED WATER AND WASTEWATER PLAN AND SPECIFICATIONS OR ACHIEVE THE FUNCTION FOR WHICH THEY WERE DESIGNED.

THOMAS & HUTTON ENGINEERING CO. No. F-0871 CERTIFICATE OF AUTHORIZATION

NORTH CAROLINA PROFESSIONAL SEAL L-5564 LAND SURVEYOR MATTHEW D. SVEJKOVSKY

I, MATTHEW D. SVEJKOVSKY, CERTIFY THAT THIS WATER & WASTE WATER SYSTEM RECORD DRAWING IS DRAWN UNDER MY DIRECT SUPERVISION, AND BASED ON A FIELD SURVEY BY THOMAS AND HUTTON; THAT THE FIELDWORK WAS COMPLETED ON 5TH DAY OF FEBRUARY 2026; THAT THE BOUNDARY LINES SHOWN ARE COMPILED FROM PREVIOUSLY RECORDED MAPS. WITNESS MY HAND AND SEAL THIS 3RD DAY OF MARCH 2026.

3/3/26

MATTHEW D. SVEJKOVSKY NC PROFESSIONAL LAND SURVEYOR
LICENSE NO. L-5564

WATER & SEWER RECORD DRAWING OF

CALABASH POINTE PHASE 1

SHALOTTE TOWNSHIP
BRUNSWICK COUNTY, NORTH CAROLINA

prepared for
LENNAR CAROLINAS, LLC

No.	Revision	By	Date

THOMAS & HUTTON

611 Burroughs & Chapin Blvd. • Suite 202
Myrtle Beach, SC 29577 • 843.839-3545

www.thomasandhutton.com

30 0 30 60
1 INCH = 30 FEET

plat	drawn	reviewed	field	crew
2/9/26	DOB	JC/MDS	2/26	DH

job 31725-SEWER

PROPOSED GRADE
EXISTING GRADE

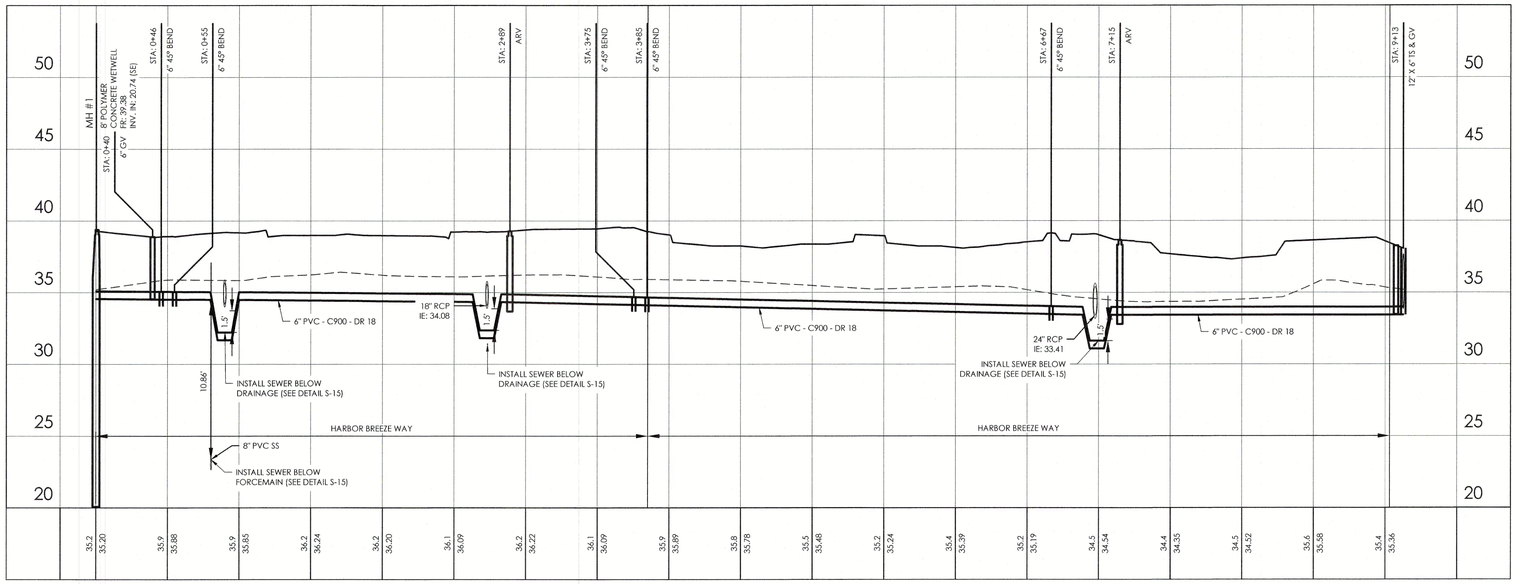

31725.0000 - Foremain - Run 1

STATIONS: -0+25 - 9+50
SCALE: HORZ.: 1" = 50'
VERT.: 1" = 5'

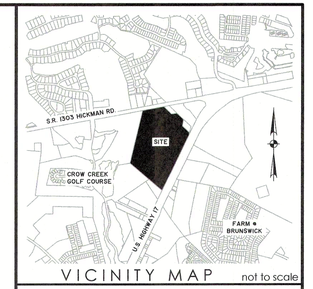

VICINITY MAP not to scale

this document and all reproducible copies of this document are the property of Thomas & Hutton. Reproduction of this document is not permitted without written consent of Thomas & Hutton unless this document becomes a matter of public record. ALTERATIONS TO THIS DOCUMENT ARE NOT PERMITTED.

NORTH CAROLINA
THOMAS & HUTTON ENGINEERING CO.
No. F-0871
CERTIFICATE OF AUTHORIZATION

NORTH CAROLINA
PROFESSIONAL
SEAL
53169
ENGINEER
NATHAN T. POUND

THE FACILITIES HAVE BEEN CONSTRUCTED AS SHOWN ON THE "RECORD DRAWING" PLAN, AND THE FACILITIES MEET THE APPROVED WATER AND WASTEWATER PLAN AND SPECIFICATIONS OR ACHIEVE THE FUNCTION FOR WHICH THEY WERE DESIGNED.

NORTH CAROLINA
THOMAS & HUTTON ENGINEERING CO.
No. F-0871
CERTIFICATE OF AUTHORIZATION

NORTH CAROLINA
PROFESSIONAL
SEAL
L-5564
LAND SURVEYOR
MATTHEW D. SVEJKOVSKY

I, MATTHEW D. SVEJKOVSKY, CERTIFY THAT THIS WATER & WASTE WATER SYSTEM RECORD DRAWING IS DRAWN UNDER MY DIRECT SUPERVISION, AND BASED ON A FIELD SURVEY BY THOMAS AND HUTTON; THAT THE FIELDWORK WAS COMPLETED ON 5TH DAY OF FEBRUARY 2026; THAT THE BOUNDARY LINES SHOWN ARE COMPILED FROM PREVIOUSLY RECORDED MAPS. WITNESS MY HAND AND SEAL THIS 3RD DAY OF MARCH 2026.

MATTHEW D. SVEJKOVSKY N.C. PROFESSIONAL LAND SURVEYOR
LICENSE NO. L-5564

WATER & SEWER
RECORD DRAWING
OF

CALABASH POINTE PHASE 1

SHALOTTE TOWNSHIP
BRUNSWICK COUNTY, NORTH CAROLINA

prepared for
LENNAR CAROLINAS, LLC

No.	Revision	By	Date

THOMAS & HUTTON
611 Burroughs & Chapin Blvd. • Suite 202
Myrtle Beach, SC 29577 • 843.839-3545
www.thomasandhutton.com

50 0 50 100
1 INCH = 50 FEET

plat	drawn	reviewed	field	crew
2/9/26	DOB	JC/MDS	2/26	DH

job 31725-SEWER

COUNTY OF BRUNSWICK

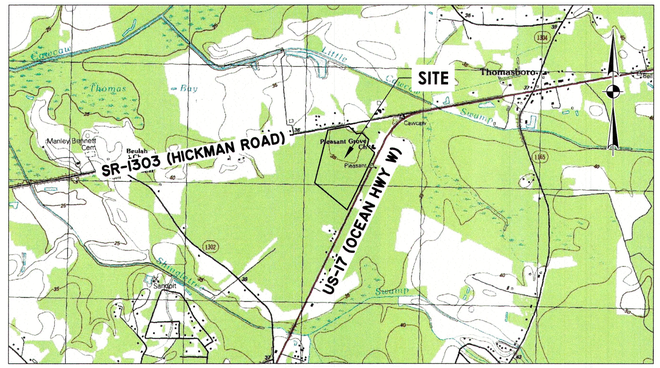

VICINITY MAP
(Not to Scale)

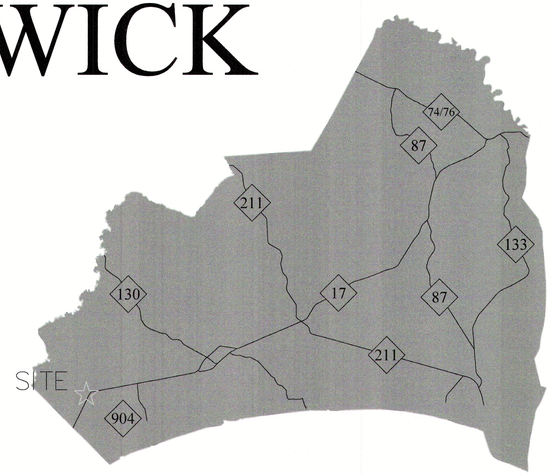

PARCEL ID #: 22500035

CALABASH POINTE
PHASE 2
WATER & SEWER
RECORD DRAWINGS

OWNER

LENNAR CAROLINAS, LLC
1359 21ST AVENUE NORTH
SUITE 105
MYRTLE BEACH,
SOUTH CAROLINA
29577

ENGINEER / SURVEYOR

THOMAS & HUTTON

INDEX OF SHEETS

Sheet List Table

Sheet Number	Sheet Title
C0	Brunswick County Cover Sheet
SH1	WATER
SH2	SEWER
SH3	SEWER PROFILES

NUMBER	DATE	BY	REVISION DESCRIPTION

APPROVAL STATUS	DATE	BY	DEPARTMENT
☐ YES ☐ NO ☐ N/A			PLANNING
☐ YES ☐ NO ☐ N/A			ENGINEERING
☐ YES ☐ NO ☐ N/A			PUBLIC UTILITIES

"ENGINEER'S CERTIFICATION OF COMPLIANCE WITH BRUNSWICK COUNTY SPECIFICATIONS AND DETAILS"

I hereby certify that the plans, details, and associated project specifications comply with the latest version, as of this date, of Brunswick County's Standard Specifications and Standard Details per standard engineering practice. Furthermore, I confirm my understanding that reviews and approvals by Brunswick County personnel do not imply that Brunswick County personnel have reviewed and are in agreement with every portion of the plans and specifications that I have submitted. I understand that Brunswick County reviews and approvals are meant to ensure that the overall plans are in general compliance with County objectives. I understand that it is my full responsibility to ensure that plans and specifications are in full compliance with applicable County, State, Federal, and other municipal requirements. Additionally, I understand that the County will not assume operation, maintenance, or ownership of constructed facilities that do not meet County requirements and the County may refuse to issue permits at facilities that the County deems are non-compliant with County Specifications. I also confirm my understanding that County Inspections are for the sole use of the County and I certify that I will not use, or direct others to use, County inspections for State compliance purposes or any other purpose."

DATE: 3/30/26

SUBMITTAL: FINAL

PROJECT NAME: Calabash Pointe
LOCATION: Brunswick County, North Carolina
OWNER: Lennar Carolinas, LLC.
DESIGNER: Thomas & Hutton

NORTH CAROLINA PROFESSIONAL SEAL 053169 ENGINEER NATHAN T. POUND

THOMAS & HUTTON ENGINEERING CO. No. F-0871 CERTIFICATE OF AUTHORIZATION

TECH: DOB

DES: WPH

CHK: NTP

PROJECT NO. 31725.0000

SHEET NO. C0

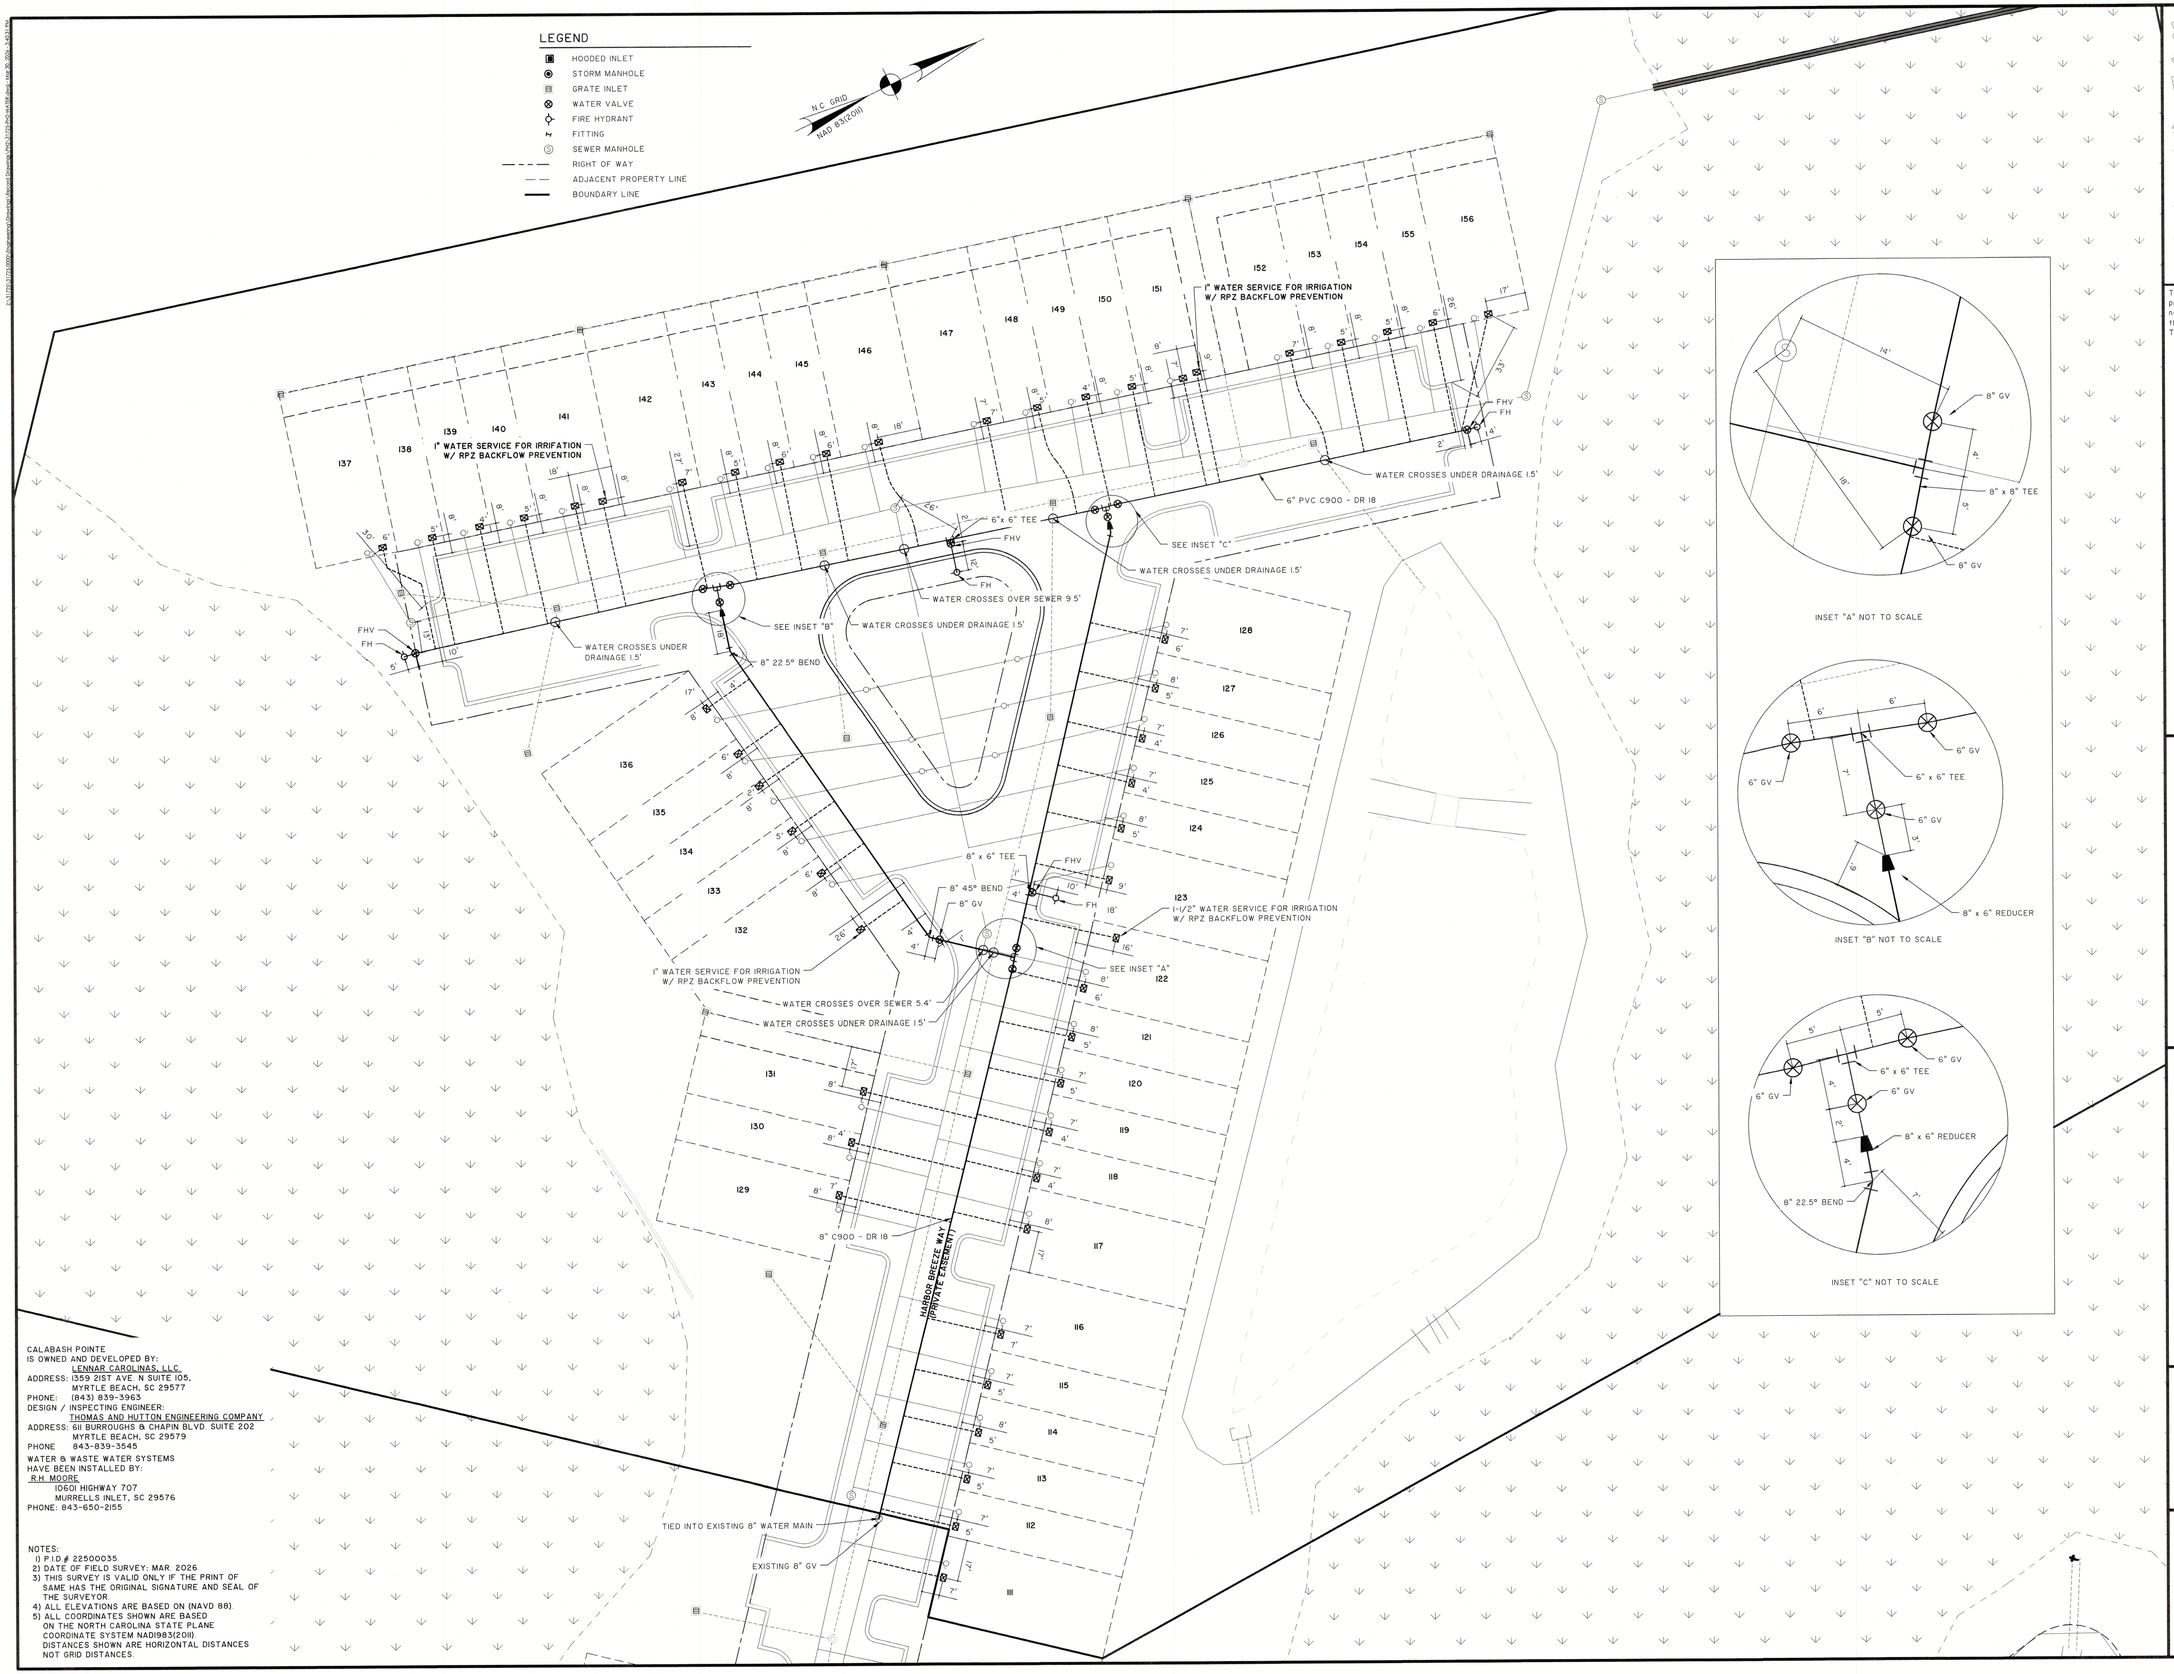

INSET "A" NOT TO SCALE

INSET "B" NOT TO SCALE

INSET "C" NOT TO SCALE

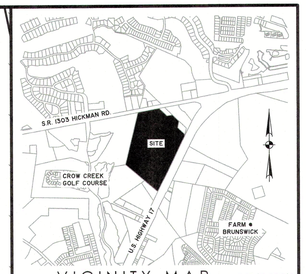

VICINITY MAP not to scale

This document and all reproducible copies of this document are the property of Thomas & Hutton. Reproduction of this document is not permitted without written consent of Thomas & Hutton unless this document becomes a matter of public record. ALTERATIONS TO THIS DOCUMENT ARE NOT PERMITTED.

NORTH CAROLINA CERTIFICATE OF AUTHORIZATION THOMAS & HUTTON ENGINEERING CO. No. F-0871

NORTH CAROLINA PROFESSIONAL SEAL 53169 ENGINEER NATHAN T. POUND 3/30/26

THE FACILITIES HAVE BEEN CONSTRUCTED AS SHOWN ON THE "RECORD DRAWING" PLAN, AND THE FACILITIES MEET THE APPROVED WATER AND WASTEWATER PLAN AND SPECIFICATIONS OR ACHIEVE THE FUNCTION FOR WHICH THEY WERE DESIGNED.

NORTH CAROLINA CERTIFICATE OF AUTHORIZATION THOMAS & HUTTON ENGINEERING CO. No. F-0871

NORTH CAROLINA PROFESSIONAL SEAL L-5564 LAND SURVEYOR MATTHEW D. SVEJKOVSKY 3-30-26

I, MATTHEW D. SVEJKOVSKY, CERTIFY THAT THIS WATER & WASTE WATER SYSTEM RECORD DRAWING IS DRAWN UNDER MY DIRECT SUPERVISION, AND BASED ON A FIELD SURVEY BY THOMAS AND HUTTON, THAT THE FIELDWORK WAS COMPLETED ON 17TH DAY OF MARCH 2026; THAT THE BOUNDARY LINES SHOWN ARE COMPILED FROM PREVIOUSLY RECORDED MAPS. WITNESS MY HAND AND SEAL THIS 23RD DAY OF MARCH 2026.

Matthew D. Svejkovsky

MATTHEW D. SVEJKOVSKY N.C. PROFESSIONAL LAND SURVEYOR
LICENSE NO. L-5564

CALABASH POINTE
IS OWNED AND DEVELOPED BY:
LENNAR CAROLINAS, LLC.
ADDRESS: 1359 21ST AVE N SUITE 105,
MYRTLE BEACH, SC 29577
PHONE: (843) 839-3963
DESIGN / INSPECTING ENGINEER:
THOMAS AND HUTTON ENGINEERING COMPANY
ADDRESS: 611 BURROUGHS & CHAPIN BLVD. SUITE 202
MYRTLE BEACH, SC 29579
PHONE 843-839-3545
WATER & WASTE WATER SYSTEMS
HAVE BEEN INSTALLED BY:
R.H. MOORE
10601 HIGHWAY 707
MURRELLS INLET, SC 29576
PHONE: 843-650-2155

NOTES:
1) P.I.D.# 225000035.
2) DATE OF FIELD SURVEY: MAR. 2026
3) THIS SURVEY IS VALID ONLY IF THE PRINT OF SAME HAS THE ORIGINAL SIGNATURE AND SEAL OF THE SURVEYOR.
4) ALL ELEVATIONS ARE BASED ON (NAVD 88).
5) ALL COORDINATES SHOWN ARE BASED ON THE NORTH CAROLINA STATE PLANE COORDINATE SYSTEM NAD1983(2011) DISTANCES SHOWN ARE HORIZONTAL DISTANCES NOT GRID DISTANCES.

WATER & SEWER
RECORD DRAWING
OF

CALABASH POINTE PHASE 2

SHALOTTE TOWNSHIP
BRUNSWICK COUNTY, NORTH CAROLINA

prepared for
LENNAR CAROLINAS, LLC

No.	Revision	By	Date

THOMAS & HUTTON
611 Burroughs & Chapin Blvd. • Suite 202
Myrtle Beach, SC 29577 • 843.839-3545
www.thomasandhutton.com

30 0 30 60
1 INCH = 30 FEET

plat	drawn	reviewed	field	crew
3/30/26	DOB	JC/MDS	3/26	HR

job 31725-PH2-SEWER

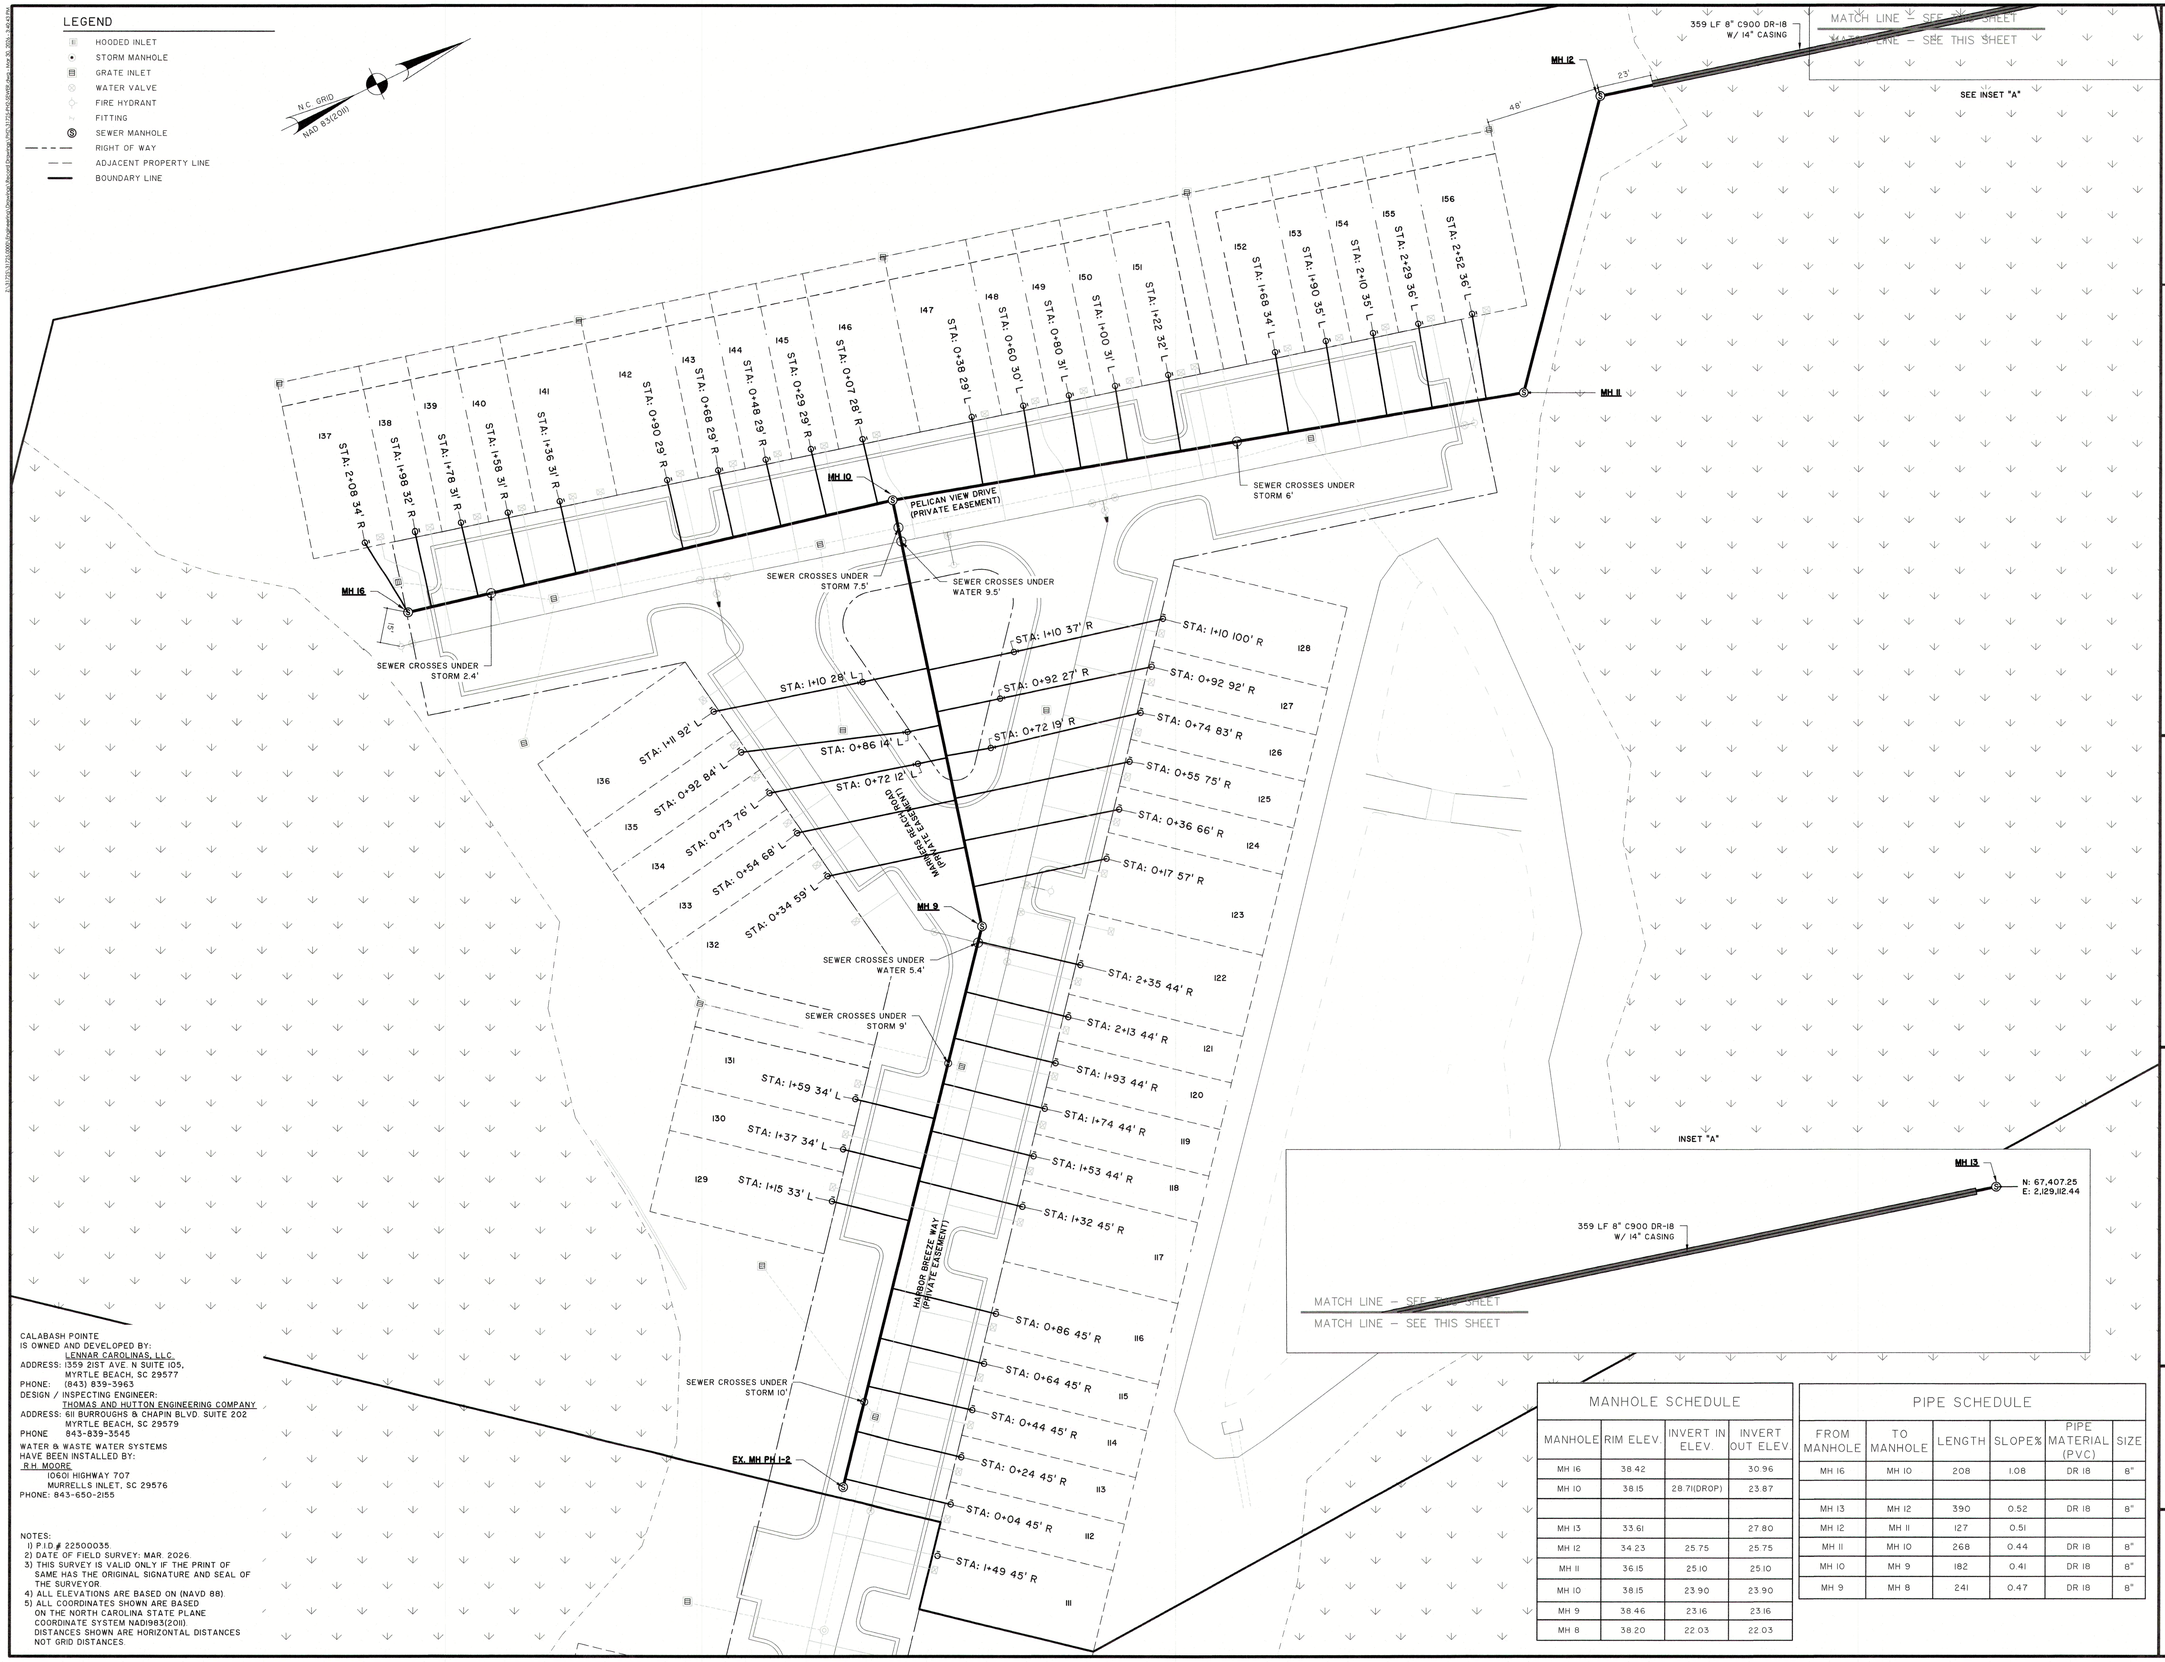

CALABASH POINTE
IS OWNED AND DEVELOPED BY:
LENNAR CAROLINAS, LLC
ADDRESS: 1359 21ST AVE. N SUITE 105,
MYRTLE BEACH, SC 29577
PHONE: (843) 839-3963
DESIGN / INSPECTING ENGINEER:
THOMAS AND HUTTON ENGINEERING COMPANY
ADDRESS: 611 BURROUGHS & CHAPIN BLVD. SUITE 202
MYRTLE BEACH, SC 29579
PHONE 843-839-3545
WATER & WASTE WATER SYSTEMS
HAVE BEEN INSTALLED BY:
R.H. MOORE
10601 HIGHWAY 707
MURRELLS INLET, SC 29576
PHONE: 843-650-2155

NOTES:
1) P.I.D.# 22500035.
2) DATE OF FIELD SURVEY: MAR. 2026.
3) THIS SURVEY IS VALID ONLY IF THE PRINT OF SAME HAS THE ORIGINAL SIGNATURE AND SEAL OF THE SURVEYOR.
4) ALL ELEVATIONS ARE BASED ON (NAVD 88).
5) ALL COORDINATES SHOWN ARE BASED ON THE NORTH CAROLINA STATE PLANE COORDINATE SYSTEM NAD1983(2011). DISTANCES SHOWN ARE HORIZONTAL DISTANCES NOT GRID DISTANCES.

MANHOLE SCHEDULE

MANHOLE	RIM ELEV.	INVERT IN ELEV.	INVERT OUT ELEV.
MH 16	38.42		30.96
MH 10	38.15	28.71(DROP)	23.87
MH 13	33.61		27.80
MH 12	34.23	25.75	25.75
MH 11	36.15	25.10	25.10
MH 10	38.15	23.90	23.90
MH 9	38.46	23.16	23.16
MH 8	38.20	22.03	22.03

PIPE SCHEDULE

FROM MANHOLE	TO MANHOLE	LENGTH	SLOPE%	PIPE MATERIAL (PVC)	SIZE
MH 16	MH 10	208	1.08	DR 18	8"
MH 13	MH 12	390	0.52	DR 18	8"
MH 12	MH 11	127	0.51		
MH 11	MH 10	268	0.44	DR 18	8"
MH 10	MH 9	182	0.41	DR 18	8"
MH 9	MH 8	241	0.47	DR 18	8"

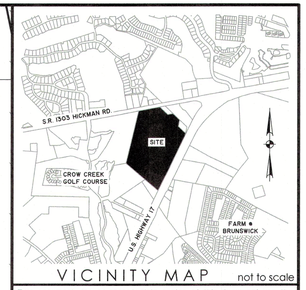

VICINITY MAP not to scale

This document and all reproducible copies of this document are the property of Thomas & Hutton. Reproduction of this document is not permitted without written consent of Thomas & Hutton unless this document becomes a matter of public record. ALTERATIONS TO THIS DOCUMENT ARE NOT PERMITTED.

NORTH CAROLINA
THOMAS & HUTTON ENGINEERING CO.
No. F-0871
CERTIFICATE OF AUTHORIZATION

NORTH CAROLINA
PROFESSIONAL
SEAL
L-5189
3/30/26
ENGINEER
NATHAN T. POUND

THE FACILITIES HAVE BEEN CONSTRUCTED AS SHOWN ON THE "RECORD DRAWING" PLAN, AND THE FACILITIES MEET THE APPROVED WATER AND WASTEWATER PLAN AND SPECIFICATIONS OR ACHIEVE THE FUNCTION FOR WHICH THEY WERE DESIGNED.

NORTH CAROLINA
THOMAS & HUTTON ENGINEERING CO.
No. F-0871
CERTIFICATE OF AUTHORIZATION

NORTH CAROLINA
PROFESSIONAL
SEAL
L-5564
3-30-26
LAND SURVEYOR
MATTHEW D. SVEJKOVSKY

I, MATTHEW D. SVEJKOVSKY, CERTIFY THAT THIS WATER & WASTE WATER SYSTEM RECORD DRAWING IS DRAWN UNDER MY DIRECT SUPERVISION, AND BASED ON A FIELD SURVEY BY THOMAS AND HUTTON; THAT THE FIELDWORK WAS COMPLETED ON 17TH DAY OF MARCH 2026; THAT THE BOUNDARY LINES SHOWN ARE COMPILED FROM PREVIOUSLY RECORDED MAPS. WITNESS MY HAND AND SEAL THIS 23RD DAY OF MARCH 2026.

Matthew D. Svejkovsky

MATTHEW D. SVEJKOVSKY N.C. PROFESSIONAL LAND SURVEYOR
LICENSE NO. L-5564

WATER & SEWER
RECORD DRAWING
OF

CALABASH POINTE PHASE 2

SHALLOTTE TOWNSHIP
BRUNSWICK COUNTY, NORTH CAROLINA

prepared for
LENNAR CAROLINAS, LLC

No.	Revision	By	Date

THOMAS & HUTTON
611 Burroughs & Chapin Blvd. • Suite 202
Myrtle Beach, SC 29577 • 843.839-3545
www.thomasandhutton.com

30 0 30 60
1 INCH = 30 FEET

plat	drawn	reviewed	field	crew
3/30/26	DOB	JC/MDS	3/26	HR

job 31725-PH2-SEWER

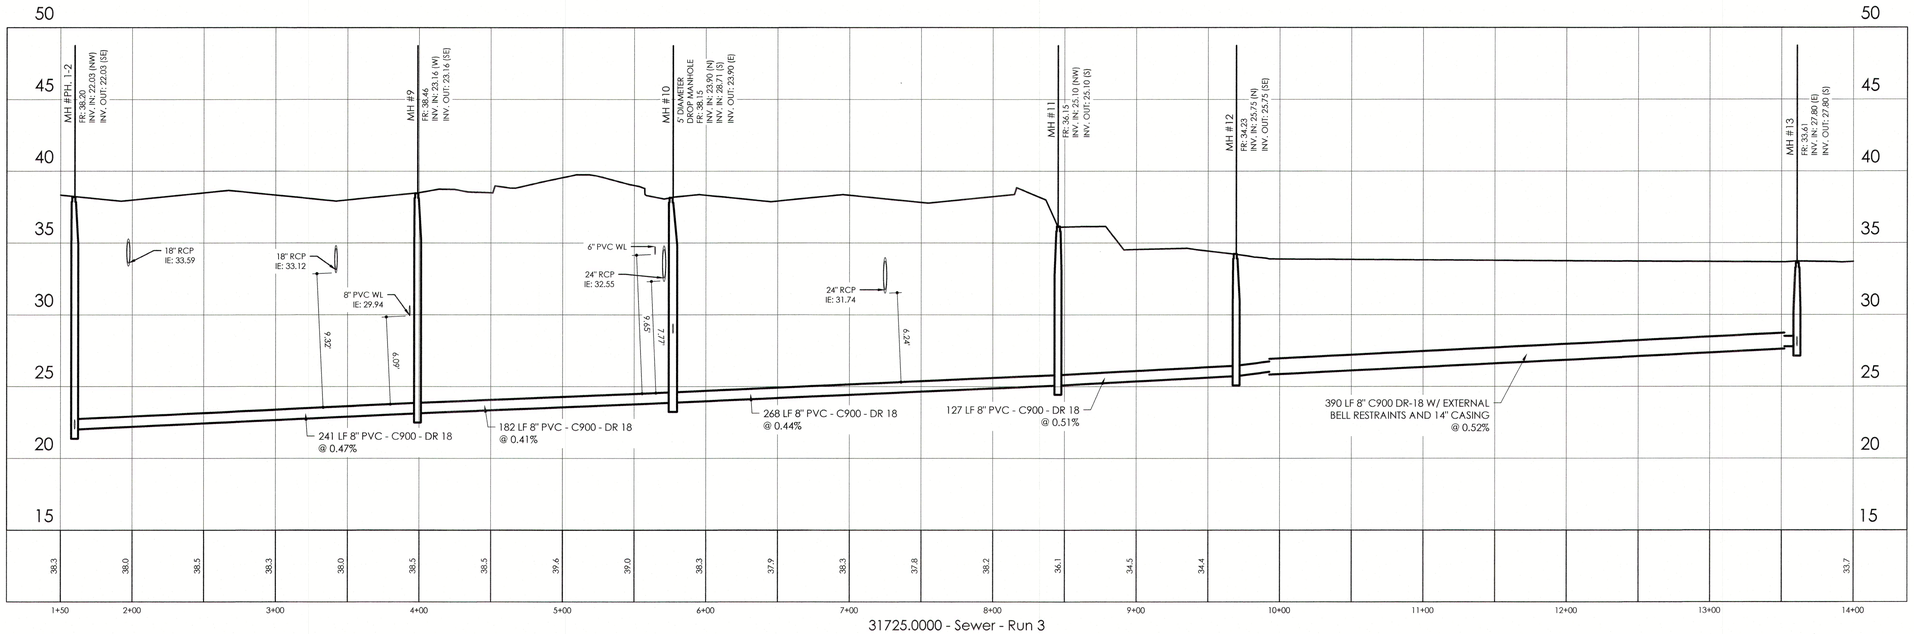

31725.0000 - Sewer - Run 3

STATIONS: 1+50 - 14+00
SCALE: HORZ.: 1" = 50'
VERT.: 1" = 5'

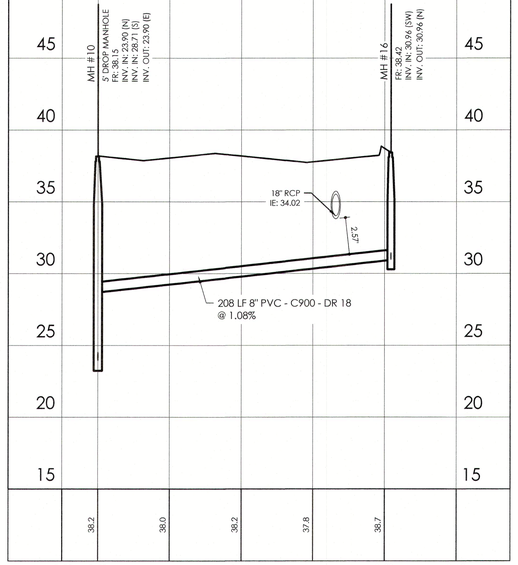

31725.0000 - Sewer - Run 4

STATIONS: -0+25 - 2+50
SCALE: HORZ.: 1" = 50'
VERT.: 1" = 5'

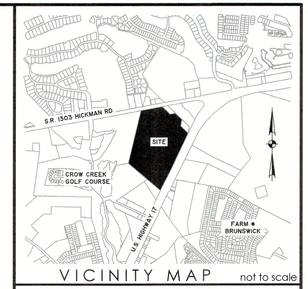

VICINITY MAP not to scale

This document and all reproducible copies of this document are the property of Thomas & Hutton. Reproduction of this document is not permitted without written consent of Thomas & Hutton unless this document becomes a matter of public record. ALTERATIONS TO THIS DOCUMENT ARE NOT PERMITTED.

NORTH CAROLINA THOMAS & HUTTON ENGINEERING CO No. F-0871 CERTIFICATE OF AUTHORIZATION

NORTH CAROLINA PROFESSIONAL SEAL L-5564 ENGINEER NATHAN T. POUND 3/31/26

THE FACILITIES HAVE BEEN CONSTRUCTED AS SHOWN ON THE "RECORD DRAWING" PLAN, AND THE FACILITIES MEET THE APPROVED WATER AND WASTEWATER PLAN AND SPECIFICATIONS OR ACHIEVE THE FUNCTION FOR WHICH THEY WERE DESIGNED.

NORTH CAROLINA THOMAS & HUTTON ENGINEERING CO No. F-0871 CERTIFICATE OF AUTHORIZATION

NORTH CAROLINA PROFESSIONAL SEAL L-5564 3-30-26 LAND SURVEYOR MATTHEW D. SVEJKOVSKY

I, MATTHEW D. SVEJKOVSKY, CERTIFY THAT THIS WATER & WASTE WATER SYSTEM RECORD DRAWING IS DRAWN UNDER MY DIRECT SUPERVISION, AND BASED ON A FIELD SURVEY BY THOMAS AND HUTTON; THAT THE FIELDWORK WAS COMPLETED ON 17TH DAY OF MARCH 2026; THAT THE BOUNDARY LINES SHOWN ARE COMPILED FROM PREVIOUSLY RECORDED MAPS. WITNESS MY HAND AND SEAL THIS 23RD DAY OF MARCH 2026.

MATTHEW D. SVEJKOVSKY N.C. PROFESSIONAL LAND SURVEYOR
LICENSE NO. L-5564

WATER & SEWER
RECORD DRAWING
OF

CALABASH POINTE PHASE 2

SHALOTTE TOWNSHIP
BRUNSWICK COUNTY, NORTH CAROLINA

prepared for
LENNAR CAROLINAS, LLC

No.	Revision	By	Date

THOMAS & HUTTON

611 Burroughs & Chapin Blvd. • Suite 202
Myrtle Beach, SC 29577 • 843.839-3545

www.thomasandhutton.com

50 0 50 100
1 INCH = 50 FEET

plat	drawn	reviewed	field	crew
3/30/26	DOB	JC/MDS	3/26	HR

job 31725-PH2-SEWER

COUNTY OF BRUNSWICK

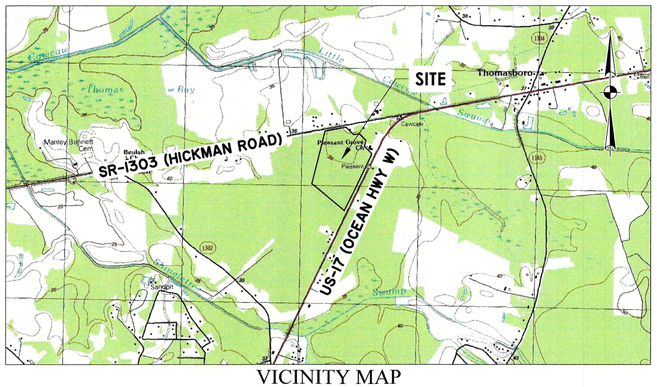

VICINITY MAP
(Not to Scale)

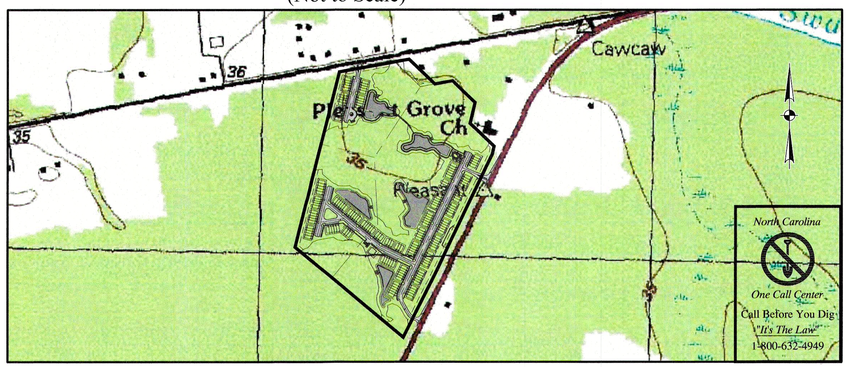

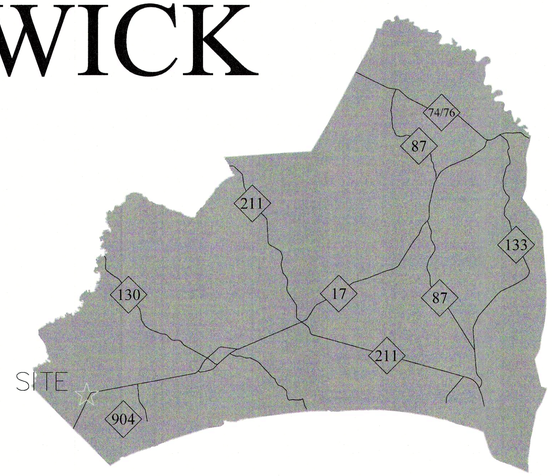

PARCEL ID #: 22500035

CALABASH POINTE
PHASE 3
WATER & SEWER
RECORD DRAWINGS

OWNER

LENNAR CAROLINAS, LLC
1359 21ST AVENUE NORTH
SUITE 105
MYRTLE BEACH,
SOUTH CAROLINA
29577

ENGINEER / SURVEYOR

THOMAS & HUTTON

INDEX OF SHEETS

Sheet List Table

Sheet Number	Sheet Title
C0	Brunswick County Cover Sheet
SH1	WATER
SH2	SEWER
SH3	SEWER PROFILES

NUMBER	DATE	BY	REVISION DESCRIPTION

APPROVAL STATUS	DATE	BY	DEPARTMENT
☐ YES ☐ NO ☐ N/A			PLANNING
☐ YES ☐ NO ☐ N/A			ENGINEERING
☐ YES ☐ NO ☐ N/A			PUBLIC UTILITIES

"ENGINEER'S CERTIFICATION OF COMPLIANCE WITH BRUNSWICK COUNTY SPECIFICATIONS AND DETAILS"
I hereby certify that the plans, details, and associated project specifications comply with the latest version, as of this date, of Brunswick County's Standard Specifications and Standard Details per standard engineering practice. Furthermore, I confirm my understanding that reviews and approvals by Brunswick County personnel do not imply that Brunswick County personnel have reviewed and are in agreement with every portion of the plans and specifications that I have submitted. I understand that Brunswick County reviews and approvals are meant to ensure that the overall plans are in general compliance with County objectives. I understand that it is my full responsibility to ensure that plans and specifications are in full compliance with applicable County, State, Federal, and other municipal requirements. Additionally, I understand that the County will not assume operation, maintenance, or ownership of constructed facilities that do not meet County requirements and the County may refuse to issue permits at facilities that the County deems are non-compliant with County Specifications. I also confirm my understanding that County Inspections are for the sole use of the County and I certify that I will not use, or direct others to use, County inspections for State compliance purposes or any other purpose."

DATE: 8/4/26

SUBMITTAL: FINAL

PROJECT NAME: Calabash Pointe
LOCATION: Brunswick County, North Carolina
OWNER: Lennar Carolinas, LLC.
DESIGNER: Thomas & Hutton

NORTH CAROLINA PROFESSIONAL SEAL 053169 ENGINEER NATHAN T. POUND

THOMAS & HUTTON ENGINEERING CO. No. F-0871 CERTIFICATE OF AUTHORIZATION

TECH: DLF

DES: WPH

CHK: NTP

PROJECT NO. 31725.0000

SHEET NO. C0

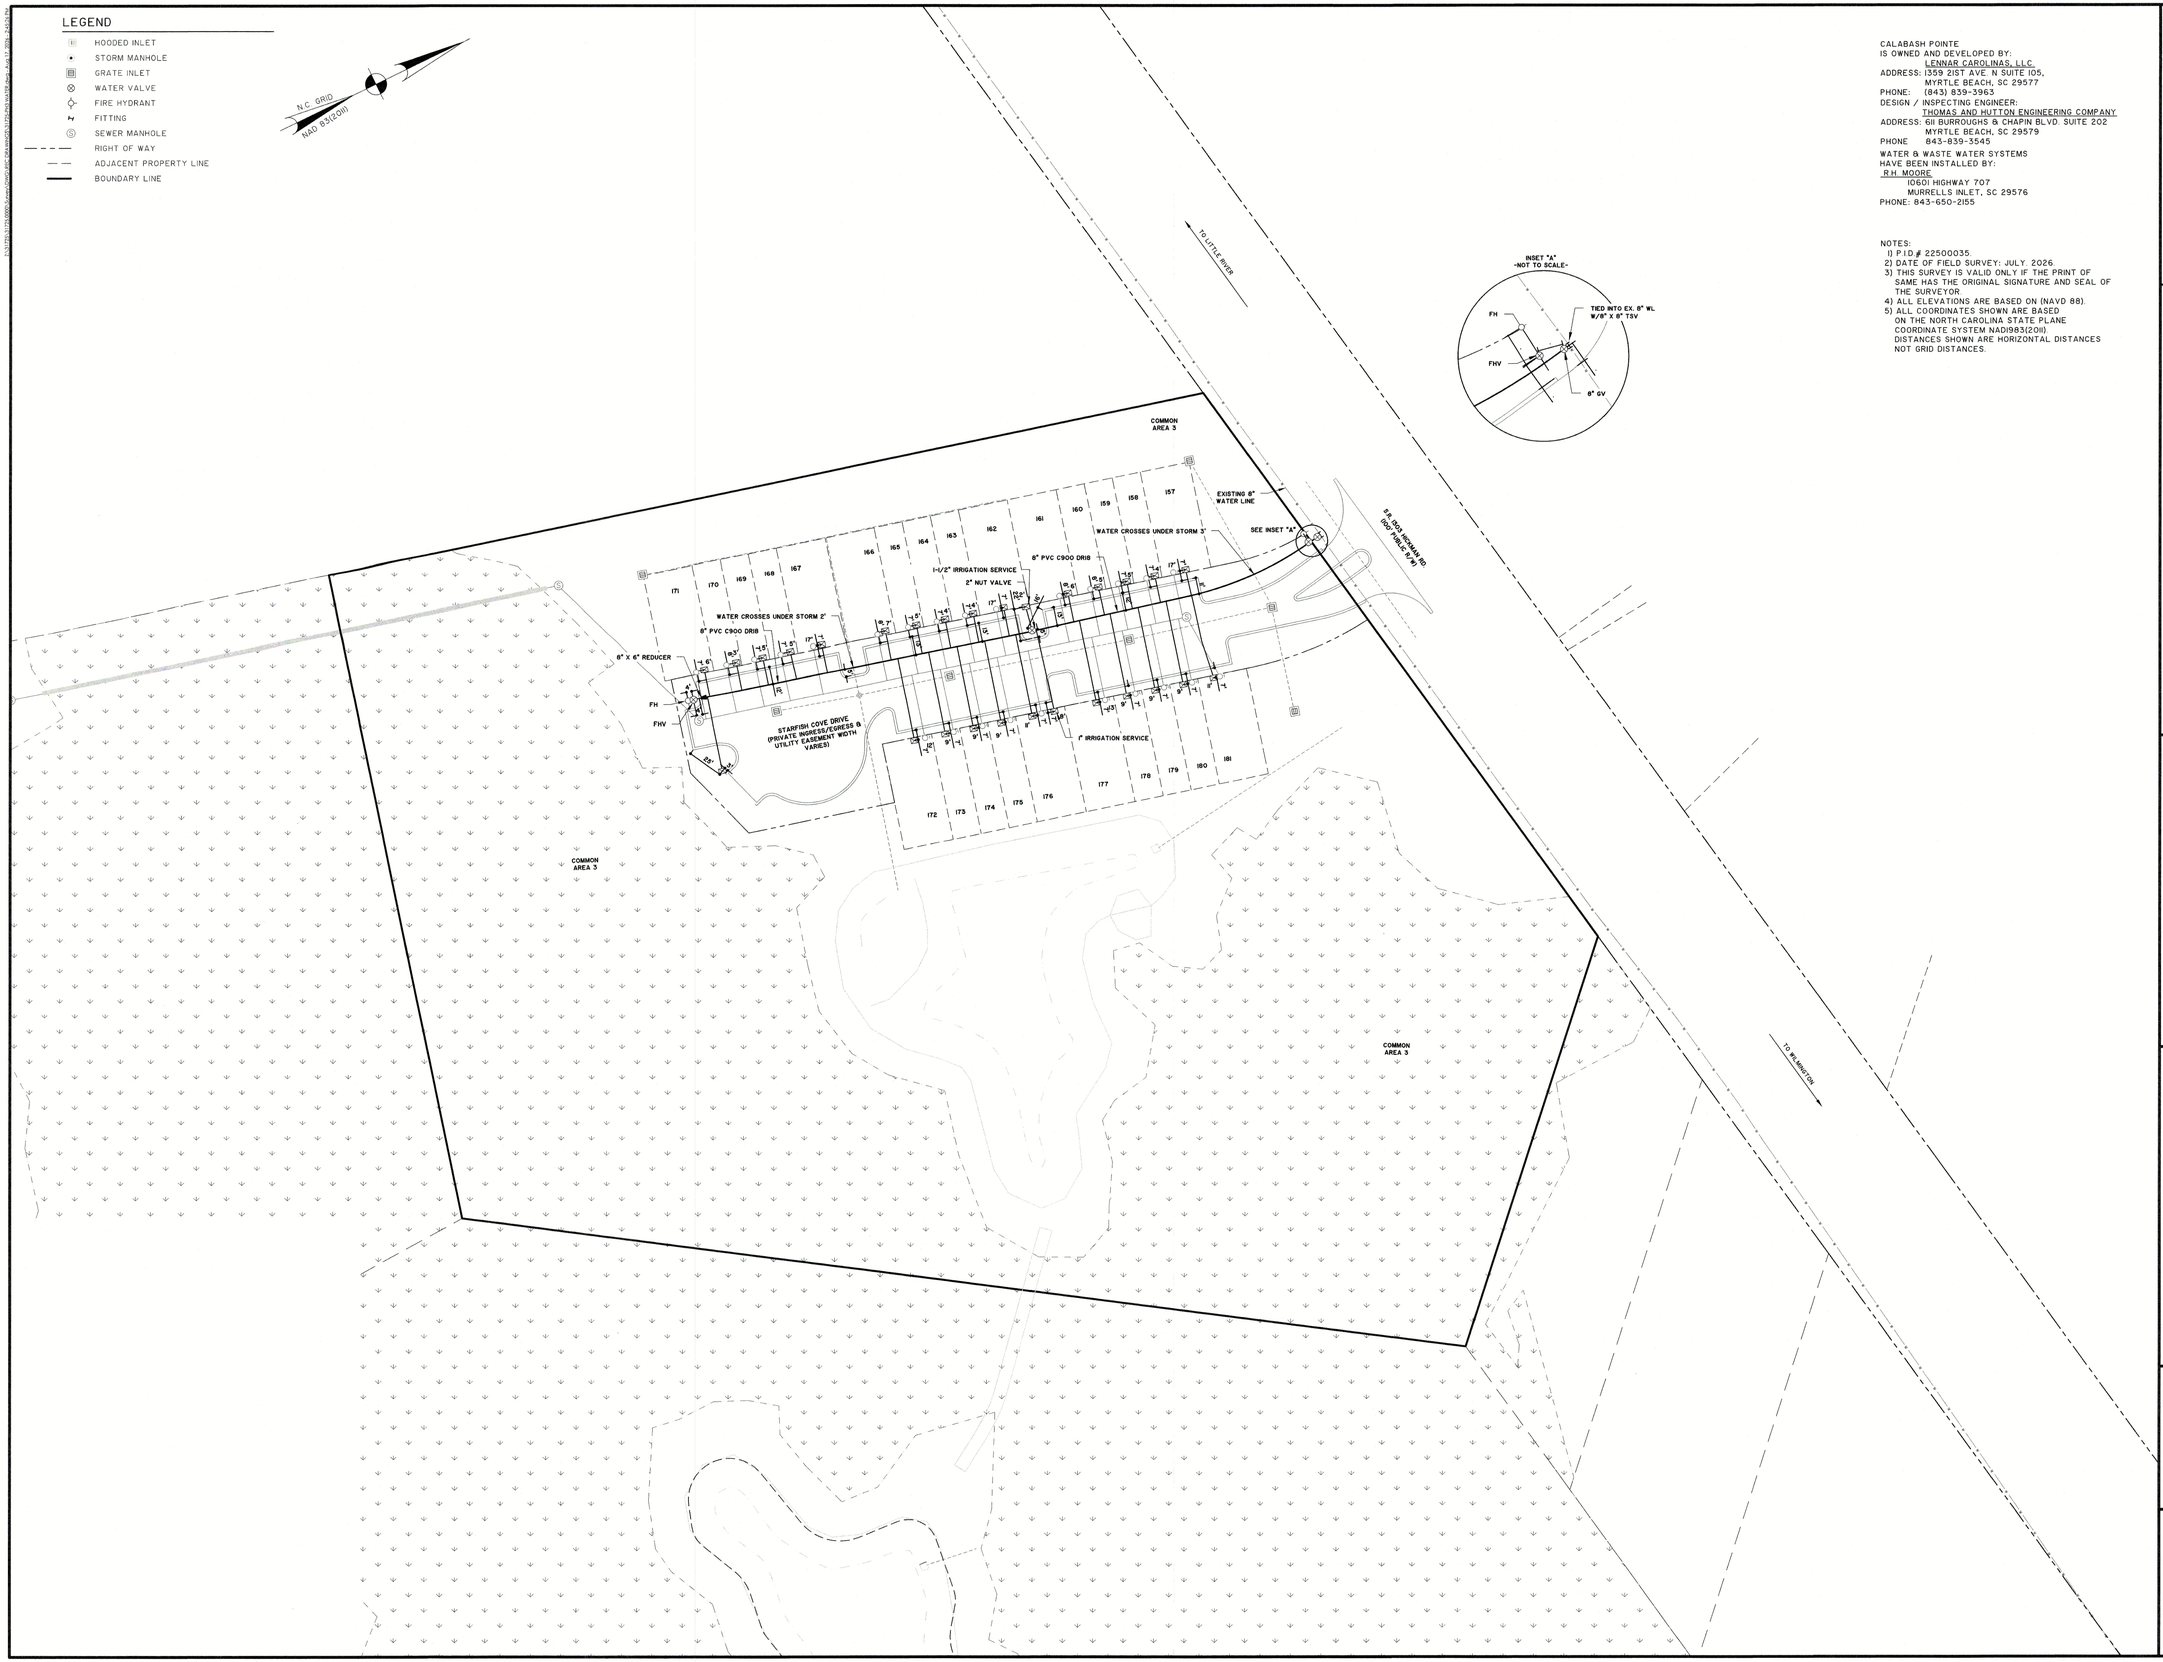

CALABASH POINTE
IS OWNED AND DEVELOPED BY:
LENNAR CAROLINAS, LLC
ADDRESS: 1359 21ST AVE. N SUITE 105,
MYRTLE BEACH, SC 29577
PHONE: (843) 839-3963
DESIGN / INSPECTING ENGINEER:
THOMAS AND HUTTON ENGINEERING COMPANY
ADDRESS: 611 BURROUGHS & CHAPIN BLVD. SUITE 202
MYRTLE BEACH, SC 29579
PHONE 843-839-3545
WATER & WASTE WATER SYSTEMS
HAVE BEEN INSTALLED BY:
R.H. MOORE
10601 HIGHWAY 707
MURRELLS INLET, SC 29576
PHONE: 843-650-2155

NOTES:
1) P.I.D.# 22500035.
2) DATE OF FIELD SURVEY: JULY, 2026.
3) THIS SURVEY IS VALID ONLY IF THE PRINT OF SAME HAS THE ORIGINAL SIGNATURE AND SEAL OF THE SURVEYOR.
4) ALL ELEVATIONS ARE BASED ON (NAVD 88).
5) ALL COORDINATES SHOWN ARE BASED ON THE NORTH CAROLINA STATE PLANE COORDINATE SYSTEM NAD(2011). DISTANCES SHOWN ARE HORIZONTAL DISTANCES NOT GRID DISTANCES.

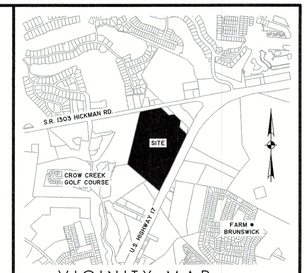

VICINITY MAP not to scale

This document and all reproducible copies of this document are the property of Thomas & Hutton. Reproduction of this document is not permitted without written consent of Thomas & Hutton unless this document becomes a matter of public record. ALTERATIONS TO THIS DOCUMENT ARE NOT PERMITTED.

NORTH CAROLINA
THOMAS & HUTTON ENGINEERING CO
No. F-0871
CERTIFICATE OF AUTHORIZATION

NORTH CAROLINA
PROFESSIONAL
SEAL
53169
ENGINEER
NATHAN T. POUND
6/4/26

THE FACILITIES HAVE BEEN CONSTRUCTED AS SHOWN ON THE "RECORD DRAWING" PLAN, AND THE FACILITIES MEET THE APPROVED WATER AND WASTEWATER PLAN AND SPECIFICATIONS OR ACHIEVE THE FUNCTION FOR WHICH THEY WERE DESIGNED.

NORTH CAROLINA
THOMAS & HUTTON ENGINEERING CO
No. F-0871
CERTIFICATE OF AUTHORIZATION

NORTH CAROLINA
PROFESSIONAL
SEAL
L-5564
LAND SURVEYOR
MATTHEW D. SVEJKOVSKY

I, MATTHEW D. SVEJKOVSKY, CERTIFY THAT THIS WATER & WASTE WATER SYSTEM RECORD DRAWING IS DRAWN UNDER MY DIRECT SUPERVISION, AND BASED ON A FIELD SURVEY BY THOMAS AND HUTTON; THAT THE FIELDWORK WAS COMPLETED ON 27TH DAY OF JULY, 2026; THAT THE BOUNDARY LINES SHOWN ARE COMPILED FROM PREVIOUSLY RECORDED MAPS. WITNESS MY HAND AND SEAL THIS 4TH DAY OF AUGUST 2026.

8/4/26
MATTHEW D. SVEJKOVSKY N. PROFESSIONAL LAND SURVEYOR
LICENSE NO. L-5564

WATER & SEWER
RECORD DRAWING
OF

CALABASH POINTE PHASE 3

SHALLOTTE TOWNSHIP
BRUNSWICK COUNTY, NORTH CAROLINA

prepared for
LENNAR CAROLINAS, LLC

No.	Revision	By	Date

THOMAS & HUTTON
611 Burroughs & Chapin Blvd. • Suite 202
Myrtle Beach, SC 29577 • 843.839-3545
www.thomasandhutton.com

50 0 50 100
1 INCH = 50 FEET

plat	drawn	reviewed	field	crew
8/4/26	DLF	JC/DOB	7/26	HR

job 31725-PH3-WATER

LEGEND

- HOODED INLET
- STORM MANHOLE
- GRATE INLET
- WATER VALVE
- FIRE HYDRANT
- FITTING
- SEWER MANHOLE
- RIGHT OF WAY
- ADJACENT PROPERTY LINE
- BOUNDARY LINE

N.C. GRID
NAD 83(2011)

CALABASH POINTE
IS OWNED AND DEVELOPED BY:
LENNAR CAROLINAS, LLC.
ADDRESS: 1359 21ST AVE. N SUITE 105,
MYRTLE BEACH, SC 29577
PHONE: (843) 839-3963
DESIGN / INSPECTING ENGINEER:
THOMAS AND HUTTON ENGINEERING COMPANY.
ADDRESS: 611 BURROUGHS & CHAPIN BLVD. SUITE 202
MYRTLE BEACH, SC 29579
PHONE 843-839-3545
WATER & WASTE WATER SYSTEMS
HAVE BEEN INSTALLED BY:
R.H. MOORE
10601 HIGHWAY 707
MURRELLS INLET, SC 29576
PHONE: 843-650-2155

NOTES:
1) P.I.D.# 22500035.
2) DATE OF FIELD SURVEY: JULY, 2026.
3) THIS SURVEY IS VALID ONLY IF THE PRINT OF SAME HAS THE ORIGINAL SIGNATURE AND SEAL OF THE SURVEYOR.
4) ALL ELEVATIONS ARE BASED ON (NAVD 88).
5) ALL COORDINATES SHOWN ARE BASED ON THE NORTH CAROLINA STATE PLANE COORDINATE SYSTEM NAD1983(2011). DISTANCES SHOWN ARE HORIZONTAL DISTANCES NOT GRID DISTANCES.

MANHOLE SCHEDULE

MANHOLE	RIM ELEV	INVERT IN ELEV.	INVERT OUT ELEV
MH 15	35.91		29.97
MH 14	36.66	28.48	28.38
MH 13	33.61	27.85	

PIPE SCHEDULE

FROM MANHOLE	TO MANHOLE	LENGTH	SLOPE%	PIPE MATERIAL (PVC)	SIZE
MH 15	MH 14	348	0.43	DR 18	8"
MH 14	MH 13	136	0.39	DR 18	8"

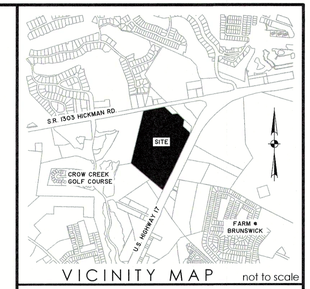

VICINITY MAP not to scale

This document and all reproducible copies of this document are the property of Thomas & Hutton. Reproduction of this document is not permitted without written consent of Thomas & Hutton unless this document becomes a matter of public record. ALTERATIONS TO THIS DOCUMENT ARE NOT PERMITTED.

NORTH CAROLINA PROFESSIONAL SEAL 036165 ENGINEER NATHAN T. POUND
NORTH CAROLINA THOMAS & HUTTON ENGINEERING CO. No. F-0871 CERTIFICATE OF AUTHORIZATION

THE FACILITIES HAVE BEEN CONSTRUCTED AS SHOWN ON THE "RECORD DRAWING" PLAN, AND THE FACILITIES MEET THE APPROVED WATER AND WASTEWATER PLAN AND SPECIFICATIONS OR ACHIEVE THE FUNCTION FOR WHICH THEY WERE DESIGNED.

NORTH CAROLINA PROFESSIONAL SEAL L-5564 LAND SURVEYOR MATTHEW D. SVEJKOVSKY
NORTH CAROLINA THOMAS & HUTTON ENGINEERING CO. No. F-0871 CERTIFICATE OF AUTHORIZATION

I, MATTHEW D. SVEJKOVSKY, CERTIFY THAT THIS WATER & WASTE WATER SYSTEM RECORD DRAWING IS DRAWN UNDER MY DIRECT SUPERVISION, AND BASED ON A FIELD SURVEY BY THOMAS AND HUTTON; THAT THE FIELDWORK WAS COMPLETED ON 27TH DAY OF JULY 2026; THAT THE BOUNDARY LINES SHOWN ARE COMPILED FROM PREVIOUSLY RECORDED MAPS. WITNESS MY HAND AND SEAL THIS 4TH DAY OF AUGUST 2026.

8/4/26
MATTHEW D. SVEJKOVSKY N.C. PROFESSIONAL LAND SURVEYOR
LICENSE NO. L-5564

WATER & SEWER
RECORD DRAWING
OF

CALABASH POINTE PHASE 3

SHALLOTTE TOWNSHIP
BRUNSWICK COUNTY, NORTH CAROLINA

prepared for
LENNAR CAROLINAS, LLC

No.	Revision	By	Date

THOMAS & HUTTON
611 Burroughs & Chapin Blvd. • Suite 202
Myrtle Beach, SC 29577 • 843.839-3545
www.thomasandhutton.com

50 0 50 100
1 INCH = 50 FEET

plat	drawn	reviewed	field	crew
8/4/26	DLF	JC/DOB	7/26	HR

job 31725-PH3-SEWER

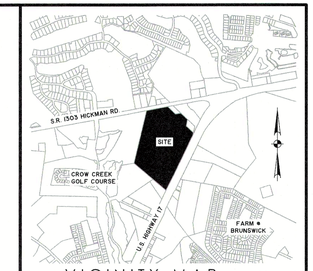

VICINITY MAP not to scale

This document and all reproducible copies of this document are the property of Thomas & Hutton. Reproduction of this document is not permitted without written consent of Thomas & Hutton unless this document becomes a matter of public record. ALTERATIONS TO THIS DOCUMENT ARE NOT PERMITTED.

NORTH CAROLINA
THOMAS & HUTTON ENGINEERING CO.
No. F-0871
CERTIFICATE OF AUTHORIZATION

NORTH CAROLINA
PROFESSIONAL
SEAL
43169
ENGINEER
NATHAN T. POUND
8/4/26

THE FACILITIES HAVE BEEN CONSTRUCTED AS SHOWN ON THE "RECORD DRAWING" PLAN, AND THE FACILITIES MEET THE APPROVED WATER AND WASTEWATER PLAN AND SPECIFICATIONS OR ACHIEVE THE FUNCTION FOR WHICH THEY WERE DESIGNED.

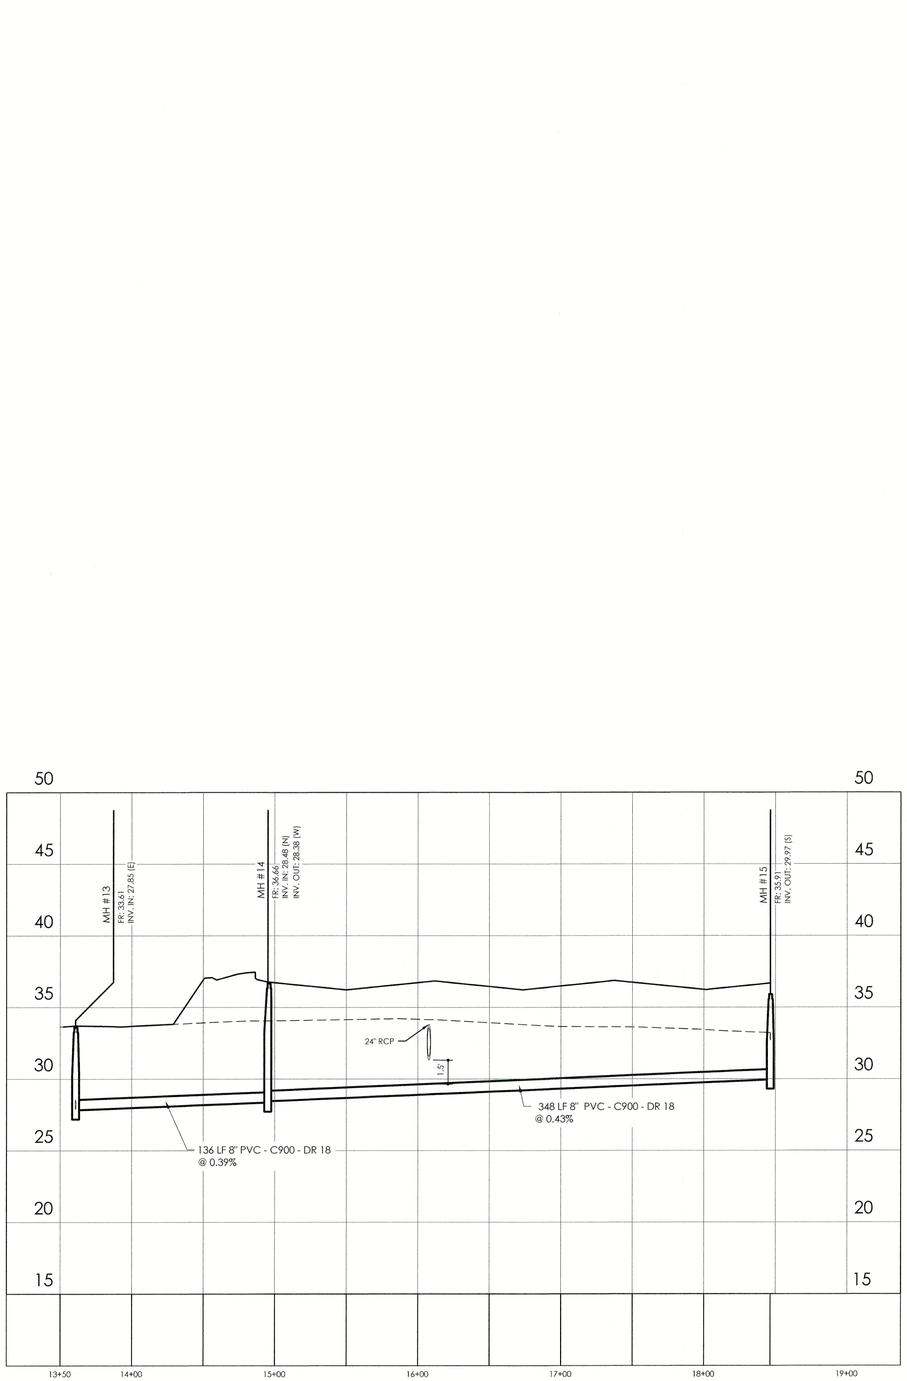

31725.0000 - Sewer - Run 3
STATIONS: 13+50 - 19+00
SCALE: HORZ.: 1" = 50'
VERT.: 1" = 5'

PROPOSED GRADE
EXISTING GRADE

NORTH CAROLINA
THOMAS & HUTTON ENGINEERING CO.
No. F-0871
CERTIFICATE OF AUTHORIZATION

NORTH CAROLINA
PROFESSIONAL
SEAL
L-5564
LAND SURVEYOR
MATTHEW D. SVEJKOVSKY

I, MATTHEW D. SVEJKOVSKY, CERTIFY THAT THIS WATER & WASTE WATER SYSTEM RECORD DRAWING IS DRAWN UNDER MY DIRECT SUPERVISION, AND BASED ON A FIELD SURVEY BY THOMAS AND HUTTON; THAT THE FIELDWORK WAS COMPLETED ON 27TH DAY OF JULY 2026; THAT THE BOUNDARY LINES SHOWN ARE COMPILED FROM PREVIOUSLY RECORDED MAPS. WITNESS MY HAND AND SEAL THIS 4TH DAY OF AUGUST 2026.

8/4/26

MATTHEW D. SVEJKOVSKY N.C. PROFESSIONAL LAND SURVEYOR
LICENSE NO. L-5564

WATER & SEWER
RECORD DRAWING
OF

CALABASH POINTE PHASE 3

SHALOTTE TOWNSHIP
BRUNSWICK COUNTY, NORTH CAROLINA

prepared for
LENNAR CAROLINAS, LLC

No.	Revision	By	Date

THOMAS & HUTTON
611 Burroughs & Chapin Blvd. • Suite 202
Myrtle Beach, SC 29577 • 843.839-3545
www.thomasandhutton.com

50 0 50 100
1 INCH = 50 FEET

plat	drawn	reviewed	field	crew
8/4/26	DLF	JC/DOB	7/26	HR

job 31725-PH3-WATER

J:\31725\31725.0000\Survey\Dwg\SRC (SRA##)\SDU\31725.0000 PH3 Sewer Plan.dwg, Aug 17, 2026 - 12:56:47 PM