RECEIVED

By William L. Pinnix, P.E. at 9:07 am, Aug 19, 2016

Calabash Lakes
Asbuilt from Randy Ward, PLS
August 19, 2016

Brunswick County Engineering Department

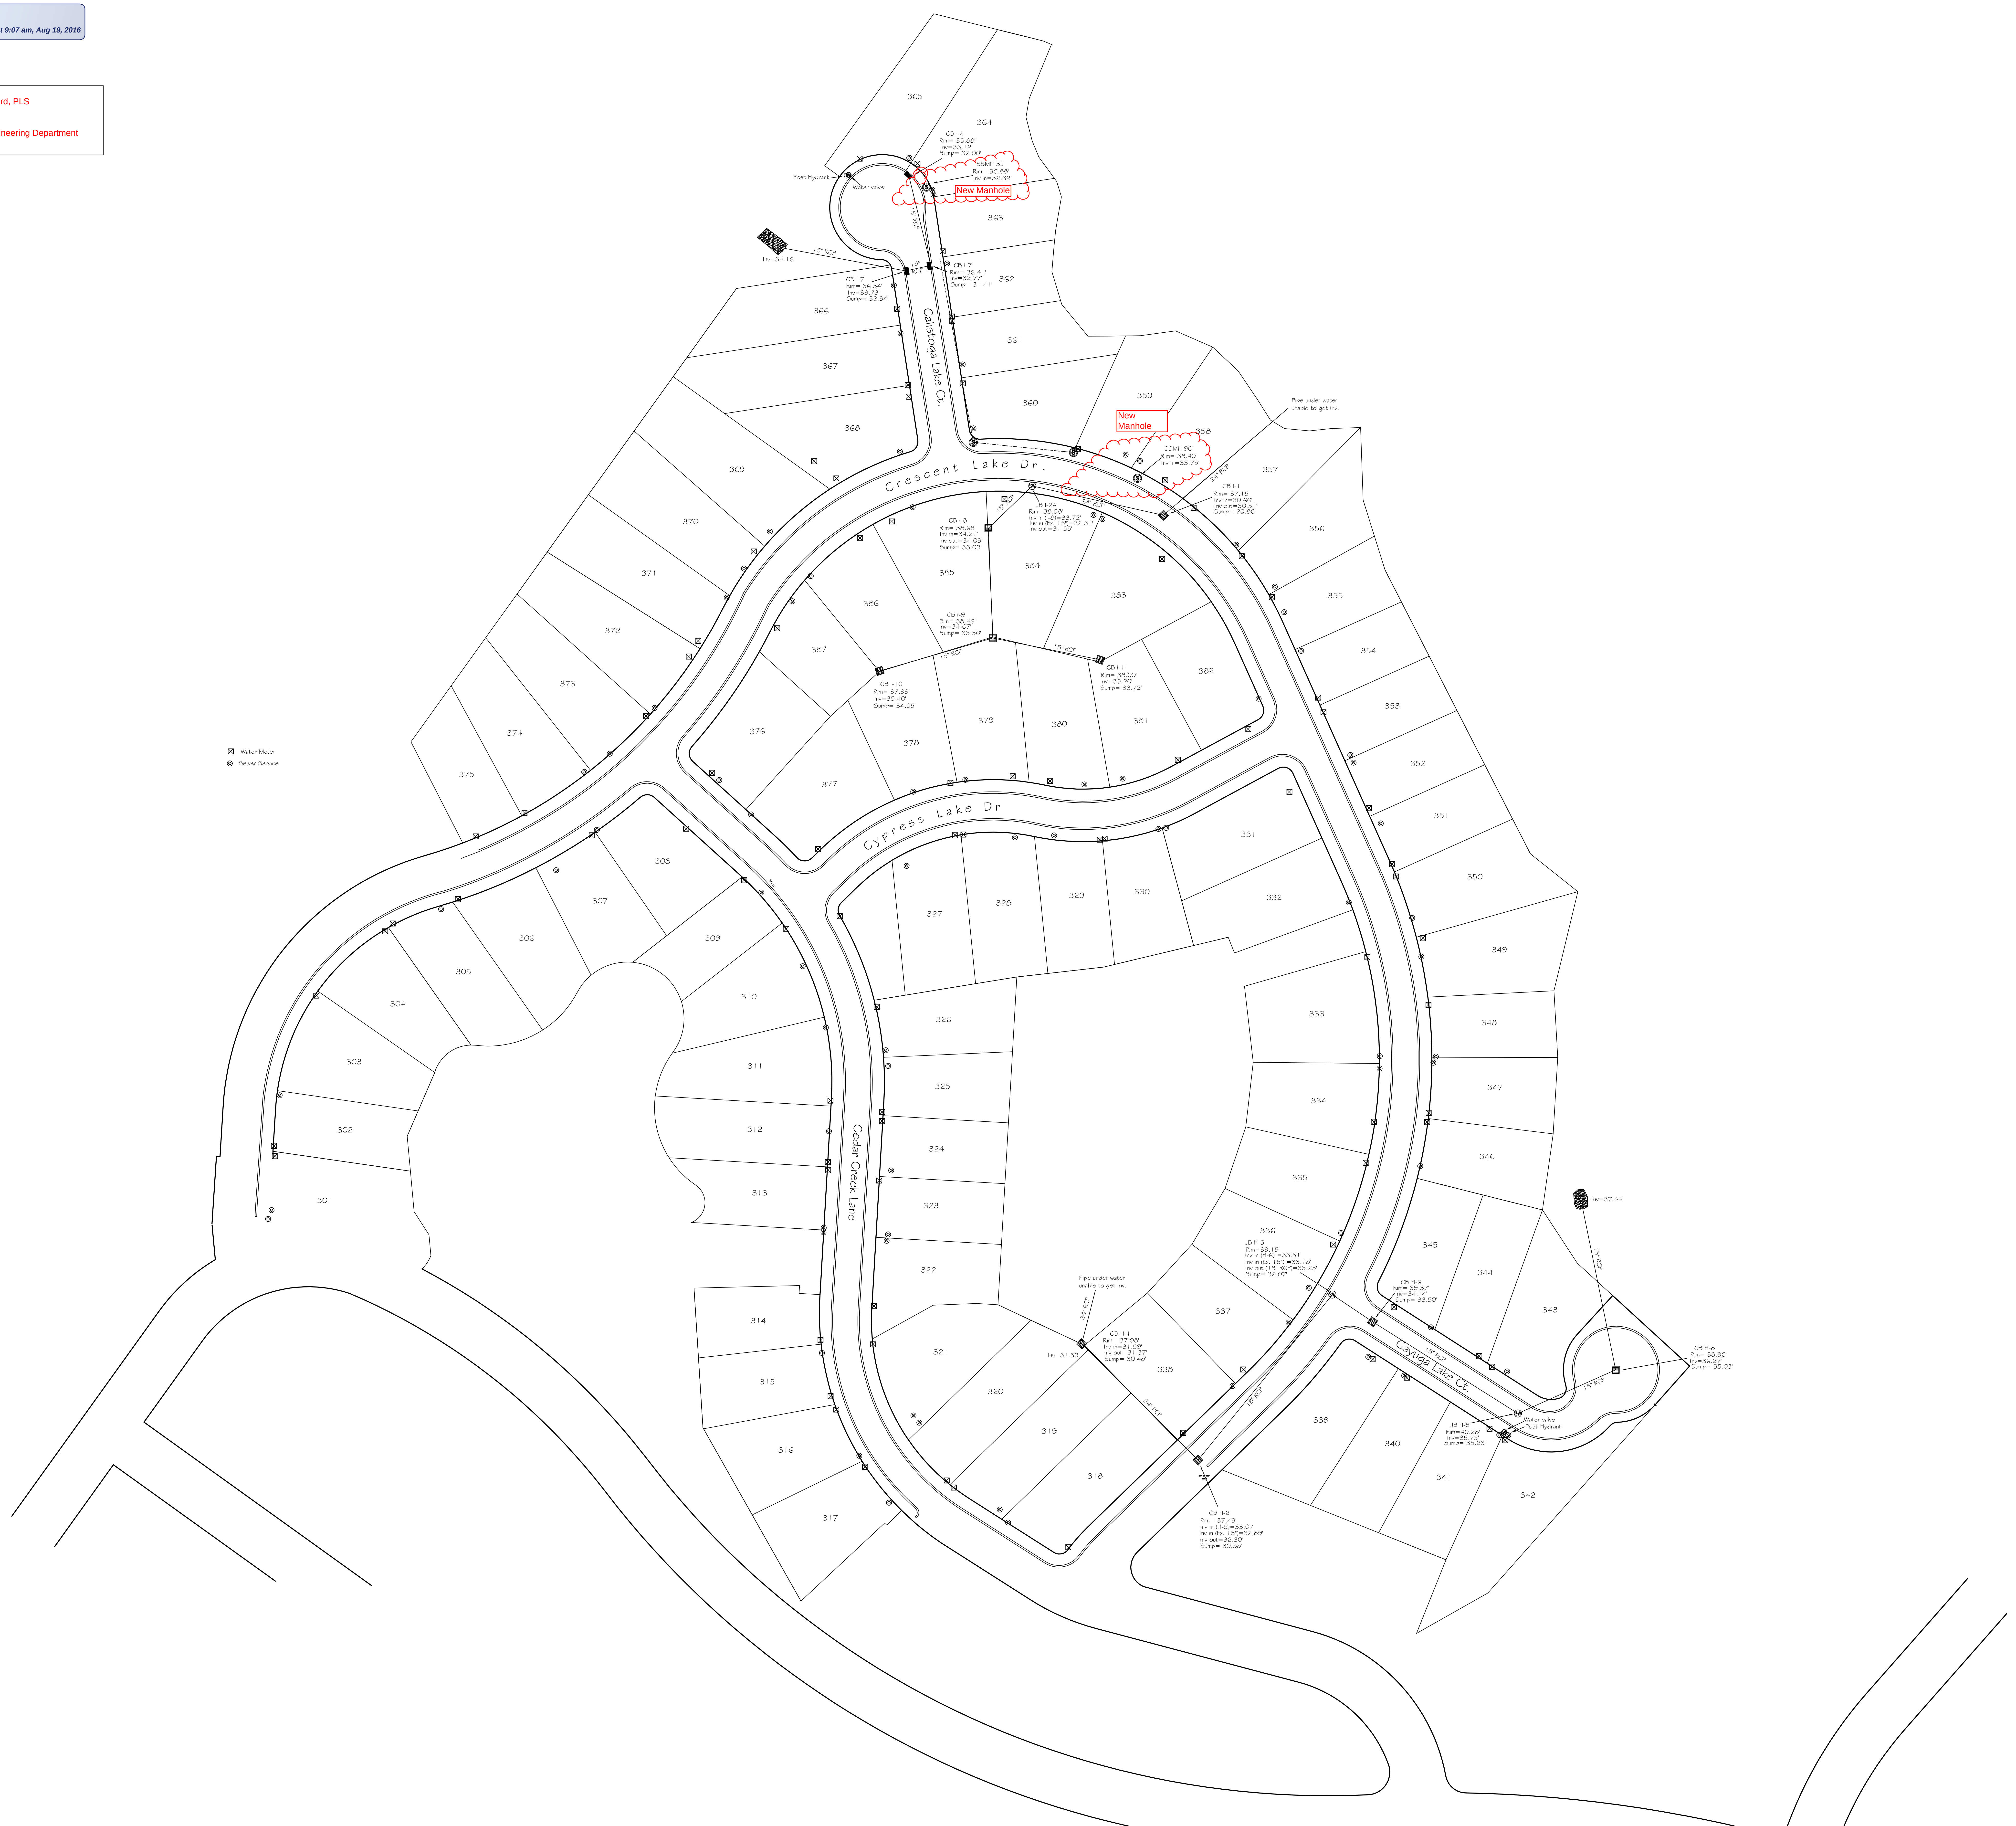
365
364
Post Hydrant
Water valve
CB I-4
Rim= 35.88'
Inv=33.12'
Sump= 32.00'
SSMH 3E
Rim= 36.88'
Inv in=32.32'
New Manhole
363
15" RCP
Inv=34.16'
15" RCP
CB I-7
Rim= 36.34'
Inv=33.73'
Sump= 32.34'
15" RCP
CB I-7
Rim= 36.41'
Inv=32.77'
Sump= 31.41'
362
366
Calistoga Lake Ct.
361
367
360
368
359
New Manhole
358
SSMH 9C
Rim= 38.40'
Inv in=33.75'
Pipe under water unable to get Inv.
24" RCP
357
CB I-1
Rim= 37.15'
Inv in=30.60'
Inv out=30.51'
Sump= 29.86'
Crescent Lake Dr.
24" RCP
15" RCP
JB I-2A
Rim=38.98'
Inv in (I-8)=33.72'
Inv in (Ex. 15")=32.31'
Inv out=31.55'
CB I-8
Rim= 38.69'
Inv in=34.21'
Inv out=34.03'
Sump= 33.09'
369
370
385
384
383
356
355
371
372
386
CB I-9
Rim= 38.46'
Inv=34.67'
Sump= 33.50'
15" RCP
15" RCP
CB I-11
Rim= 38.00'
Inv=35.20'
Sump= 33.72'
354
387
CB I-10
Rim= 37.99'
Inv=35.40'
Sump= 34.05'
382
373
353
379
380
381
374
376
378
352
375
Water Meter
Sewer Service
377
Cypress Lake Dr
351
308
331
307
350
306
309
327
328
329
330
332
305
304
349
310
326
333
303
311
348
325
347
334
302
312
324
Cedar Creek Lane
346
301
313
323
335
Inv=37.44'
15" RCP
336
JB H-5
Rim=39.15'
Inv in (H-6) =33.51'
Inv in (Ex. 15") =33.18'
Inv out (18" RCP)=33.25'
Sump= 32.07'
345
344
322
CB H-6
Rim= 39.37'
Inv=34.14'
Sump= 33.50'
Pipe under water unable to get Inv.
343
337
314
24" RCP
CB H-1
Rim= 37.98'
Inv in=31.59'
Inv out=31.37'
Sump= 30.48'
Inv=31.59'
Cayuga Lake Ct.
15" RCP
CB H-8
Rim= 38.96'
Inv=36.27'
Sump= 35.03'
321
338
15" RCP
315
320
18" RCP
24" RCP
339
Water valve
Post Hydrant
JB H-9
Rim=40.28'
Inv=35.75'
Sump= 35.23'
340
319
316
341
342
318
INV 15" RCP
33.07'
CB H-2
Rim= 37.43'
Inv in (H-5)=33.07'
Inv in (Ex. 15")=32.89'
Inv out=32.30'
Sump= 30.88'
317