RECEIVED
By William L. Pinnix, P.E. at 9:07 am, Aug 19, 2016

Calabash Lakes
Asbuilt from Randy Ward, PLS
August 19, 2016

Brunswick County Engineering Department

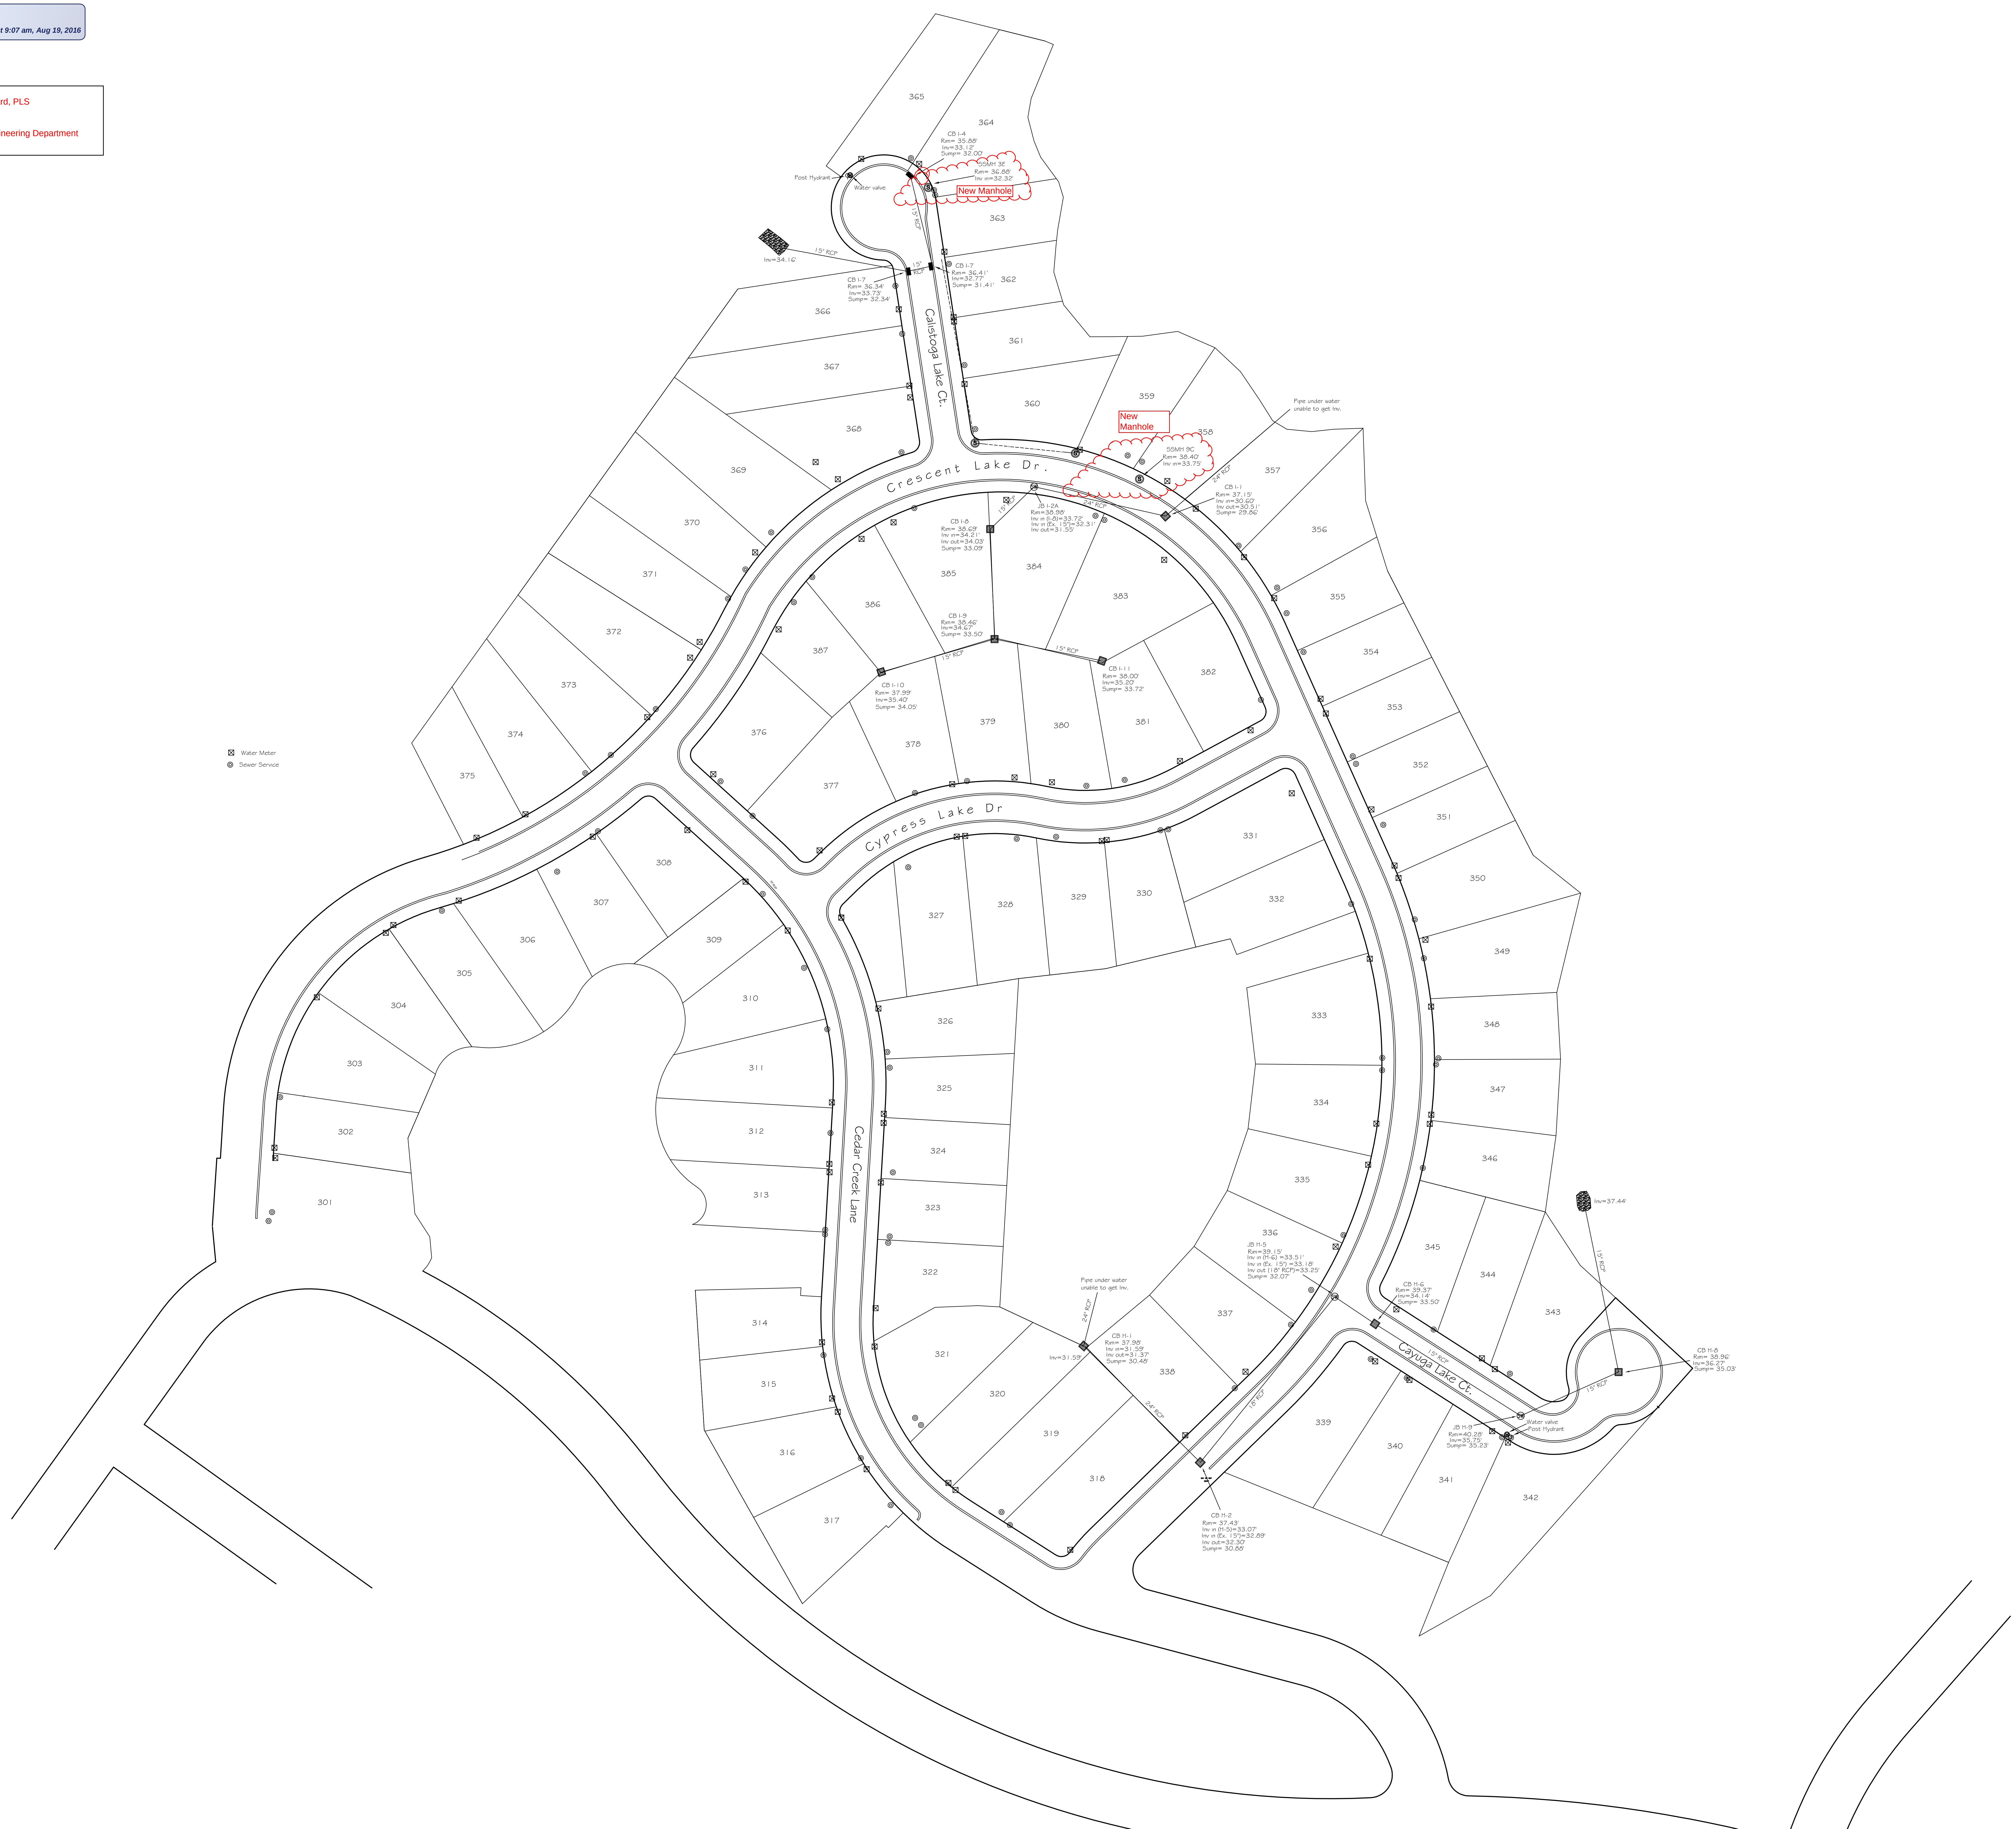

⊠ Water Meter
◎ Sewer Service
Crescent Lake Dr.
Calistoga Lake Ct.
Cypress Lake Dr
Cedar Creek Lane
Cayuga Lake Ct.
Post Hydrant
Water valve
CB I-4
Rim= 35.88'
Inv=33.12'
Sump= 32.00'
SSMH 3E
Rim= 36.88'
Inv in=32.32'
New Manhole
15" RCP
Inv=34.16'
CB I-7
Rim= 36.34'
Inv=33.73'
Sump= 32.34'
CB I-7
Rim= 36.41'
Inv=32.77'
Sump= 31.41'
New Manhole
SSMH 9C
Rim= 38.40'
Inv in=33.75'
Pipe under water unable to get Inv.
24" RCP
CB I-1
Rim= 37.15'
Inv in=30.60'
Inv out=30.51'
Sump= 29.86'
JB I-2A
Rim=38.98'
Inv in (I-8)=33.72'
Inv in (Ex. 15")=32.31'
Inv out=31.55'
CB I-8
Rim= 38.69'
Inv in=34.21'
Inv out=34.03'
Sump= 33.09'
CB I-9
Rim= 38.46'
Inv=34.67'
Sump= 33.50'
CB I-10
Rim= 37.99'
Inv=35.40'
Sump= 34.05'
CB I-11
Rim= 38.00'
Inv=35.20'
Sump= 33.72'
JB H-5
Rim=39.15'
Inv in (H-6) =33.51'
Inv in (Ex. 15") =33.18'
Inv out (18" RCP)=33.25'
Sump= 32.07'
Pipe under water unable to get Inv.
CB H-1
Rim= 37.98'
Inv in=31.59'
Inv out=31.37'
Sump= 30.48'
Inv=31.59'
18" RCP
CB H-2
Rim= 37.43'
Inv in (H-5)=33.07'
Inv in (Ex. 15")=32.89'
Inv out=32.30'
Sump= 30.88'
CB H-6
Rim= 39.37'
Inv=34.14'
Sump= 33.50'
Inv=37.44'
CB H-8
Rim= 38.96'
Inv=36.27'
Sump= 35.03'
JB H-9
Rim=40.28'
Inv=35.75'
Sump= 35.23'
Water valve
Post Hydrant
301 302 303 