


— INSTALLED LOCATION OF SEWER LINE

U.S. HIGHWAY 17

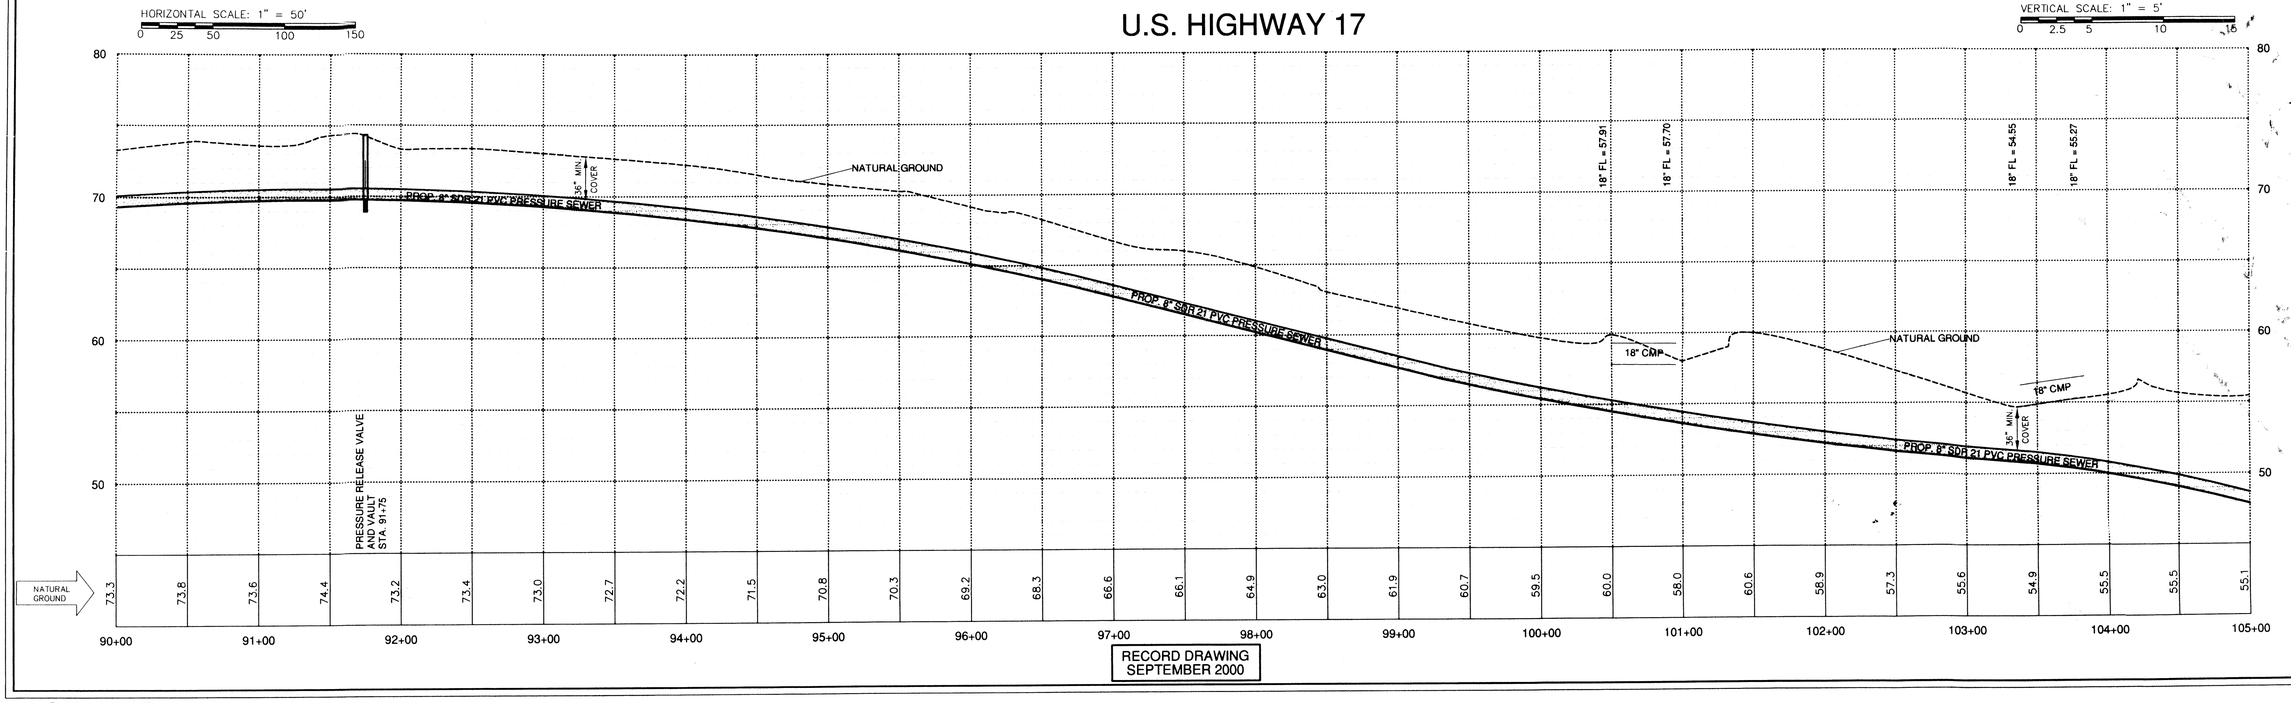

RECORD DRAWING
SEPTEMBER 2000

EAST COAST ENGINEERING COMPANY, P.A.
Shallotte, North Carolina 28459
4918 Main Street – P.O. Box 2469
910.754.8029

SANITARY SEWER EXTENSION: U.S. 17 NORTH

FOR

TOWN OF SHALLOTTE

BRUNSWICK COUNTY, NORTH CAROLINA

Date: 1 MAR 99
Scale: 1"=50'
Drawn By: DBB
Checked By: DBB

NORTH CAROLINA PROFESSIONAL SEAL 16729 ENGINEER DAVID BARTON BOWMAN

Sheet 8 of 21

ECEC PROJECT NO. 98-0183

This drawing shall not be reproduced in whole or in part without written permission of East Coast Engineering Company, P.A.