

JONES FORD

OCEAN CITY CHEVROLET

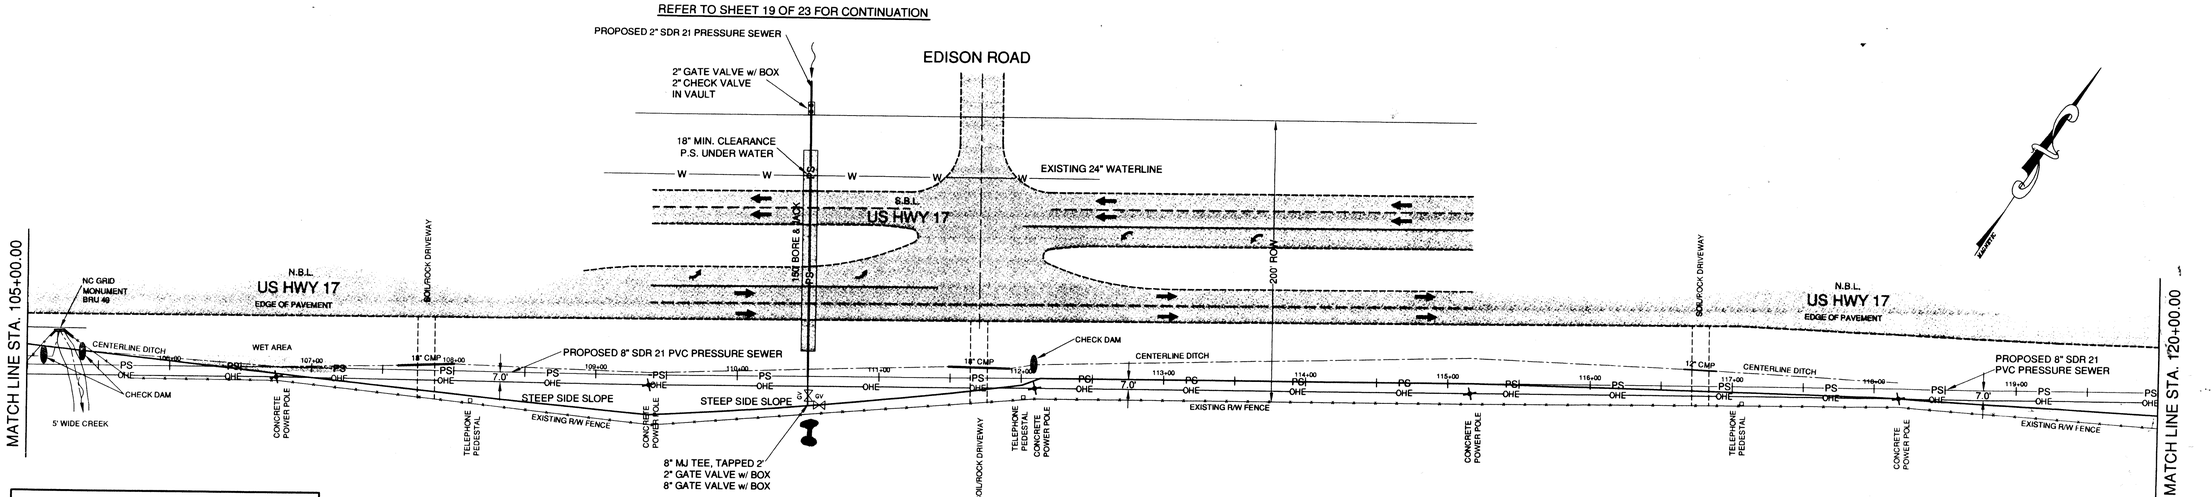


— INSTALLED LOCATION OF SEWER LINE

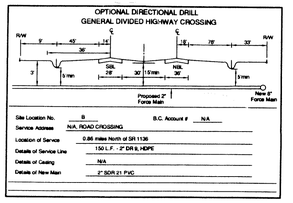

U.S. HIGHWAY 17

HORIZONTAL SCALE: 1" = 50'

VERTICAL SCALE: 1" = 5'

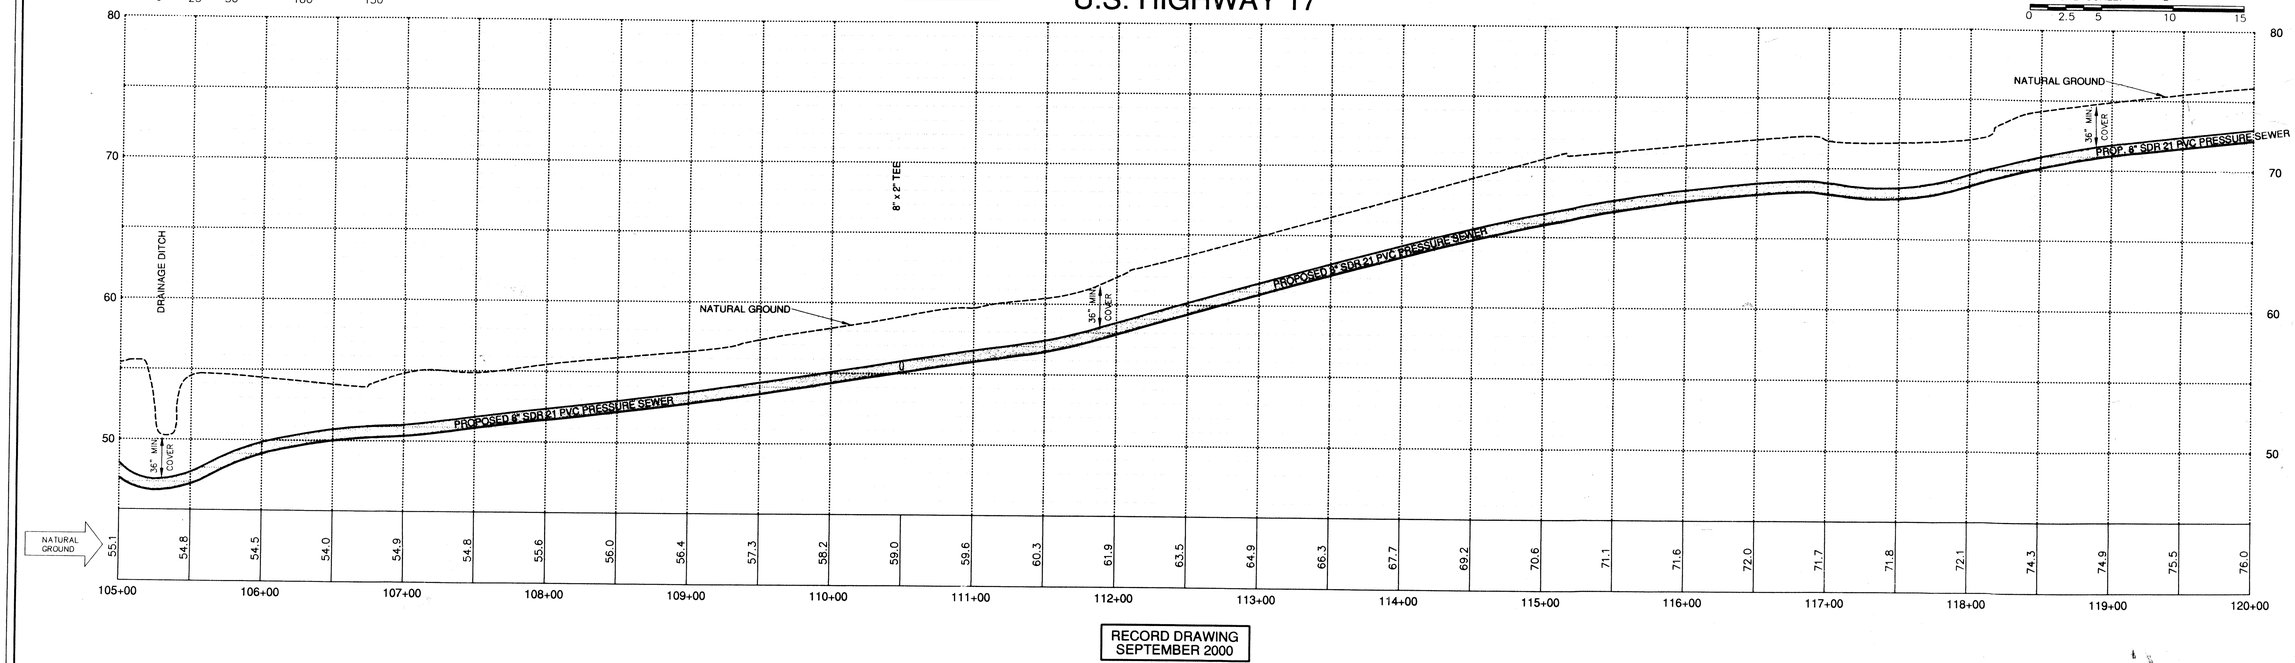

RECORD DRAWING
SEPTEMBER 2000

EAST COAST ENGINEERING COMPANY, P.A.
Shallotte, North Carolina 28459
4918 Main Street - P.O. Box 2409
910.754.8029

SANITARY SEWER EXTENSION: U.S. 17 NORTH
FOR
TOWN OF SHALLOTTE
BRUNSWICK COUNTY, NORTH CAROLINA

Date: 1 MAR 99
Scale: 1"=50'
Drawn By: DBB
Checked By: DBB

NORTH CAROLINA PROFESSIONAL ENGINEER SEAL 16729 DANIEL BARTON BOWMAN

Sheet 9 of 21

ECEC PROJECT NO. 98-0183

This drawing shall not be reproduced in whole or in part without written permission of East Coast Engineering Company, P.A.