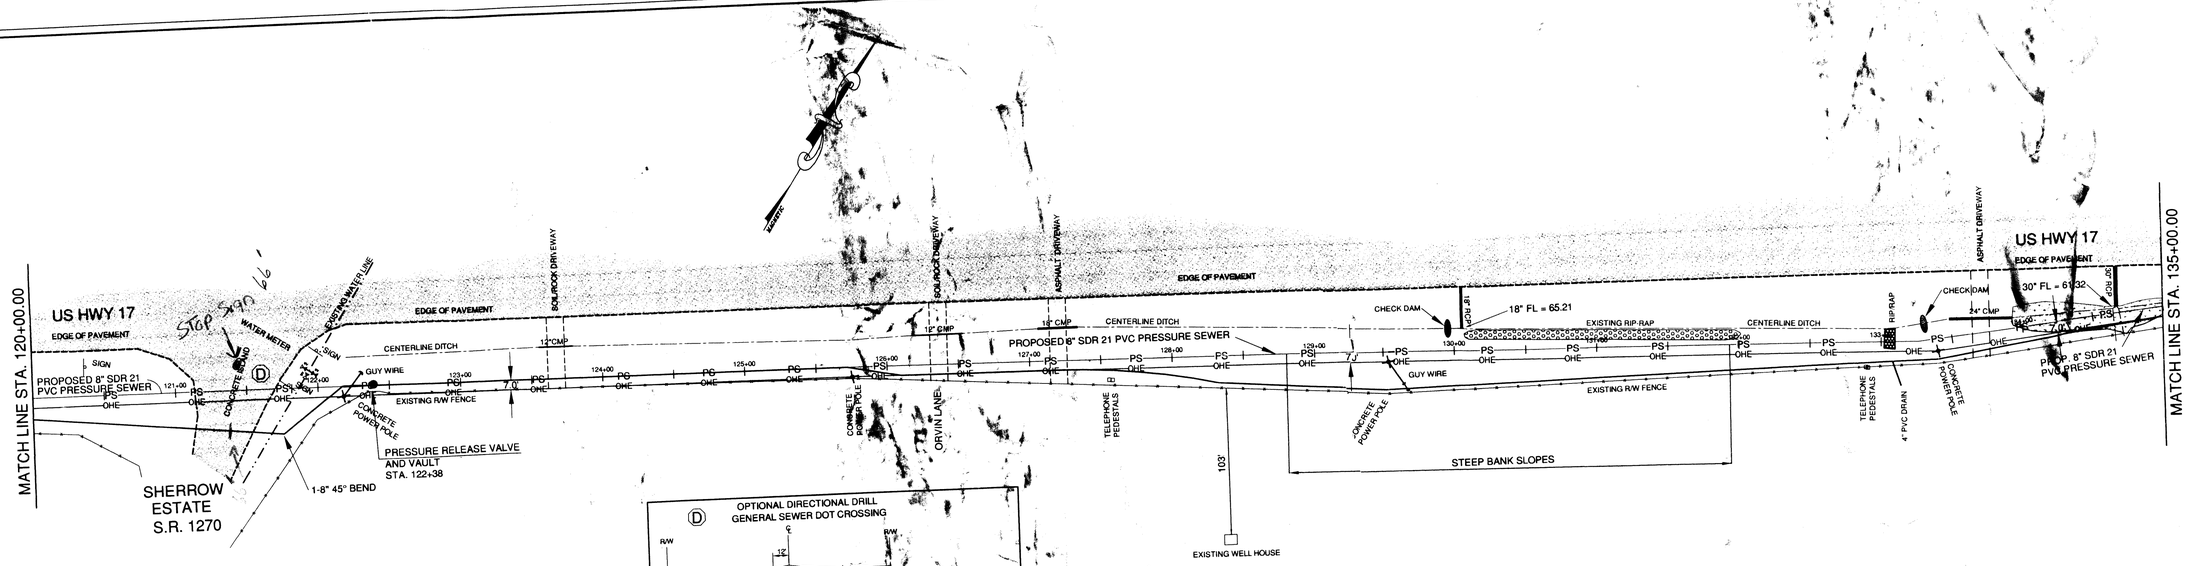


Ⓓ 80 L.F. 16" STEEL CASING W/ BORE AND JACK

INSTALLED LOCATION OF SEWER LINE


Ⓓ OPTIONAL DIRECTIONAL DRILL
GENERAL SEWER DOT CROSSING

Site Location No.	D
B.C. Account #	N/A
Service Address	N/A ROAD CROSSING AT SR 1210
Location of Service	INTERSECTION SR 1210 & U.S. 17
Details of Service Line	80 L.F. - 8" DR 9, HDPE
Details of Casing	N/A
Details of New Main	8" SDR 21 PVC

VERTICAL SCALE: 1" = 5'
0 2.5 5 10 15

U.S. HIGHWAY 17

HORIZONTAL SCALE: 1" = 50'
0 25 50 100 150

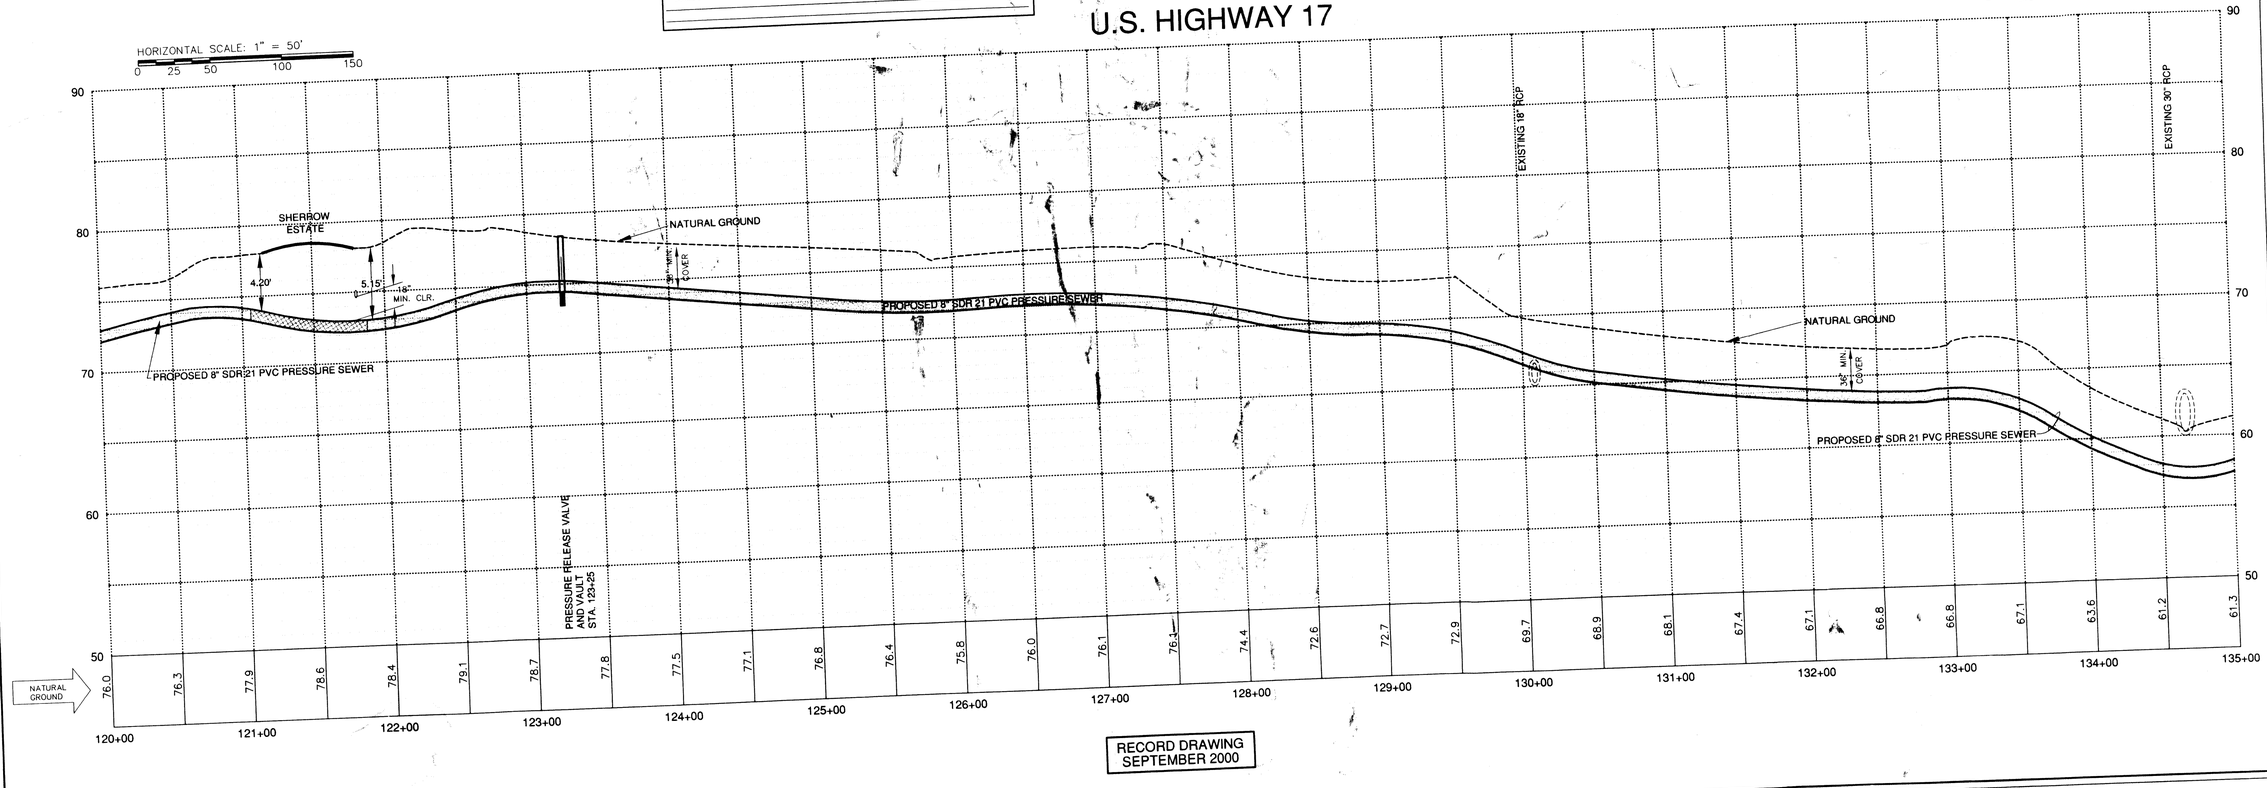

RECORD DRAWING
SEPTEMBER 2000

Revisions

EAST COAST ENGINEERING COMPANY, P.A.
Shallotte, North Carolina 28459
4918 Main Street - P.O. Box 2469
910.754.8029

SANITARY SEWER EXTENSION: U.S. 17 NORTH
FOR
TOWN OF SHALLOTTE
BRUNSWICK COUNTY, NORTH CAROLINA

Date: 1 MAR 99
Scale: 1"-50'
Drawn By: DBB
Checked By: DBB

NORTH CAROLINA PROFESSIONAL SEAL 16729 ENGINEER DAVID BARTON BOWMAN

Sheet 10 of 21

ECEC PROJECT NO. 98-0183

This drawing shall not be reproduced in whole or in part without written permission of East Coast Engineering Company, P.A.