
COPYRIGHT © 2011 W.K. DICKSON & CO., INC., ALL RIGHTS RESERVED. REPRODUCTION OR USE OF THE CONTENTS OF THIS DOCUMENT IN ANY FORM WITHOUT THE EXPRESS WRITTEN CONSENT OF W.K. DICKSON & CO., INC. IS PROHIBITED. ONLY COPIES FROM THE ORIGINAL OF THIS DOCUMENT, MARKED WITH AN ORIGINAL SIGNATURE AND SEAL SHALL BE CONSIDERED TO BE VALID THIS COPIES.

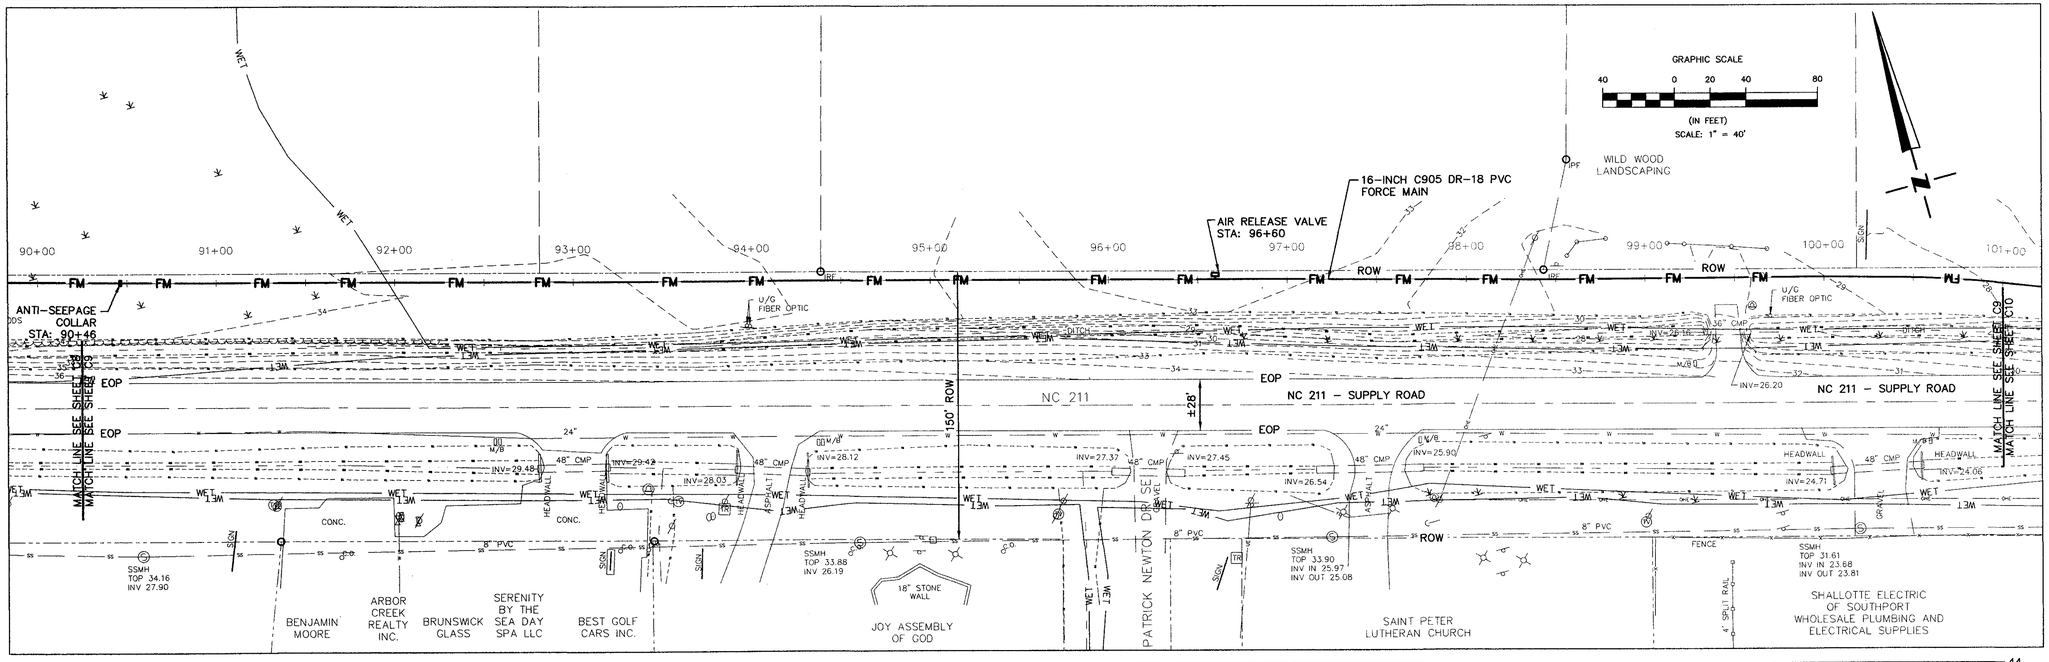

RECORD DRAWING

REV. NO.	DESCRIPTION	DATE
	REVISIONS	

PROJECT MANAGER: TCH	DRAWING SCALE: 1" = 40'
DRAWN BY: VAR	PROJECT DATE: FEB. 2007
APPROVED BY: TCH	PROJECT NUMBER: 60120.00.WL
FILE NAME:	PLOT DATE: 1/20/2011

W.K. DICKSON community infrastructure consultants

909 MARKET STREET
WILMINGTON, NC 28401
(910) 762-4200

Office Locations: North Carolina, South Carolina, Georgia
NC LICENSE NO. F-0374

RELEASED FOR	DATE
APPROVALS	
BIDDING	
CONSTRUCTION	
RECORD DWG.	

NORTH CAROLINA PROFESSIONAL SEAL 024984 ENGINEER T. CARTER HUBARD 1/20/11

CITY OF SOUTHPORT
TRANSMISSION FACILITIES

HWY 211 FORCE MAIN
STA: 90+25 TO STA: 101+00

C9

L:\Projects\SOPOR\60120000WL\CADD\LAND_60120_TRANSMISSION ROUTE\dwg\as-built drawings 12-21-2010\60120_C1-C18.dwg