

COPYRIGHT © W.K. DICKSON & CO., INC., ALL RIGHTS RESERVED. REPRODUCTION OR USE OF THE CONTENTS OF THIS DOCUMENT, IN WHOLE OR IN PART, WITHOUT THE EXPRESS WRITTEN CONSENT OF W.K. DICKSON & CO., INC., IS PROHIBITED. ONLY COPIES FROM THE ORIGINAL OF THIS DOCUMENT, MARKED WITH AN ORIGINAL SIGNATURE AND SEAL, SHALL BE CONSIDERED TO BE AUTHORIZED COPIES.

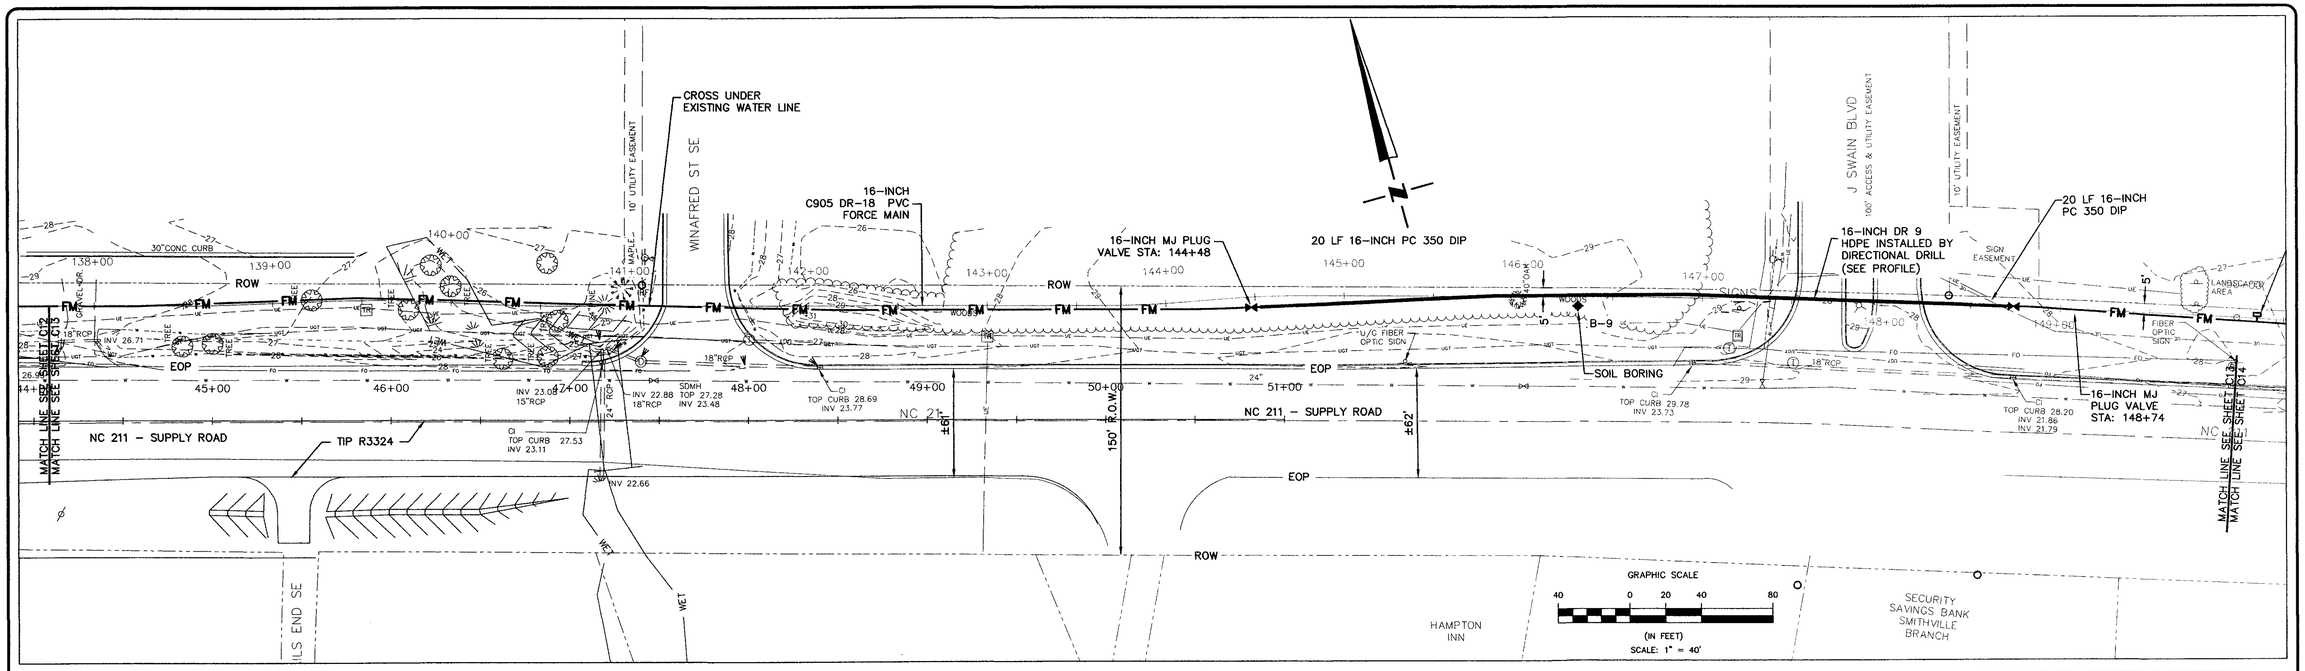

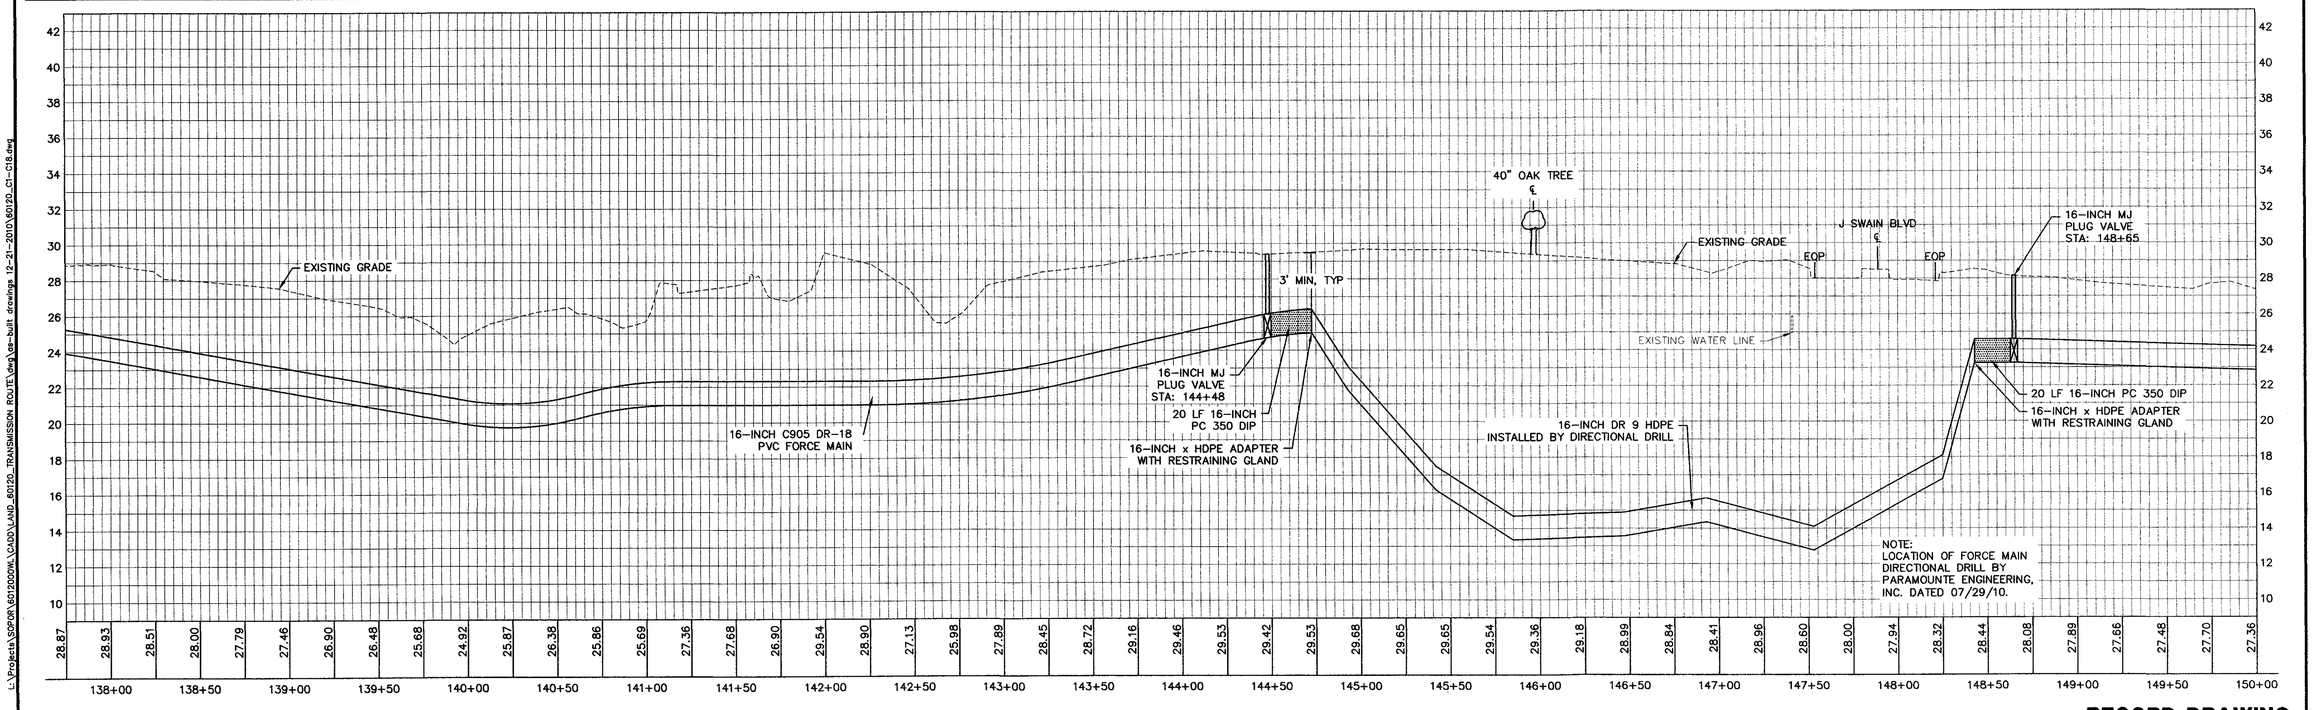

RECORD DRAWING

L:\Projects\SOPOR\60120000WL\CADD\LAND_60120_TRANSMISSION ROUTE\dwg\as-built drawings 12-21-2010\60120_C1-C18.dwg

REV. NO.	DESCRIPTION	DATE
	REVISIONS	

PROJECT MANAGER	TCH
DRAWN BY	VAR
APPROVED BY	TCH
FILE NAME	
DRAWING SCALE	1" = 40'
PROJECT DATE	FEB. 2007
PROJECT NUMBER	60120.00.WL
PLOT DATE	1/20/2011

WK DICKSON
community infrastructure consultants
909 MARKET STREET
WILMINGTON, NC 28401
(910) 762-4200
Office Locations: North Carolina
South Carolina
Georgia
NC LICENSE NO. F-0374

RELEASED FOR	DATE
APPROVALS	
BIDDING	
CONSTRUCTION	
RECORD DWG.	

NORTH CAROLINA PROFESSIONAL SEAL 024984 ENGINEER T. CARTER HUBBARD 1/20/11

CITY OF SOUTHPORT
TRANSMISSION FACILITIES

HWY 211 FORCE MAIN
STA: 137+75 TO STA: 150+00

C13