COPYRIGHT ©, W.K. DICKSON & CO., INC. ALL RIGHTS RESERVED. REPRODUCTION OR USE OF THE CONTENTS OF THIS DOCUMENT; ADDITIONS OR DELETIONS TO THIS DOCUMENT, IN WHOLE OR IN PART, WITHOUT WRITTEN CONSENT OF W.K. DICKSON & CO., INC., IS PROHIBITED. ONLY COPIES FROM THE ORIGINAL OF THIS DOCUMENT, MARKED WITH AN ORIGINAL SIGNATURE AND SEAL SHALL BE CONSIDERED TO BE VALID, TRUE COPIES.

L:\Projects\SOPOR\60120000WL\CADD\LAND_60120_TRANSMISSION ROUTE\dwg\as-built drawings 12-21-2010\60120_C1-C18.dwg

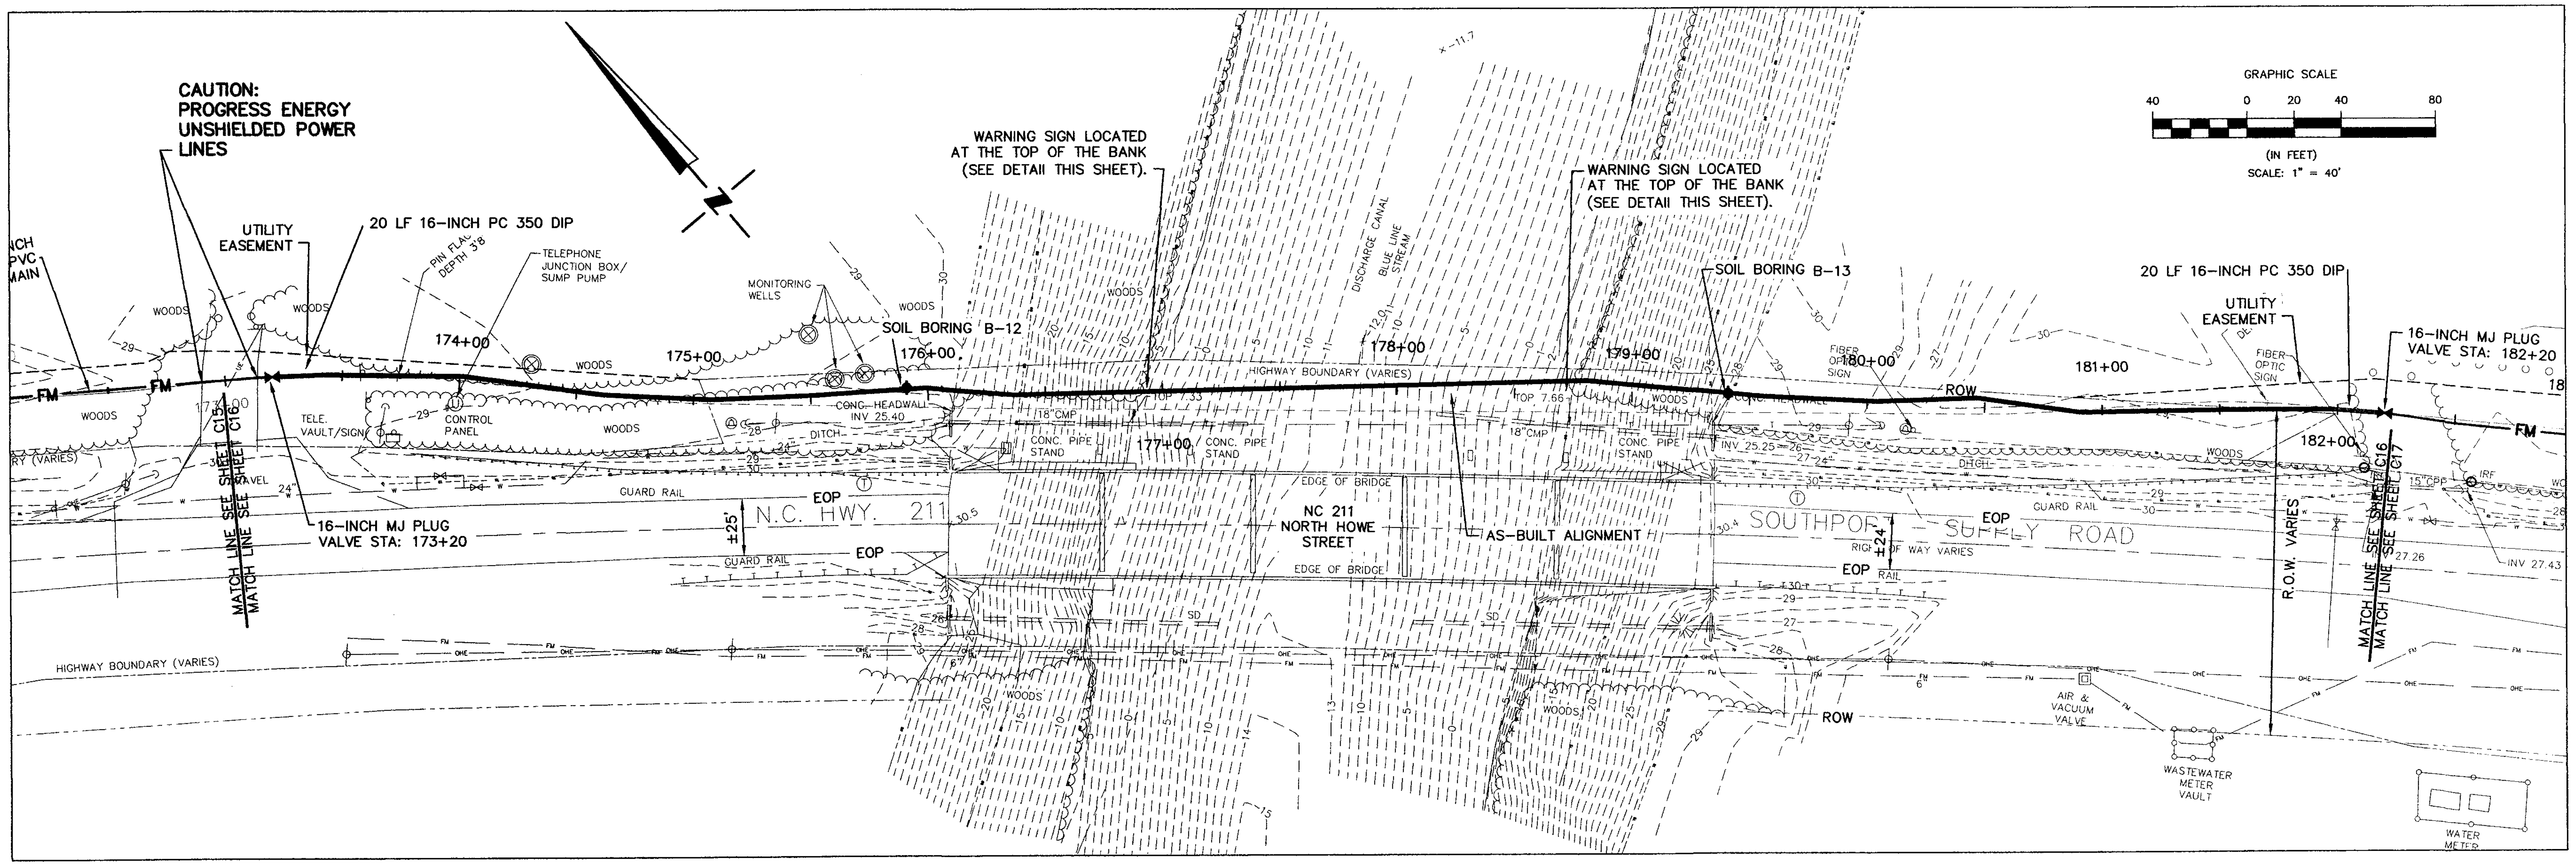
CAUTION:
PROGRESS ENERGY
UNSHIELDED POWER
LINES
N
UTILITY EASEMENT
20 LF 16-INCH PC 350 DIP
PIN FLAG DEPTH 3'8
TELEPHONE JUNCTION BOX/ SUMP PUMP
MONITORING WELLS
SOIL BORING B-12
WARNING SIGN LOCATED AT THE TOP OF THE BANK (SEE DETAIl THIS SHEET).
DISCHARGE CANAL
BLUE LINE STREAM
WARNING SIGN LOCATED AT THE TOP OF THE BANK (SEE DETAIl THIS SHEET).
SOIL BORING B-13
GRAPHIC SCALE
40 0 20 40 80
(IN FEET)
SCALE: 1" = 40'
20 LF 16-INCH PC 350 DIP
UTILITY EASEMENT
16-INCH MJ PLUG VALVE STA: 182+20
FIBER OPTIC SIGN
WOODS
FM
174+00
175+00
176+00
177+00
178+00
179+00
180+00
181+00
182+00
TELE. VAULT/SIGN
CONTROL PANEL
CONC. HEADWALL INV 25.40
DITCH
18" CMP
CONC. PIPE STAND
HIGHWAY BOUNDARY (VARIES)
TOP 7.66
INV 25.25
ROW
MATCH LINE SEE SHEET C15
MATCH LINE SEE SHEET C16
16-INCH MJ PLUG VALVE STA: 173+20
GUARD RAIL
N.C. HWY. 211
±25'
EOP
NC 211 NORTH HOWE STREET
EDGE OF BRIDGE
AS-BUILT ALIGNMENT
SOUTHPORT SUPPLY ROAD
RIGHT OF WAY VARIES
±24'
R.O.W. VARIES
MATCH LINE SEE SHEET C16
MATCH LINE SEE SHEET C17
INV 27.43
HIGHWAY BOUNDARY (VARIES)
SD
AIR & VACUUM VALVE
WASTEWATER METER VAULT
WATER METER

DISCHARGE CANAL PLAN VIEW

STA: 172+50 TO STA: 182+50

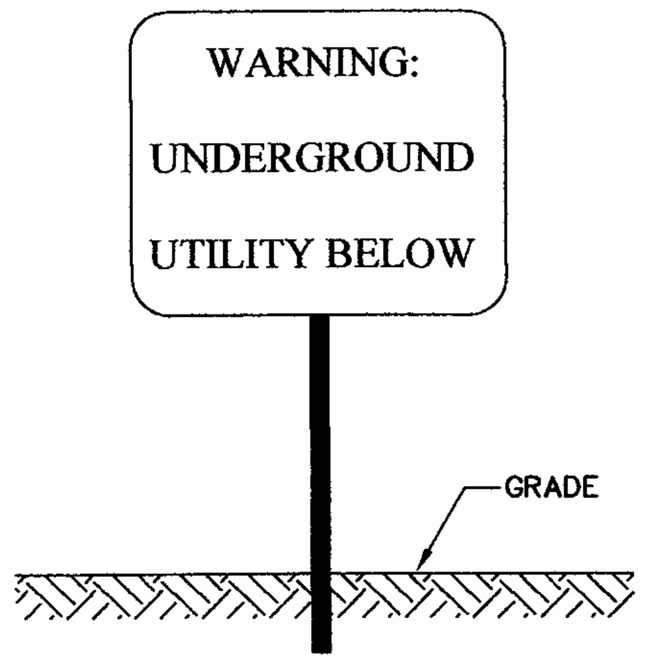
WARNING:
UNDERGROUND
UTILITY BELOW
GRADE

NOTES:

1. LETTER SHALL BE AS INDICATED.
2. LETTER SHALL BE VISIBLE FROM A DISTANCE OF 200'.
3. SIGNS SHALL BE PLACED AND ORIENTED TO BE VISIBLE FROM THE CANAL.
4. SIGNS SHALL BE DESIGNED AND ADEQUATELY BURIED AND SUPPORTED FOR WINDSPEEDS OF 150 MPH.
5. MATERIAL USED TO CONSTRUCT SIGN, INCLUDING LETTERING, SHALL HAVE A MINIMUM LIFE-SPAN OF 30 YEARS.

WARNING SIGN DETAIL
NOT TO SCALE

GRAPHIC SCALE
40 0 20 40 80
(IN FEET)
SCALE: 1" = 40'

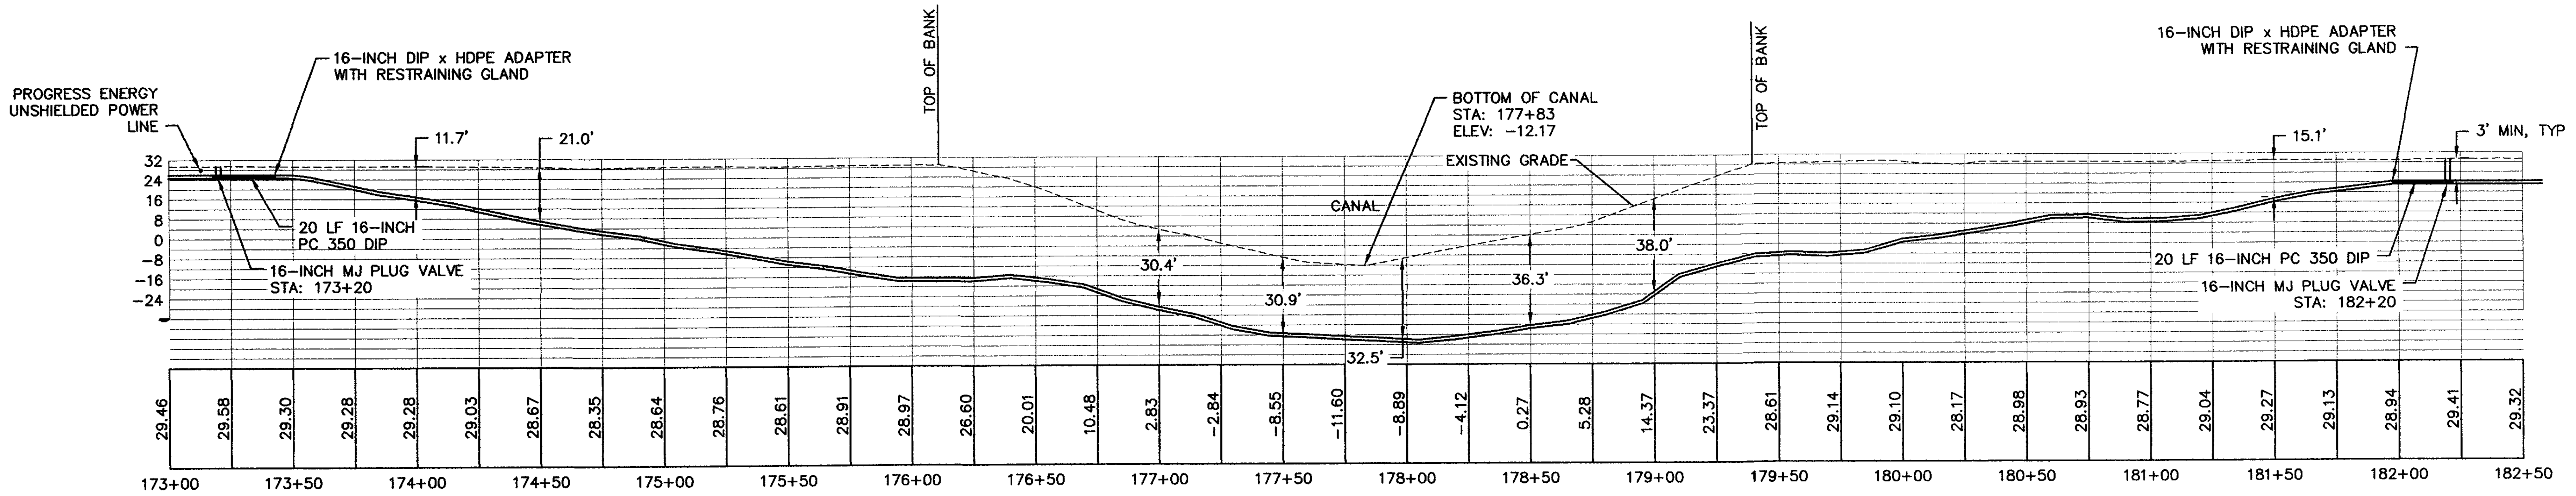
PROGRESS ENERGY UNSHIELDED POWER LINE
16-INCH DIP x HDPE ADAPTER WITH RESTRAINING GLAND
11.7'
21.0'
TOP OF BANK
BOTTOM OF CANAL STA: 177+83 ELEV: -12.17
EXISTING GRADE
CANAL
TOP OF BANK
15.1'
16-INCH DIP x HDPE ADAPTER WITH RESTRAINING GLAND
3' MIN, TYP
32
24
16
8
0
-8
-16
-24
20 LF 16-INCH PC 350 DIP
16-INCH MJ PLUG VALVE STA: 173+20
30.4'
30.9'
32.5'
36.3'
38.0'
20 LF 16-INCH PC 350 DIP
16-INCH MJ PLUG VALVE STA: 182+20
29.46
29.58
29.30
29.28
29.28
29.03
28.67
28.35
28.64
28.76
28.61
28.91
28.97
26.60
20.01
10.48
2.83
-2.84
-8.55
-11.60
-8.89
-4.12
0.27
5.28
14.37
23.37
28.61
29.14
29.10
28.17
28.98
28.93
28.77
29.04
29.27
29.13
28.94
29.41
29.32
173+00
173+50
174+00
174+50
175+00
175+50
176+00
176+50
177+00
177+50
178+00
178+50
179+00
179+50
180+00
180+50
181+00
181+50
182+00
182+50

DIRECTIONAL DRILL PROFILE
DISCHARGE CANAL

STA. 173+00 TO STA. 182+50

SCALE
1"=40'

RECOED DRAWING

REV. NO.	DESCRIPTION	DATE

REVISIONS

PROJECT MANAGER TCH	DRAWING SCALE 1" = 40'
DRAWN BY VAR	PROJECT DATE MARCH 2007
APPROVED BY TCH	PROJECT NUMBER 60120.00.WL
FILE NAME	PLOT DATE 1/24/2011

WK DICKSON
community infrastructure consultants

909 MARKET STREET
WILMINGTON, NC 28401
(910) 762-4200

Office Locations: North Carolina
South Carolina
Georgia
NC LICENSE NO. F-0374

RELEASED FOR	DATE
APPROVALS	
BIDDING	
CONSTRUCTION	
RECORD DWG.	

SEAL 024984
T. CARTER HUBARD

24 JAN 11

CITY OF SOUTHPORT
TRANSMISSION FACILITIES

HWY 211 FORCE MAIN
STA: 173+00 TO STA: 182+25

C16