


COPYRIGHT © W.K. DICKSON & CO., INC., ALL RIGHTS RESERVED. REPRODUCTION OR USE OF THE CONTENTS OF THIS DOCUMENT IN ANY FORM WITHOUT THE WRITTEN CONSENT OF W.K. DICKSON & CO. INC. IS PROHIBITED. ONLY COPIES FROM THE ORIGINAL OF THIS DOCUMENT, MARKED WITH AN ORIGINAL SIGNATURE AND SEAL, SHALL BE CONSIDERED TO BE VALID, TRUE COPIES.

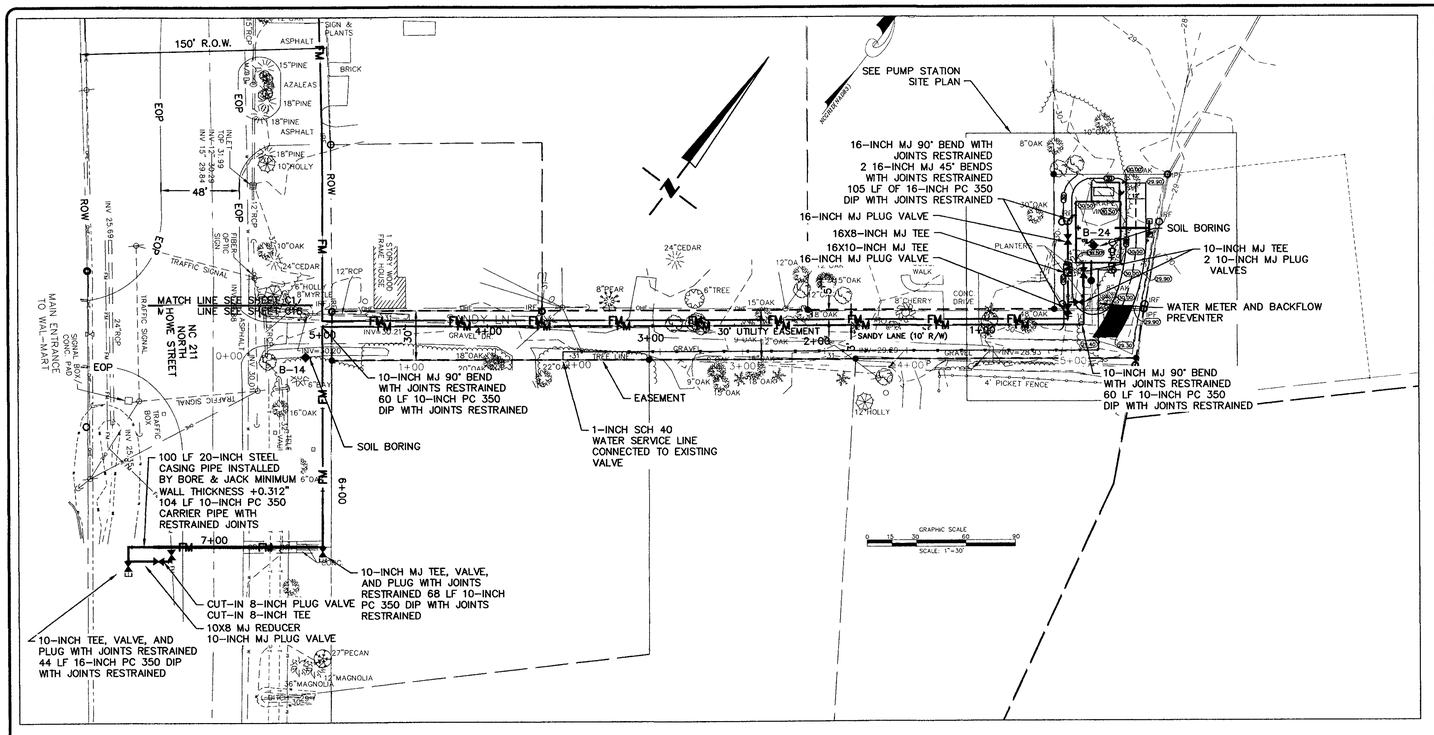

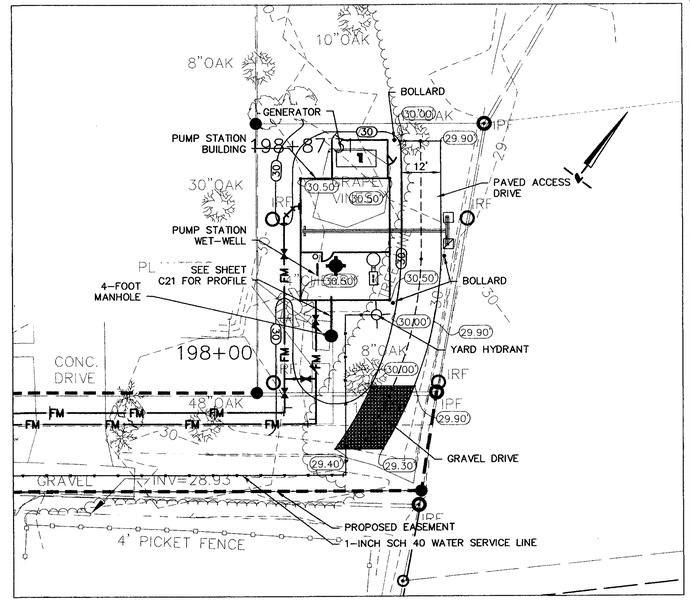

BLAKE PROPERTY PUMP STATION
SITE PLAN

GRAPHIC SCALE
40 0 20 40 80
(IN FEET)
SCALE: 1" = 40'

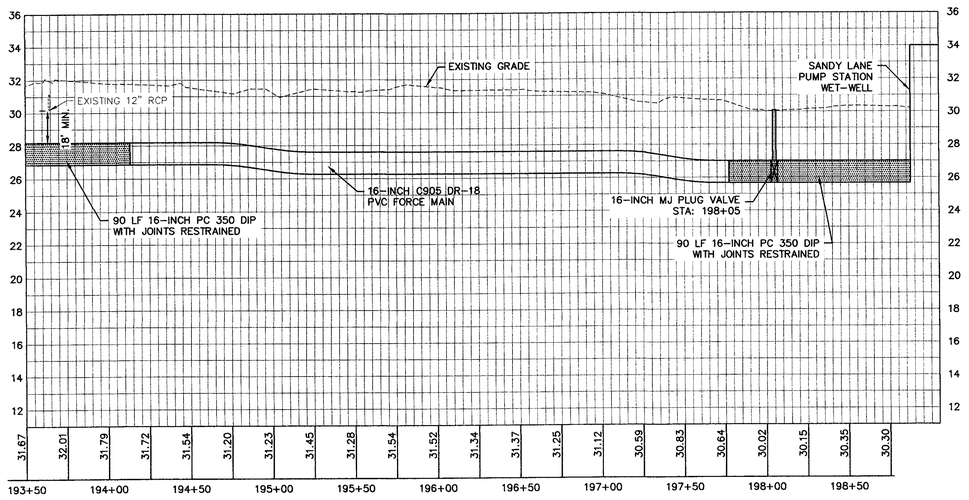

NOTES:

1. NO SURFACE WATERS WITHIN 30' OF PUMP STATION SITE. PROJECT SITE DRAINS TO CP&L DISCHARGE CANAL
2. NO WETLANDS EXIST ON SITE
3. 2,443 SF OF PROPOSED BUILT UPON AREA

RECORD DRAWING

L:\Projects\SOPOR\60120WL\CADD\LAND_60120_TRANSMISSION ROUTE\dwg\as-built drawings 12-21-2010\60120_C1-C18.dwg

REV. NO.	DESCRIPTION	DATE
	REVISIONS	

PROJECT MANAGER	TCH
DRAWN BY	VAR
APPROVED BY	TCH
FILE NAME	
DRAWING SCALE	1" = 40'
PROJECT DATE	FEB. 2007
PROJECT NUMBER	60120.00.WL
PLOT DATE	1/20/2011

WK DICKSON
community infrastructure consultants

909 MARKET STREET
WILMINGTON, NC 28401
(910) 762-4200

Office Locations: North Carolina
South Carolina
Georgia
NC LICENSE NO. F-0374

RELEASED FOR	DATE
APPROVALS	
BIDDING	
CONSTRUCTION	
RECORD DWG.	

NORTH CAROLINA PROFESSIONAL SEAL 024984 ENGINEER T. CARTER HUBBARD
21 JAN 11

CITY OF SOUTHPORT
TRANSMISSION FACILITIES

HWY 211 FORCE MAIN
STA: 193+50 TO STA: 198+74.02

C18